

KEY PLAN 1" = 10'- 0"

ABBREVIATIONS:	
APPROX.	APPROXIMATELY
A.T.	ARCH TOP
BLDG.	BUILDING
BLK.	BLOCK
BM.	BEAM
CLG.	CEILING
CLR.	CLEAR
CONC.	CONCRETE
C.M.U.	CONCRETE MASONRY UNIT
CONT.	CONTINUOUS
DBL.	DOUBLE
D.F.	DOUGLAS FIR
DIM.	DIMENSION
EA.	EACH
E.W.	EACH WAY
FX	FIXED GLASS
ELEC.	ELECTRICAL
EXT.	EXTERIOR
F.F.	FINISH FLOOR
FLR.	FLOOR
FLOUR.	FLUORESCENT
FTG.	FOOTING
GA.	GAUGE
GALV.	GALVANIZED
GYP. BD.	GYPSON BOARD
H.B.	HOSE BIB
HDR.	HEADER
HH	HEADER HEIGHT
HORIZ.	HORIZONTAL
HSS	HOLLOW STRUCTURAL SECTION
INSUL.	INSULATION
LAV	LAVATORY
MAX.	MAXIMUM
MFG	MANUFACTURING
MIN.	MINIMUM
MISC.	MISCELLANEOUS
N.T.S.	NOT TO SCALE
O.C.	ON CENTER
o/	OVER
PLT.	PLATE
PR.	PAIR
RAD.	RADIUS
REINF.	REINFORCED
REQ'D	REQUIRED
S&P	SHELF AND POLE
SPEC.	SPECIFICATION
SQ.	SQUARE
sq ft. sf	SQUARE FEET
S.C.	SOLID CORE
STD.	STANDARD
SH	SINGLE HUNG
T&G	TONGUE AND GROOVE
T.S.	TUBE STEEL
TYP.	TYPICAL
U.O.N.	UNLESS OTHERWISE NOTED
VERT.	VERTICAL
W.H.	WATER HEATER
w/	WITH
W.W.M.	WELDED WIRE MESH
XO	HORIZONTAL SLIDER
(E)	EXISTING
(N)	NEW
(P)	PROPOSED

- 2 **APPLICABLE CODES:**
- 2022 California Administrative Code
 - 2022 California Building Code (CBC)
 - 2022 California Electrical Code
 - 2022 California Mechanical Code
 - 2022 California Plumbing Code
 - 2022 California Energy Code
 - 2022 California Historical Building Code
 - 2022 California Fire Code
 - 2022 California Existing Building Code
 - 2022 California Green Building Standards Code
 - 2022 California Reference Standards Code

2 **CODE ANALYSIS**

- SUMMARY**
- CONSTRUCTION TYPE: V-N, V-B, S1
 - EXISTING BUILDING: NON-SEPARATED OCCUPANCY, ONE-STORY, NON-COMBUSTIBLE CONSTRUCTION
 - FIRE PROTECTION: AUTOMATIC SPRINKLER SYSTEM THROUGHOUT
- USE AND OCCUPANCY**
- OCCUPANCY CLASSIFICATION: AMBULATORY CARE "URGENT CARE" (GROUP B)
 - OVERNIGHT STAY: NOT PERMITTED
- BUILDING CHARACTERISTICS**
- BUILDING HEIGHT: 21'-6"
 - NUMBER OF STORIES: ONE
 - TOTAL AREA: 15,300 SF
- OCCUPANT LOAD & EGRESS**
- OCCUPANT LOAD: 251 OCCUPANTS
 - NUMBER OF EXITS: 7

- 5 **EXISTING PARKING**
- TOTAL SPACES ON SITE: 20
 - ACCESSIBLE SPACES: 6
 - VAN-ACCESSIBLE SPACES: 1
 - ELECTRIC VEHICLE CHARGING STATIONS: 5

- AREA ANALYSIS:**
- EXISTING BUILDING: 15,500 SQ. FT.
 - PROJECT AREAS:
 - ADMINISTRATION: 137 SQ. FT.
 - EXAM ROOMS: 258 SQ. FT.
 - RECEPTION AND RECEPTION OFFICE: 443 SQ. FT.
 - TOTAL PROJECT AREA: 838 SQ. FT.

8 **FIRE SPRINKLERS:**

FIRE SPRINKLERS ARE A SEPARATE PERMIT. NEW EXAM ROOM WALL LOCATION WILL EFFECT COVERAGE.

FIRE SPRINKLER HEADS TO BE REPOSITIONED TO ACCOMMODATE THE WALL RELOCATION IN THE EXAM ROOMS. PERMIT WILL BE BY FIRE SPRINKLER CONTRACTOR



LEGAL DESCRIPTION	
ADDRESS:	115 E. NORTH ST. TAFT, CA.
SHORT LEGAL:	LM 2018-13 PAR A
LEGAL TYPE:	M
APN:	032-060-13
ATN:	03206013009

SHEET INDEX		
1	A-1	SITE PLAN
2	A-2	PROCEDURES & SPECIFICATIONS
3	A-3	DIMENSION PLANS
4	A-4	FLOOR PLANS
5	A-5	INTERIOR ELEVATIONS
6	CP-1	REFLECTED CEILING PLANS
7	S-1	LIGHT GUAGE STEEL DETAILS
8	EC.1	ENERGY COMPLIANCE
9	EC.2	ENERGY COMPLIANCE
10	E1.01	ELECTRICAL NOTES
11	E1.02	ELECTRICAL NOTES
12	E2.0	OVERALL ELECTRICAL PLAN
13	E3.0	PARTIAL ELECTRICAL PLANS
14	M1.0	MECHANICAL NOTES
15	M2.0	OVERALL MECHANICAL PLAN
16	M3.0	PARTIAL MECHANICAL PLANS
17	P1.0	PLUMBING NOTES
18	P2.0	OVERALL PLUMBING PLAN
19	P3.0	PARTIAL PLUMBING PLAN

- 3 **PROJECT ADJUSTED CONSTRUCTION COST:**
- c. AND d. The adjusted construction cost for this project is below the current valuation threshold of \$203,000.00.
- Compliance measures will be provided within the 20% cost limitation.

- 3 **POT - STATEMENT OF COMPLIANCE:**
- THE PATH OF TRAVEL (POT) IDENTIFIED IN THESE CONSTRUCTION DOCUMENTS IS COMPLIANT WITH THE CURRENT APPLICABLE CALIFORNIA BUILDING CODE ACCESSIBILITY PROVISIONS FOR "PATH OF TRAVEL REQUIREMENTS FOR ALTERATIONS, ADDITIONS AND STRUCTURAL REPAIRS".
- AS PART OF THE DESIGN OF THIS PROJECT, THE POT WAS EXAMINED TO DETERMINE COMPLIANCE WITH THESE REQUIREMENTS. ANY ELEMENTS, COMPONENTS OR PORTIONS OF THE POT THAT WERE DETERMINED TO BE NON-COMPLIANT 1) HAVE BEEN IDENTIFIED AND 2) THE CORRECTIVE WORK NECESSARY TO BRING THEM INTO COMPLIANCE HAS BEEN INCLUDED WITHIN THE SCOPE OF THIS PROJECT'S WORK THROUGH DETAILS, DRAWINGS AND SPECIFICATIONS INCORPORATED INTO THESE CONSTRUCTION DOCUMENTS. ANY NON-COMPLIANT ELEMENTS, COMPONENTS OR PORTIONS OF THE POT THAT WILL NOT BE CORRECTED BY THIS PROJECT BASED ON VALUATION THRESHOLD LIMITATIONS OR A FINDING OF UNREASONABLE HARDSHIP ARE SO INDICATED IN THESE CONSTRUCTION DOCUMENTS.
- DURING CONSTRUCTION, IF POT ITEMS REPRESENTED AS CODE COMPLIANT ARE FOUND TO BE NON-COMPLYING, THEY SHALL BE BROUGHT INTO COMPLIANCE WITH THE CBC AS A PART OF THIS PROJECT.

- PLAN REVIEW LEGEND**
- PLAN REVIEW CORRECTIONS:
PLAN CHECK NUMBER: 25032
PLAN CHECK DATE: 02/26/25
- # CORRECTION LIST NUMBER

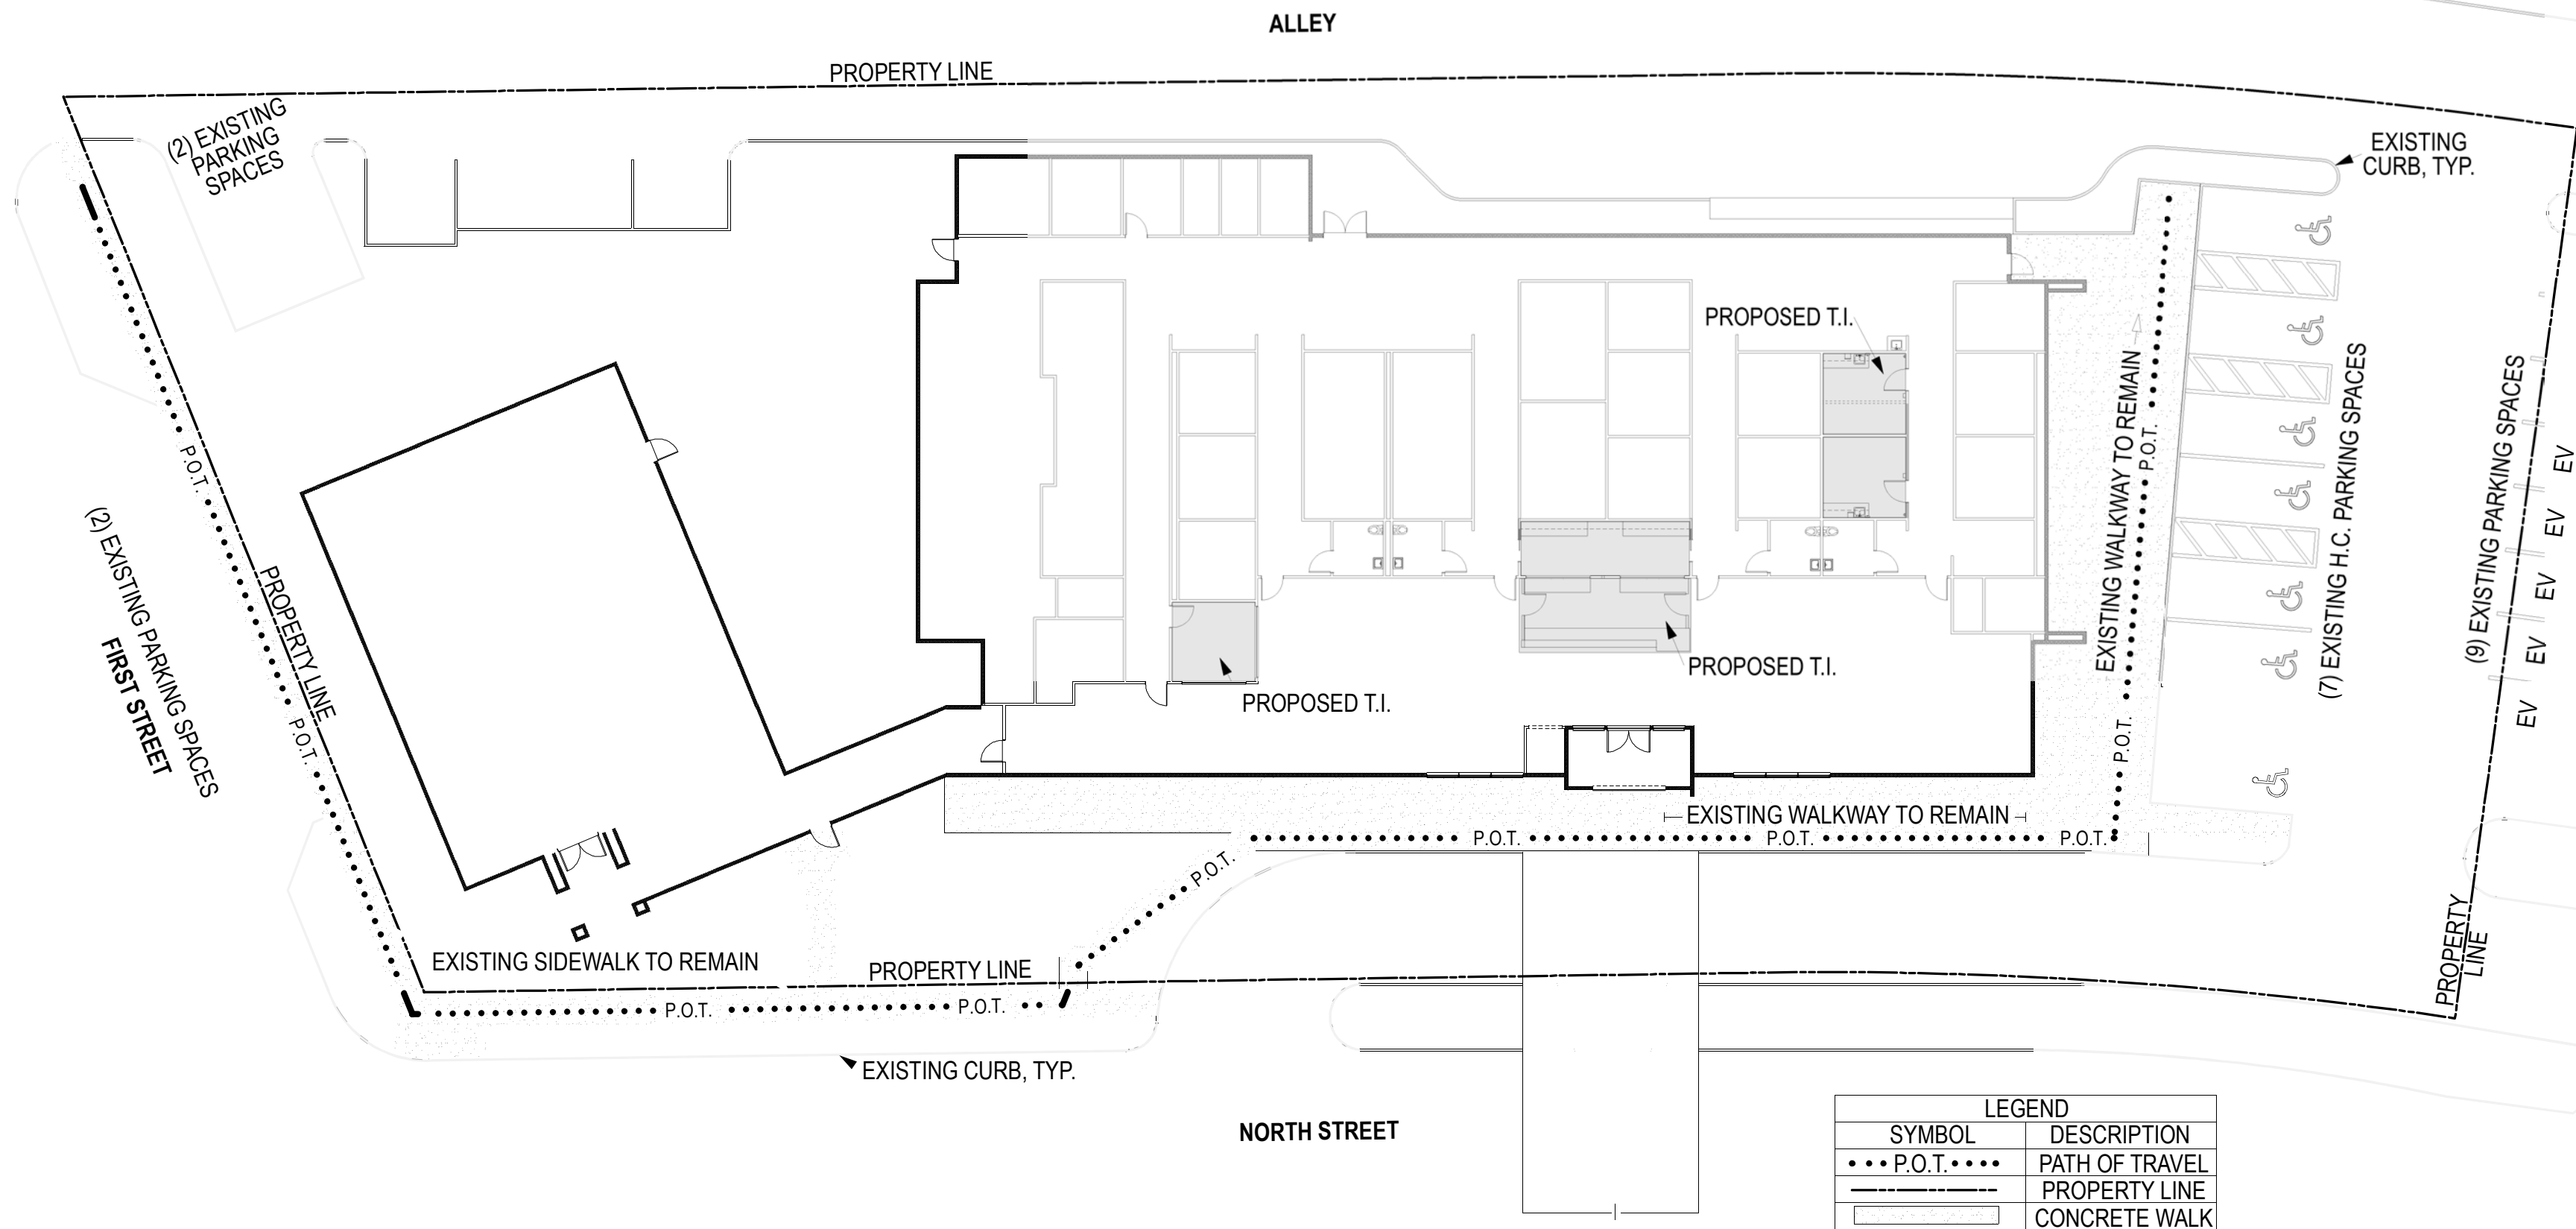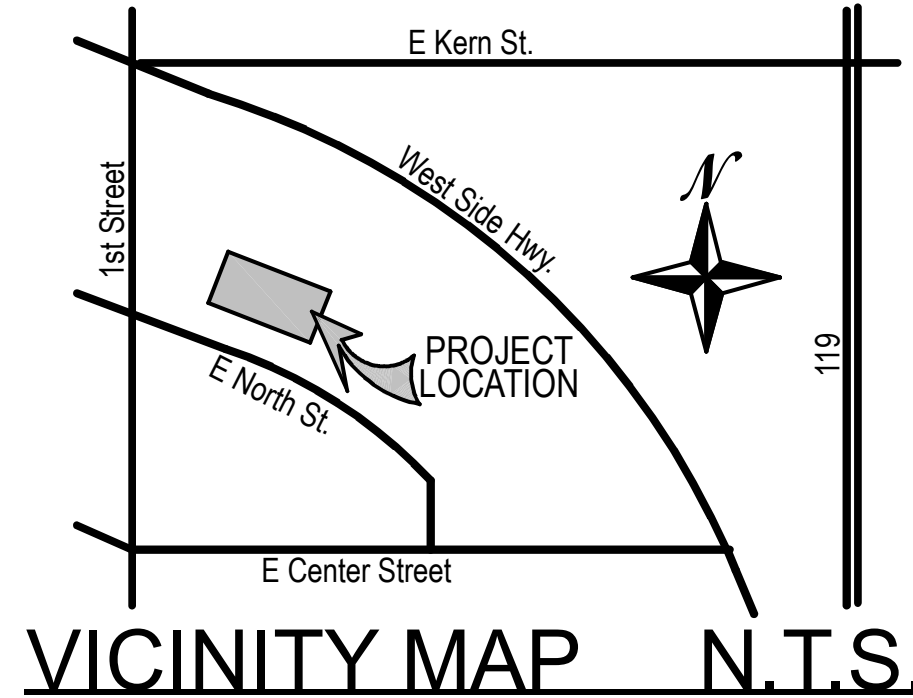

SITE PLAN 1" = 20'- 0"

REVISIONS

PROJECT CONTACT:
Ryan Shultz, MSHCA
Executive Director
(661) 765-7234 Office
(661) 203-5757 Cell
rshultz@wshcd.org

PROJECT ADDRESS:
Westside Health Care District
100 E. North Street
Taft, CA. 93268

MECHANICAL, ELECTRICAL & PLUMBING PLANS:
Cantelmi Engineering, Inc.
Frank Cantelmi, PE
2130 F St, Bakersfield, CA 93301
cantelmi@cantelmi.net (661) 324-5252

PRINCIPAL ENGINEER
Darren E. Strong, PE
STRONG
ENGINEERING & DESIGN
1400 Eaton Drive, Suite 208
Bakersfield, CA 93309
(805) 340-4300
dstrong@strong-engineering.com

SHEET
A-1
OF 20 SHEETS
DATE: 5/19/2025

PROCEDURES

PAINTING

1. Primers and undercoat paint shall be produced by the same manufacturer as a finish coat.
2. Metal shall be finished with one coat primer and two coats semi-gloss enamel.
3. Wood shall finished with one coat primer and two coats semi-gloss enamel.
4. Interior gypsum board shall be finished with one coat primer and two coats semi-gloss enamel, or per manufacturer's recommendations for complete coverage, typical throughout unless noted otherwise.
5. Furnish sufficient drop cloths, shields and protective equipment to prevent paint from fouling surfaces not being painted.
6. Remove electrical plates, surface hardware, fittings and fasteners prior to painting operations. Items not being replaced are to be stored, cleaned and re-installed on completion of work in each area.

INSTALLATION OF CARPET

- A. Install carpet with pile laid in the same direction.
- B. Carpet tiles shall be installed using only enough adhesive or double stick tape to properly align and retain carpet tiles. All tiles shall be glued down.
- C. Carpet to be securely attached to the floor in compliance with Americans with Disabilities Act (ADA), section 4.5.3.
- D. Proper layout and planning must be completed prior to any application of adhesive or carpet tile.
- E. Two working chalk lines must be applied to the floor to insure a straight, square properly aligned installation. These chalk lines intersect at the starting point and are exactly 90 degrees to each other.
- F. Carpet tiles are to be installed with a full spread of wet adhesive applied with a paint roller. Allow adhesive to fully dry so it does not transfer to a finger or module placed on it.
- G. Begin installation using a pyramid technique and aligning the first tile at the intersection of the two chalk lines.
- H. Always slide each module into position from the side to prevent trapped yarn. Set each module by firmly rubbing both joints.
- I. Modules should be tight but not compressed. Peaking will occur when modules are too tight. Too loose an installation can slip and create obvious gaps with use.
- J. Arrows are embossed and printed on the back of each module indicating pile direction. All arrows shall run in the same direction.
- K. A parallel or "scribe" cutting technique shall be used when cutting the modules.
- L. Cuts shall be done through the face of the module.
- M. Locate change of color or pattern between rooms under door centerline, unless noted otherwise on the Drawings.
- N. Bind cut edges where not concealed by edge strips.

INSTALLATION OF BASE

- A. Fit joints tight and vertical. Maintain minimum length of base should be 18 inches.
- B. Miter internal corners. At external corners, use factory-premolded units. At exposed ends, use factory-premolded units.
- C. Install base on solid backing. Bond tight to wall and floor surfaces.
- D. Scribe and fit to door frames and other interruptions.

SURFACE PROTECTION

- A. Protect installed carpet with kraft paper or polyethylene until removal of protective materials is directed
- B. Protect finished work adjacent to carpet being installed
- C. Prohibit traffic on floor finish for 24 hours after installation.

CLEANING

- A. Clean work area thoroughly
- B. Remove excess adhesive from floor, base and wall surfaces without damage.
- C. Clean and vacuum carpet surfaces.

CALIFORNIA GREEN CODE NOTES

CONSTRUCTION WASTE MANAGEMENT PLAN

1. Submit a construction waste management plan in conformance with Items 1 through 5. The construction waste management plan shall be updated as necessary and shall be available during construction for examination by the enforcing agency.

a. Identify the construction and demolition waste materials to be diverted from disposal by recycling, reuse on the project or salvage for future use or sale.

b. Specify if construction and demolition waste materials will be sorted on-site (source separated) or bulk mixed (single stream).

c. Identify diversion facilities where the construction and demolition waste material collected will be taken.

d. Identify construction methods employed to reduce the amount of construction and demolition waste generated.

e. Specify that the amount of construction and demolition waste materials diverted shall be calculated by weight or volume, but not by both.
2. Documentation shall be provided to the enforcing agency which demonstrates compliance with section 5.408.2, items 1 thru 4. The waste management plan shall be updated as necessary and shall be accessible during construction for examination by the enforcing agency.
3. provide readily accessible areas that serve the entire building and are identified for the depositing, storage and collection of non-hazardous materials for recycling, including (at a minimum) paper, corrugated cardboard, glass, plastics and metals.
4. The lighting and control systems shall be inspected and tested to ensure proper installation operation. tests shall include but are not limited to visual inspection of all fixtures to ensure conformance to specifications listed in the approved construction documents and manufacturer's recommended installation instructions.
- FINISH MATERIAL POLLUTANT CONTROL
1. Adhesives, Sealants and Caulks. Adhesives, sealant and caulks used on the project shall meet the requirements of the following standards unless more stringent local or regional air pollution or air quality management district rules apply:

a. Adhesives, adhesive bonding primers, adhesive primers, sealants, sealant primers and caulks shall comply with local or regional air pollution control or air quality management district rules where applicable or SCAQMD Rule 1168 VOC limits, as shown in Table 4.504.1 or 4.504.2, as applicable. Such products also shall comply with the Rule 1168 prohibition on the use of certain toxic compounds (chloroform, ethylene dichloride, methylene chloride, perchloroethylene and trichloroethylene), except for aerosol products, as specified in Subsection 2 below.

b. Aerosol adhesives, and smaller unit sizes of adhesives, and sealant or caulking compounds (in units of product, less packaging, which do not weigh more than 1 pound and do not consist of more than 16 fluid ounces) shall comply with statewide VOC standards and other requirements, including prohibitions on use of certain toxic compounds, of California Code of Regulations, Title 17, commencing with section 94507.

PAINTS AND COATINGS

1. Architectural paints and coatings shall comply with VOC limits in Table 1 of the ARB Architectural Suggested Control Measure, as shown in Table 4.504.3, unless more stringent local limits apply. The VOC content limit for coatings that do not meet the definitions for the specialty coatings categories listed in Table 4.504.3 shall be determined by classifying the coating as a Flat, Nonflat or Nonflat-High Gloss coating, based on its gloss, as defined in subsections 4.21, 4.36, and 4.37 of the 2007 California Air Resources Board, Suggested Control Measure, and the corresponding Flat, Nonflat or Nonflat-High Gloss VOC limit in Table 4.504.3 shall apply.
2. Aerosol Paints and Coatings. Aerosol paints and coatings shall meet the Product-weighted MIR Limits for ROC in Section 94522(a)(2) and other requirements, including prohibitions on use of certain toxic compounds and ozone depleting substances, in Sections 94522(e)(1) and (f)(1) of California Code of Regulations, Title 17, commencing with Section 94520; and in areas under the jurisdiction of the Bay Area Air Quality Management District additionally comply with the percent VOC by weight of product limits of Regulation 8, Rule 49. Verification of compliance with this section shall be provided at the request of the enforcing agency. Documentation may include, but is not limited to, the following:

a. Manufacturer's product specification.

b. Field verification of on-site product containers.

CARPET SYSTEMS

1. All carpet installed in the building interior shall meet the testing and product requirements of at least one of the following:

a. Carpet and Rug Institute's Green Label Plus Program.

b. California Department of Public Health, "Standard Method for the Testing and Evaluation of Volatile Organic Chemical Emissions from Indoor Sources Using Environmental Chambers" Version 1.1, February 2010 (also known as Specification 01350).

c. NSF/ANSI 140 at the Gold level.

d. Scientific Certifications Systems Indoor AdvantageTM Gold.
2. All carpet cushion installed in the building interior shall meet the requirements of the Carpet and Rug Institute's Green Label program.

SPECIFICATIONS

VERIFY BEFORE ORDERING. SUBSTITUTIONS SHALL BE EQUIVALENT AND APPROVED

GYPSUM BOARD

1. Gypsum board Shall be type III, grade R, class 1, unless noted otherwise.
2. Gypsum board joints and finish Shall be level 5.
3. Install gypsum board per requirements of "American standard specifications for the application and finishing of gypsum wallboard".

CARPET

Mohawk Drifted Ground Tile 12" x 36" or equivalent.

HARD SURFACE FLOORING:

Armstrong Flooring DecoArt Carlon Inlaid Commercial Sheet Flooring or equivalent.

BASE

Pinnacle Rubber Base 6" or equivalent.

WINDOW BLINDS

SelectBlinds Premier Double Cell Light Filtering Shade or equivalent.

HARDWARE

1. FURNISH FOR EACH ITEM ONLY THE PRODUCT OF A SINGLE MANUFACTURER.
2. Manufacturers for hardware items shall be as follows, or equal. Contractor shall submit a complete schedule of proposed manufacturers for approval by The City of Taft. Butts-"Stanley; Locks/cylinders/deadbolts-"Schlage; Closers-"Norton"; Thresholds-"Pemko"; Door stops-"Quality; Kick plates-"Quality; Signs-"ASI.
3. All "D" series lock and latch sets to be "RHODES" type

PAINT

1. Only materials (primers, paints, coatings, varnishes, stains, lacquers, fillers, etc.) listed in the latest edition of the MPI Approved Product List (APL) are acceptable for use on this project. All such material shall be from a single manufacturer for each system used.

A. Manufacturers – Paint

1. Benjamin Moore.

2. Dunn-Edwards.

B. Manufacturers – Stain

1. Dunn-Edwards

2. Olympic

3. Sinclair

C. Manufacturers – Sealer

1. Thompson's

2. Sinclair

CABINETS

1. All Millwork shall comply with grade requirements of the woodwork Institute of California, "Manual of Millwork". Construction Shall be custom grade, flush overlay.

2. Contractor shall provide all materials, not specifically described but required, for a complete and proper installation.

3. Cabinetry shall be flush overlay construction with laminate plastic finish.

4. High pressure laminate plastic shall be as manufactured by "Wilsonart" or equal.

5. Semi exposed portions of Cabinetry Shall be melamine finish.

ADHESIVE VOC LIMIT	
ARCHITECTURAL APPLICATIONS	
Indoor carpet adhesives	50
Carpet pad adhesives	50
Drywall and panel adhesives	50
Cove Base adhesives	50
Multi-purpose construction adhesive	70
Other adhesives not specifically listed	50
Contact adhesive	80
Trim adhesive	250
SUBSTRATE SPECIFIC APPLICATIONS	
Metal to metal	30
Plastic foams	50
Porous material, except wood	50
Wood	30
Fiberglass	80
If an adhesive is used to bond dissimilar substrates together the adhesive with the highest VOC shall be allowed.	
COATINGS VOC LIMIT	
ARCHITECTURAL APPLICATIONS	
Flat coatings	50
Non-flat coatings	100
Non flat high gloss coatings	150
SPECIALITY COATINGS	
Primers, sealers and undercoaters	100
Shellacs:	
Clear	730
Opaque	550
Zinc rich primers	340

GENERAL NOTES

1. ALL WORK SHALL BE IN COMPLIANCE WITH ALL APPLICABLE CODES AND ORDINANCES.

2. VERIFY, AT SITE, ALL EXISTING CONDITIONS PRIOR TO CONSTRUCTION.

3. THE CONTRACTOR SHALL EXAMINE THE PROJECT AREA AND SHALL HAVE SATISFIED HIMSELF AS TO THE EXISTING CONDITIONS AND THE CONDITIONS UNDER WHICH HE WILL BE OBLIGED TO OPERATE, OR WILL IN ANY MANNER EFFECT THE WORK UNDER THE CONTRACT.

4. CONTRACTOR SHALL BE RESPONSIBLE FOR VERIFYING THAT ALL ELEMENTS OF THIS PROJECT WILL BE REPAIRED, REPAINTED, OR REPLACED TO NEW CONDITION WHETHER OR NOT SPECIFICALLY IDENTIFIED IN THESE PLANS IF DAMAGED, MISSING, DILAPIDATED, OR DETERIORATED.

5. THE CONTRACTOR SHALL INVESTIGATE EXISTING CONDITIONS TO ASCERTAIN WORK REQUIRED AND INCLUDE ALL NECESSARY PATCHING AND REFRESHING.

6. THE CONTRACTOR SHALL SUBMIT ACCURATE COLOR AND PATTERN SAMPLES FOR REVIEW BY THE CITY OF TAFT UNLESS THE PRECISE COLOR AND PATTERN IS SPECIFICALLY INDICATED ON THE DRAWINGS. ELECTRONIC SAMPLES ARE NOT ACCEPTABLE.

7. ALL NEW ITEMS PLACED ABOVE CEILING WITH IN PLENUM SPACE SHALL BE RATED AS NECESSARY FOR THAT INSTALLATION.


SHEET
A-2
OF 20 SHEETS
DATE: 5/19/2025


PROJECT CONTACT:
Ryan Shultz, MSHCA
Executive Director
(661) 765-7234 Office
(661) 203-5757 Cell
rshultz@wshcd.org


PROJECT ADDRESS:
Westside Health Care District
100 E. North Street
Taft, CA. 93268

MECHANICAL, ELECTRICAL & PLUMBING PLANS:
Cantelmi Engineering, Inc.
Frank Cantelmi, PE
2130 F St, Bakersfield, CA 93301
cantelmi@cantelmi.net (661) 324-5252


PRINCIPAL ENGINEER
Darren E. Strong, PE
STRONG
ENGINEERING & DESIGN
Commercial - Industrial - Residential
1400 Eaton Drive, Suite 228
Bakersfield, CA 93309
661.340.4300
strong@strong-engineering.com

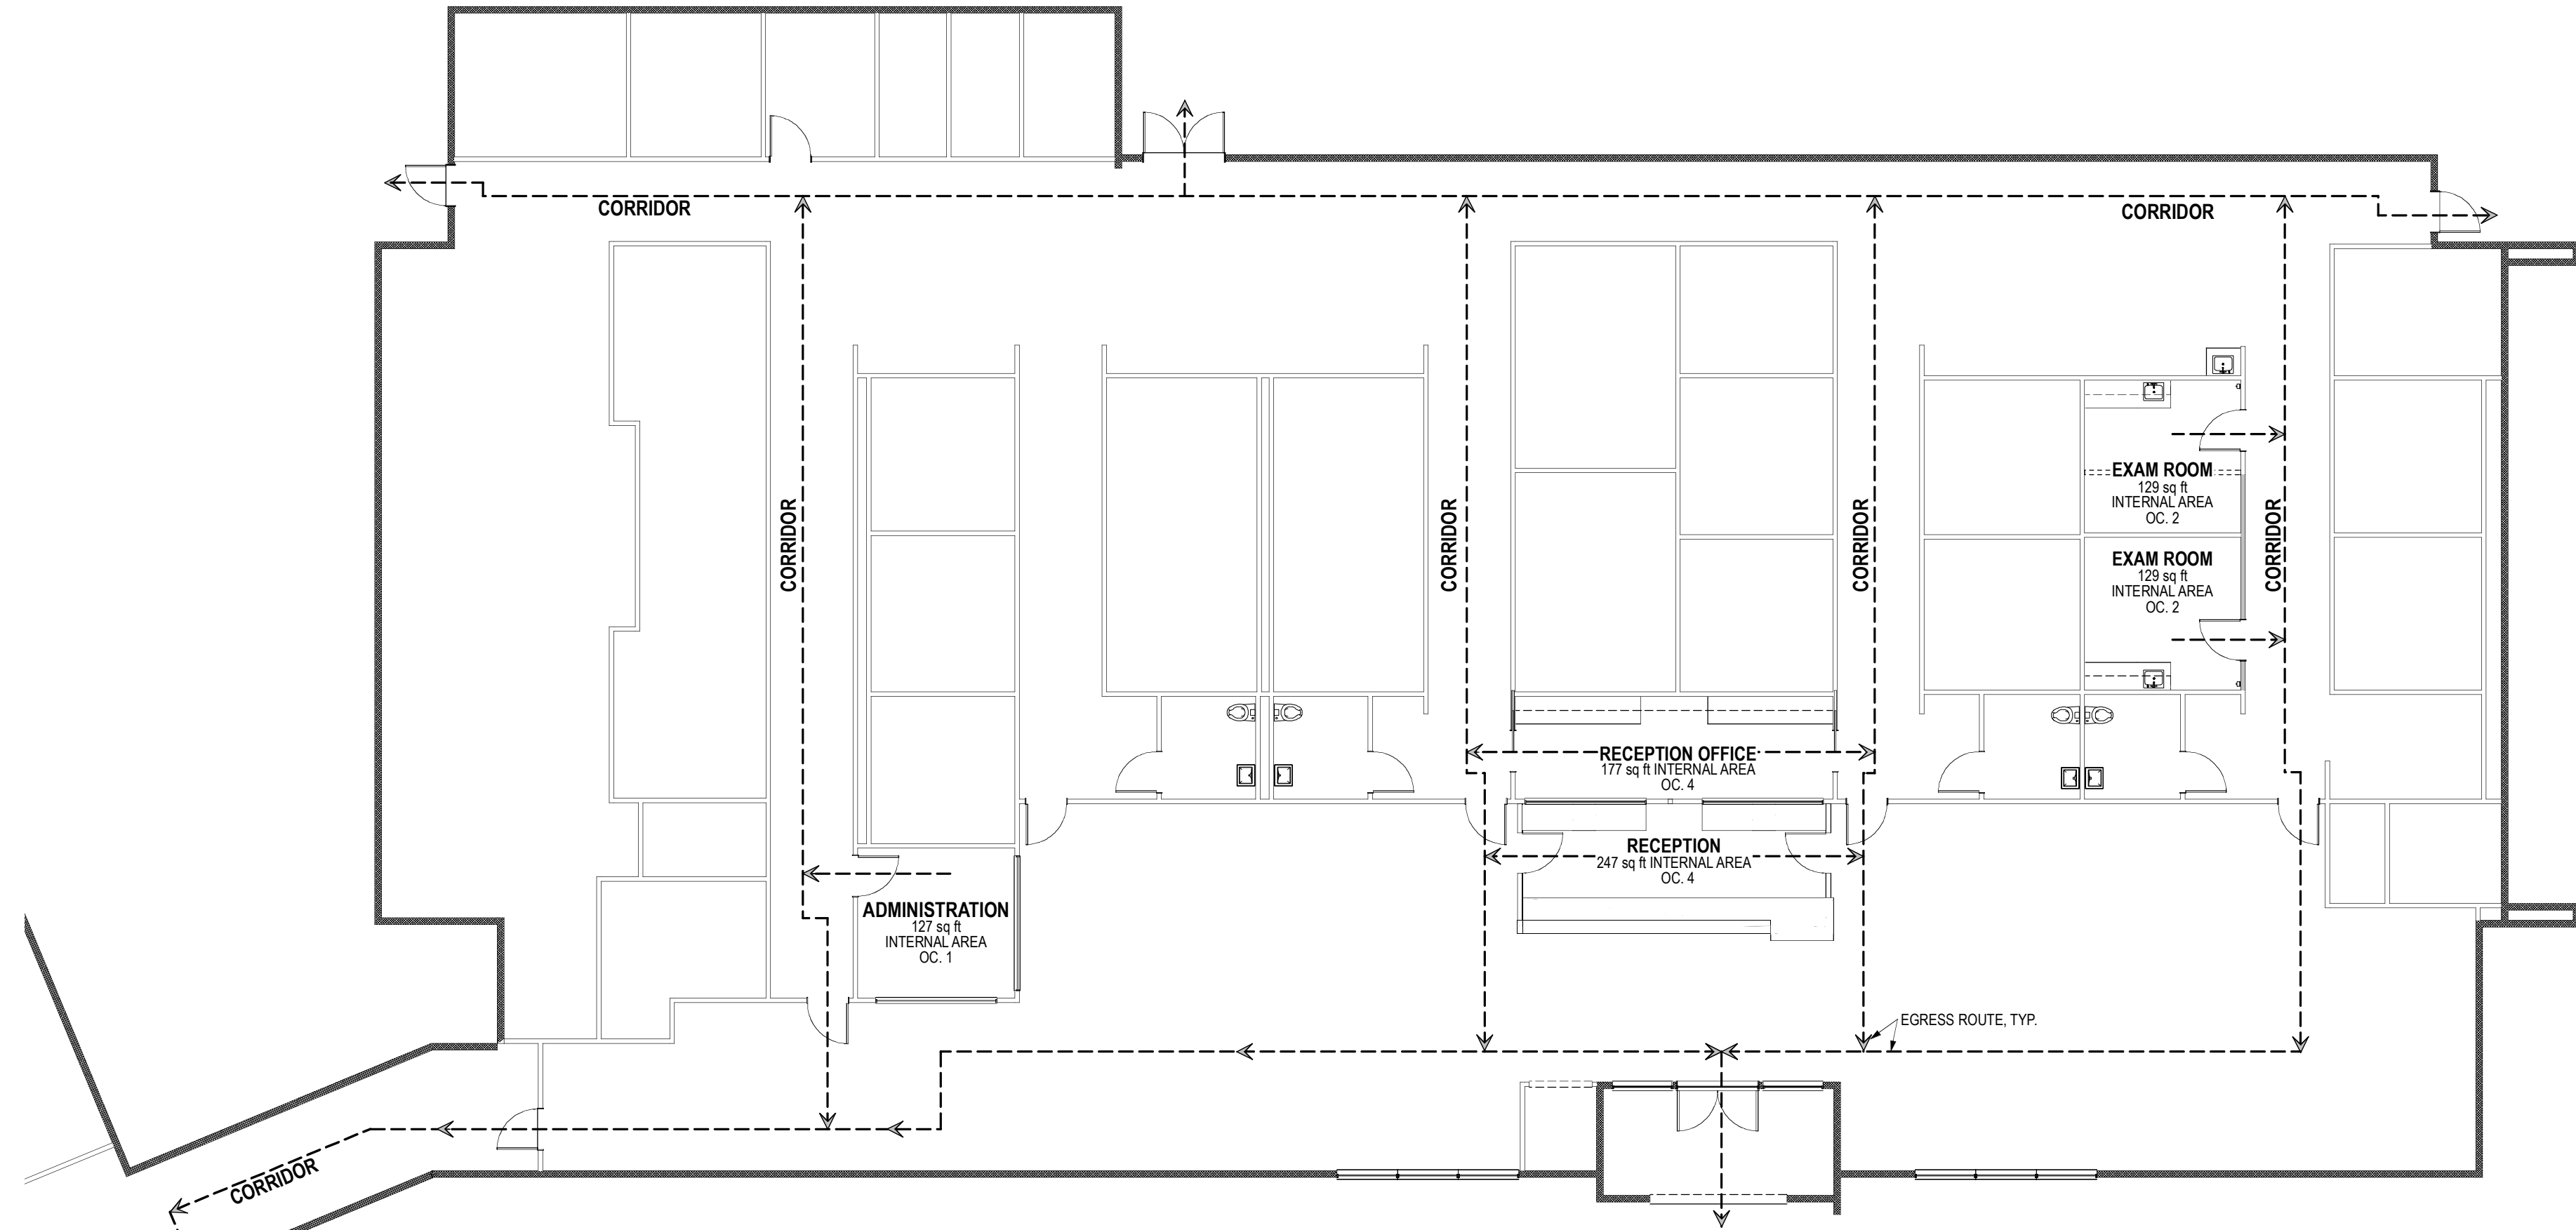

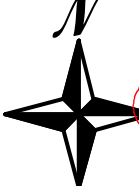
 **EGRESS PLAN** 1" = 10'- 0"
3
a. AND b.

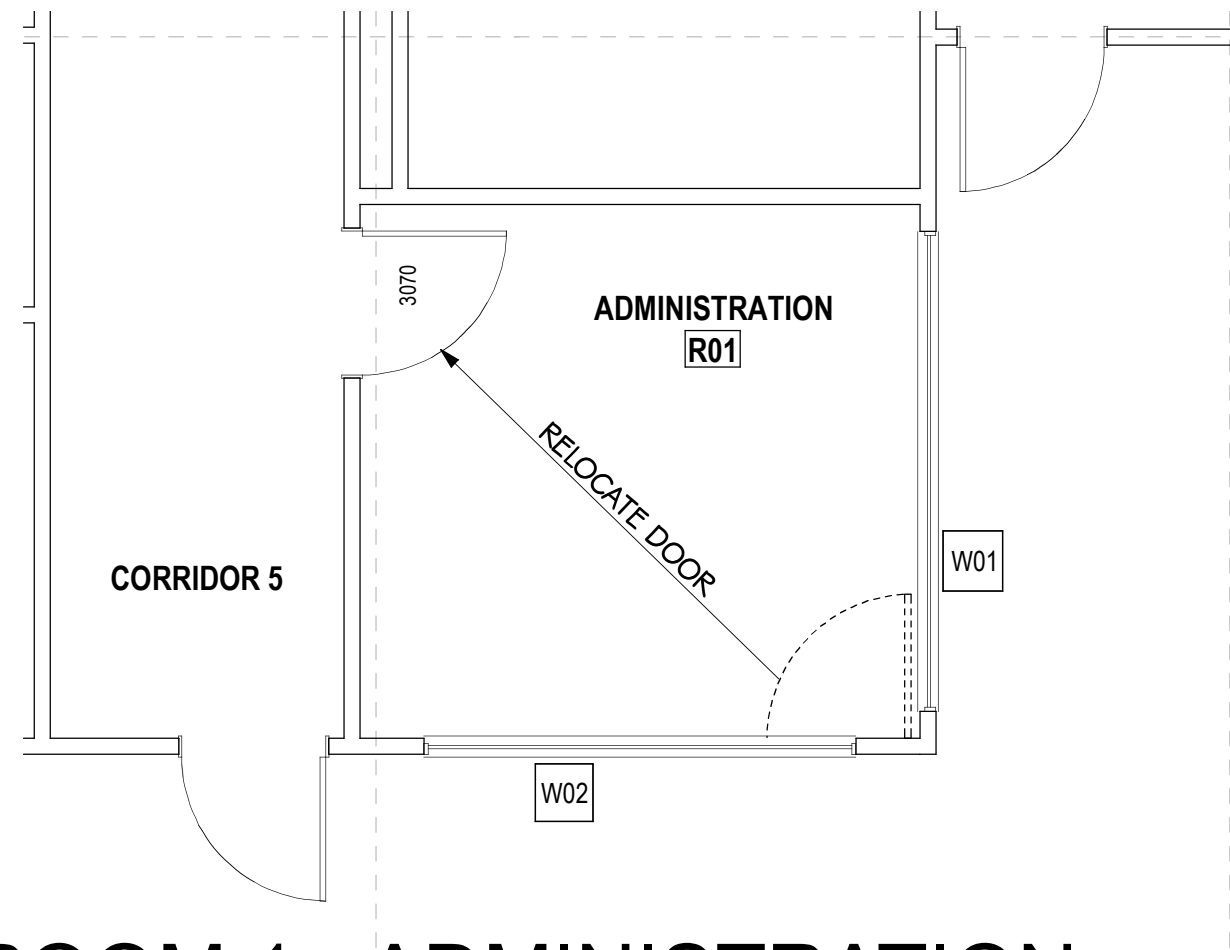

**ROOM 1 - ADMINISTRATION
REMODEL**

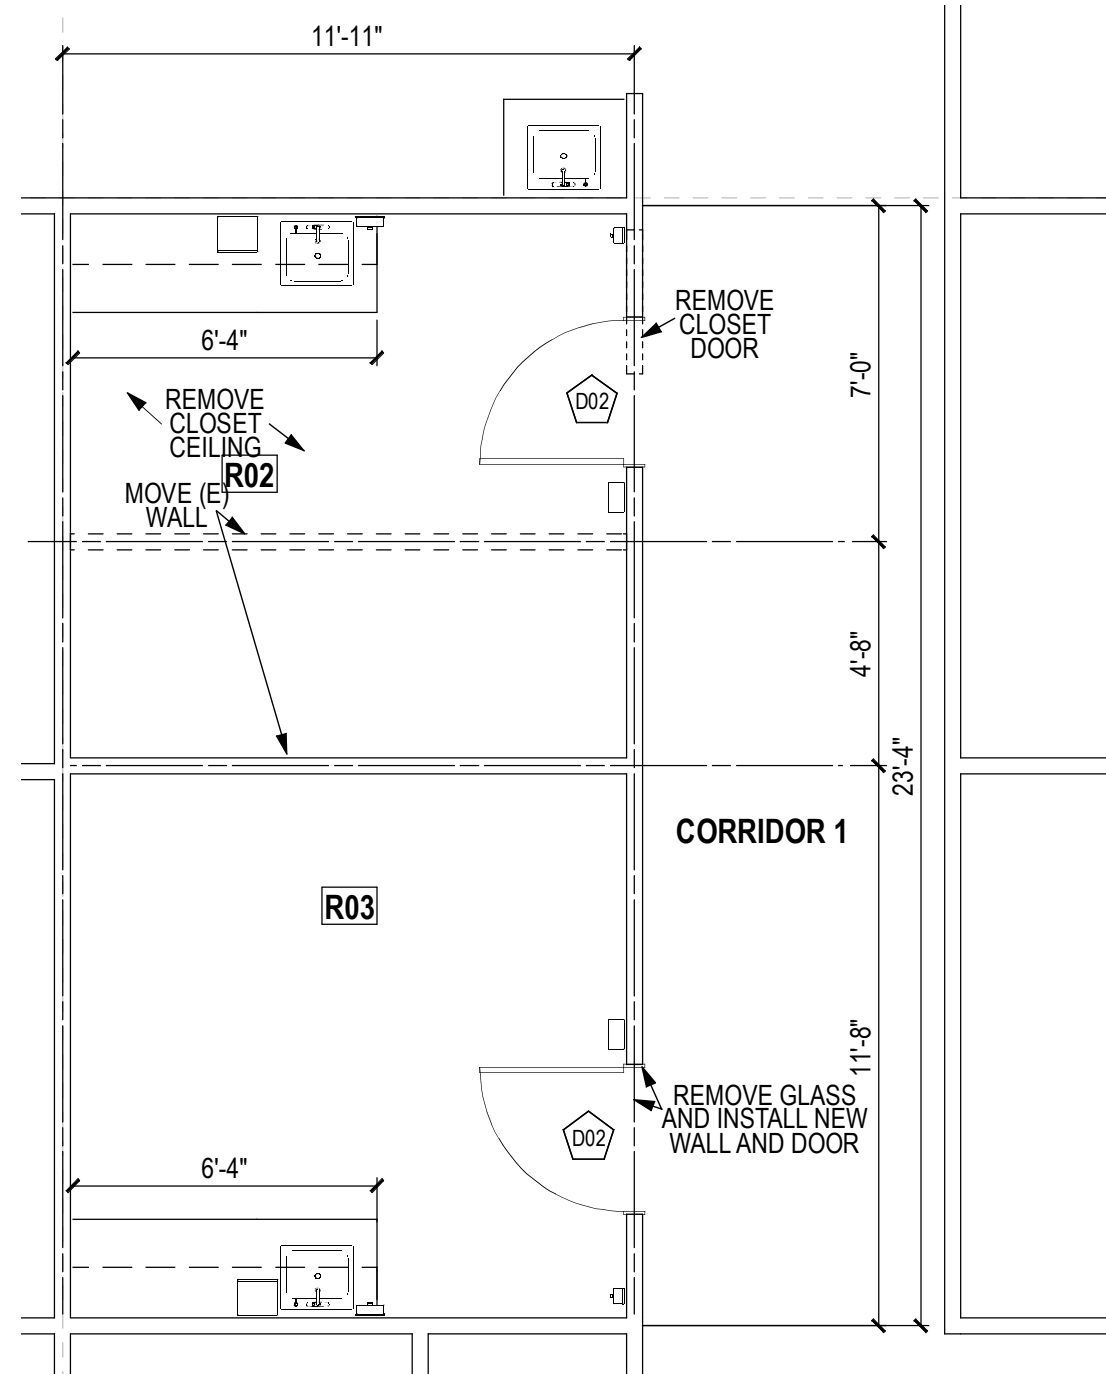


**ROOMS 2 & 3 - EXAM
CONVERT CLOSET AND
PROCEDURE TO (2) EXAM ROOMS**

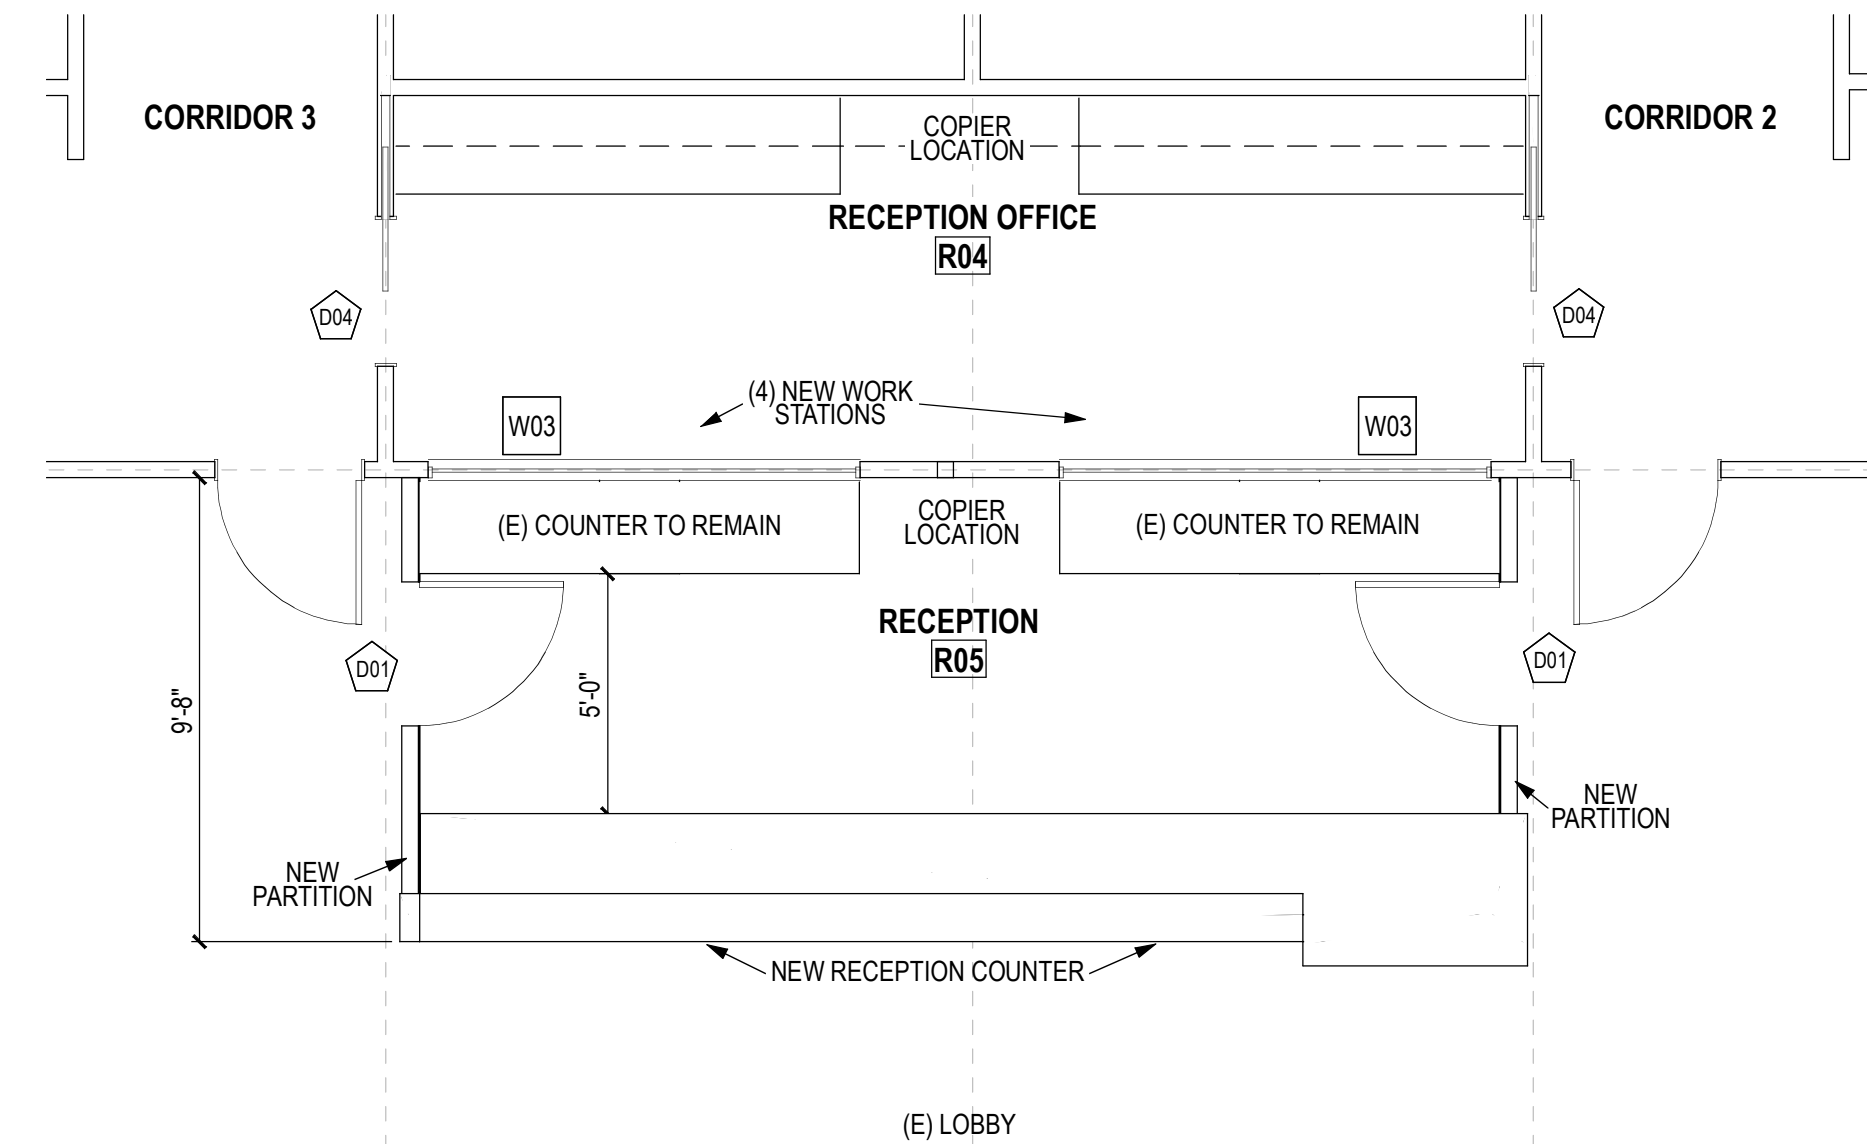

**ROOMS 4 & 5 - RECEPTION / OFFICE
REMODEL**

WINDOW SCHEDULE					
NUMBER	QTY	SIZE	TEMP.	DESCRIPTION	COMMENTS
W01	1	10090	Yes	(N) Fixed Glass	ONE-WAY VIEW TO LOBBY
W02	1	9020	Yes	(N) Fixed Glass	
W03	2	9036	Yes	(N) Fixed Glass	

WALL SCHEDULE	
Symbol	Wall Type(s)
	(N) 4" Steel Stud Wall
	(E) Interior Wall to Remain
	(E) Exterior Wall to Remain


 **DIMENSION PLANS** 1/4" = 1'- 0"

REVISIONS

PROJECT CONTACT:
Ryan Shultz, MSHCA
Executive Director
(661) 765-7234 Office
(661) 203-5757 Cell
rshultz@wshcd.org



PROJECT ADDRESS:
Westside Health Care District
100 E. North Street
Taft, CA. 93268

MECHANICAL, ELECTRICAL & PLUMBING PLANS:
Cantelmi Engineering, Inc.
Frank Cantelmi, PE
2130 F St, Bakersfield, CA 93301
cantelmi@cantelmi.net (661) 324-5252


PRINCIPAL ENGINEER
Darren E. Strong, PE

ENGINEERING & DESIGN
Commercial, Industrial, Residential
1400 Eaton Drive, Suite 208
Bakersfield, CA 93309
(805) 340-4300
dstrong@strong-engineering.com

SHEET
A-3
OF 20 SHEETS
DATE: 5/19/2025

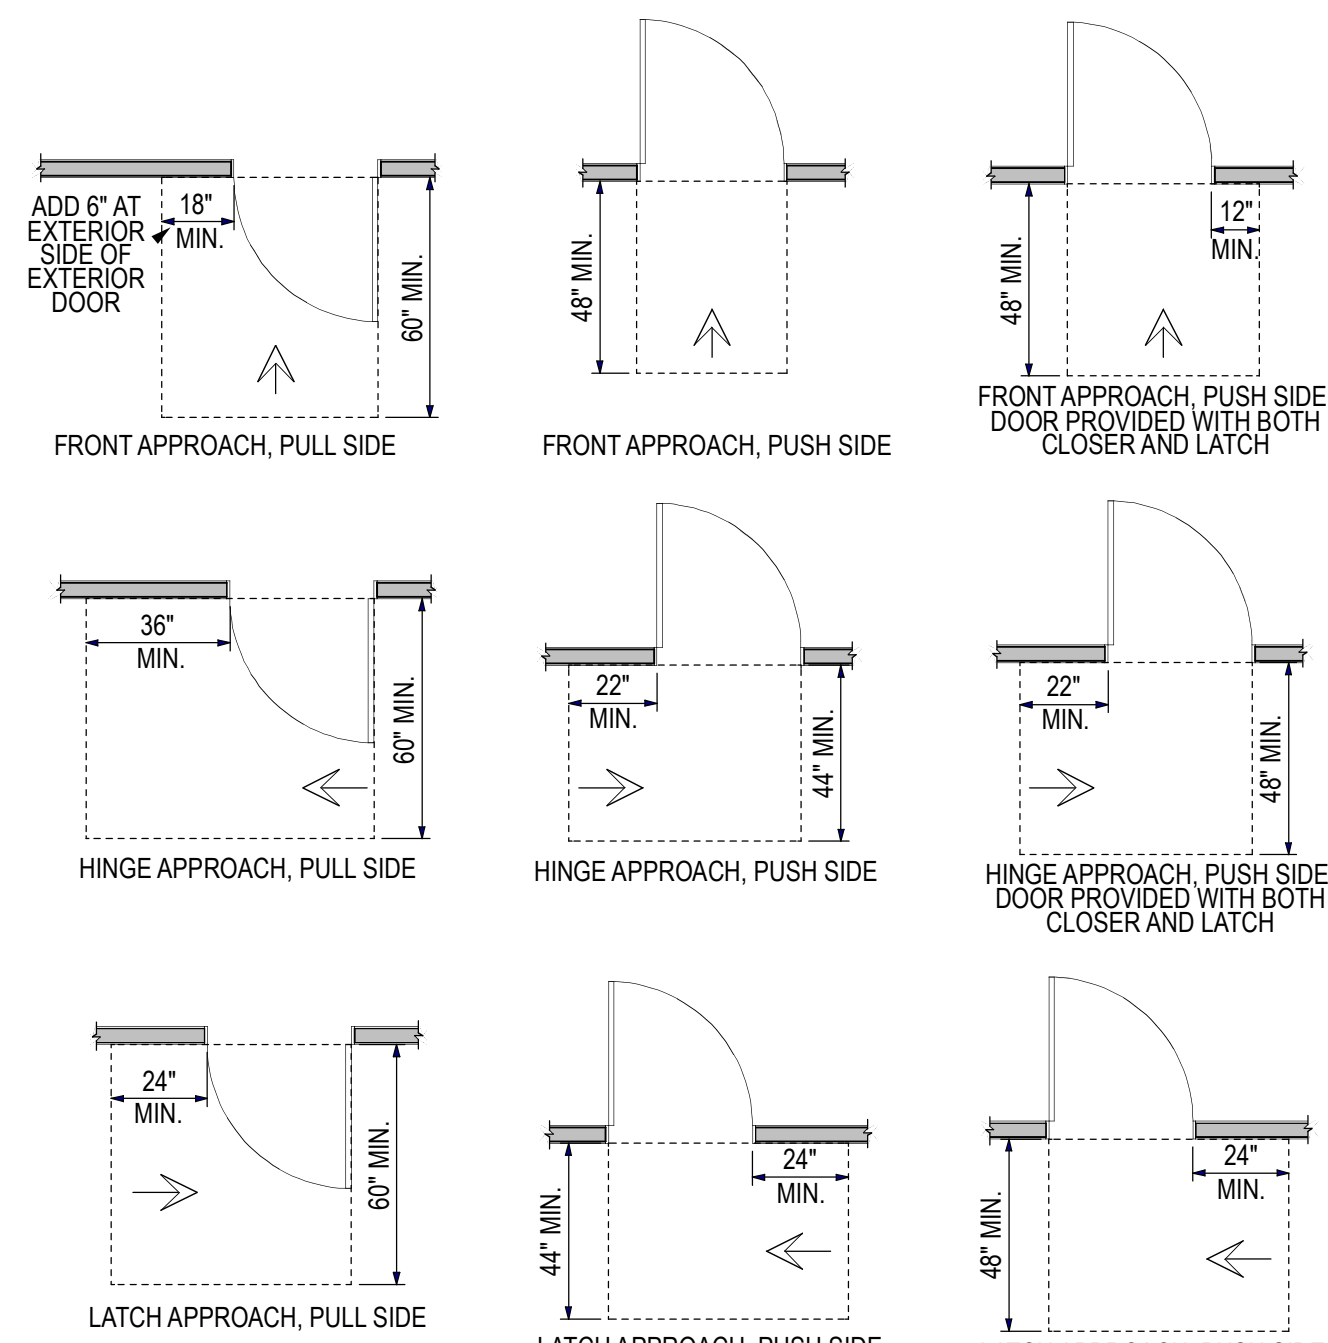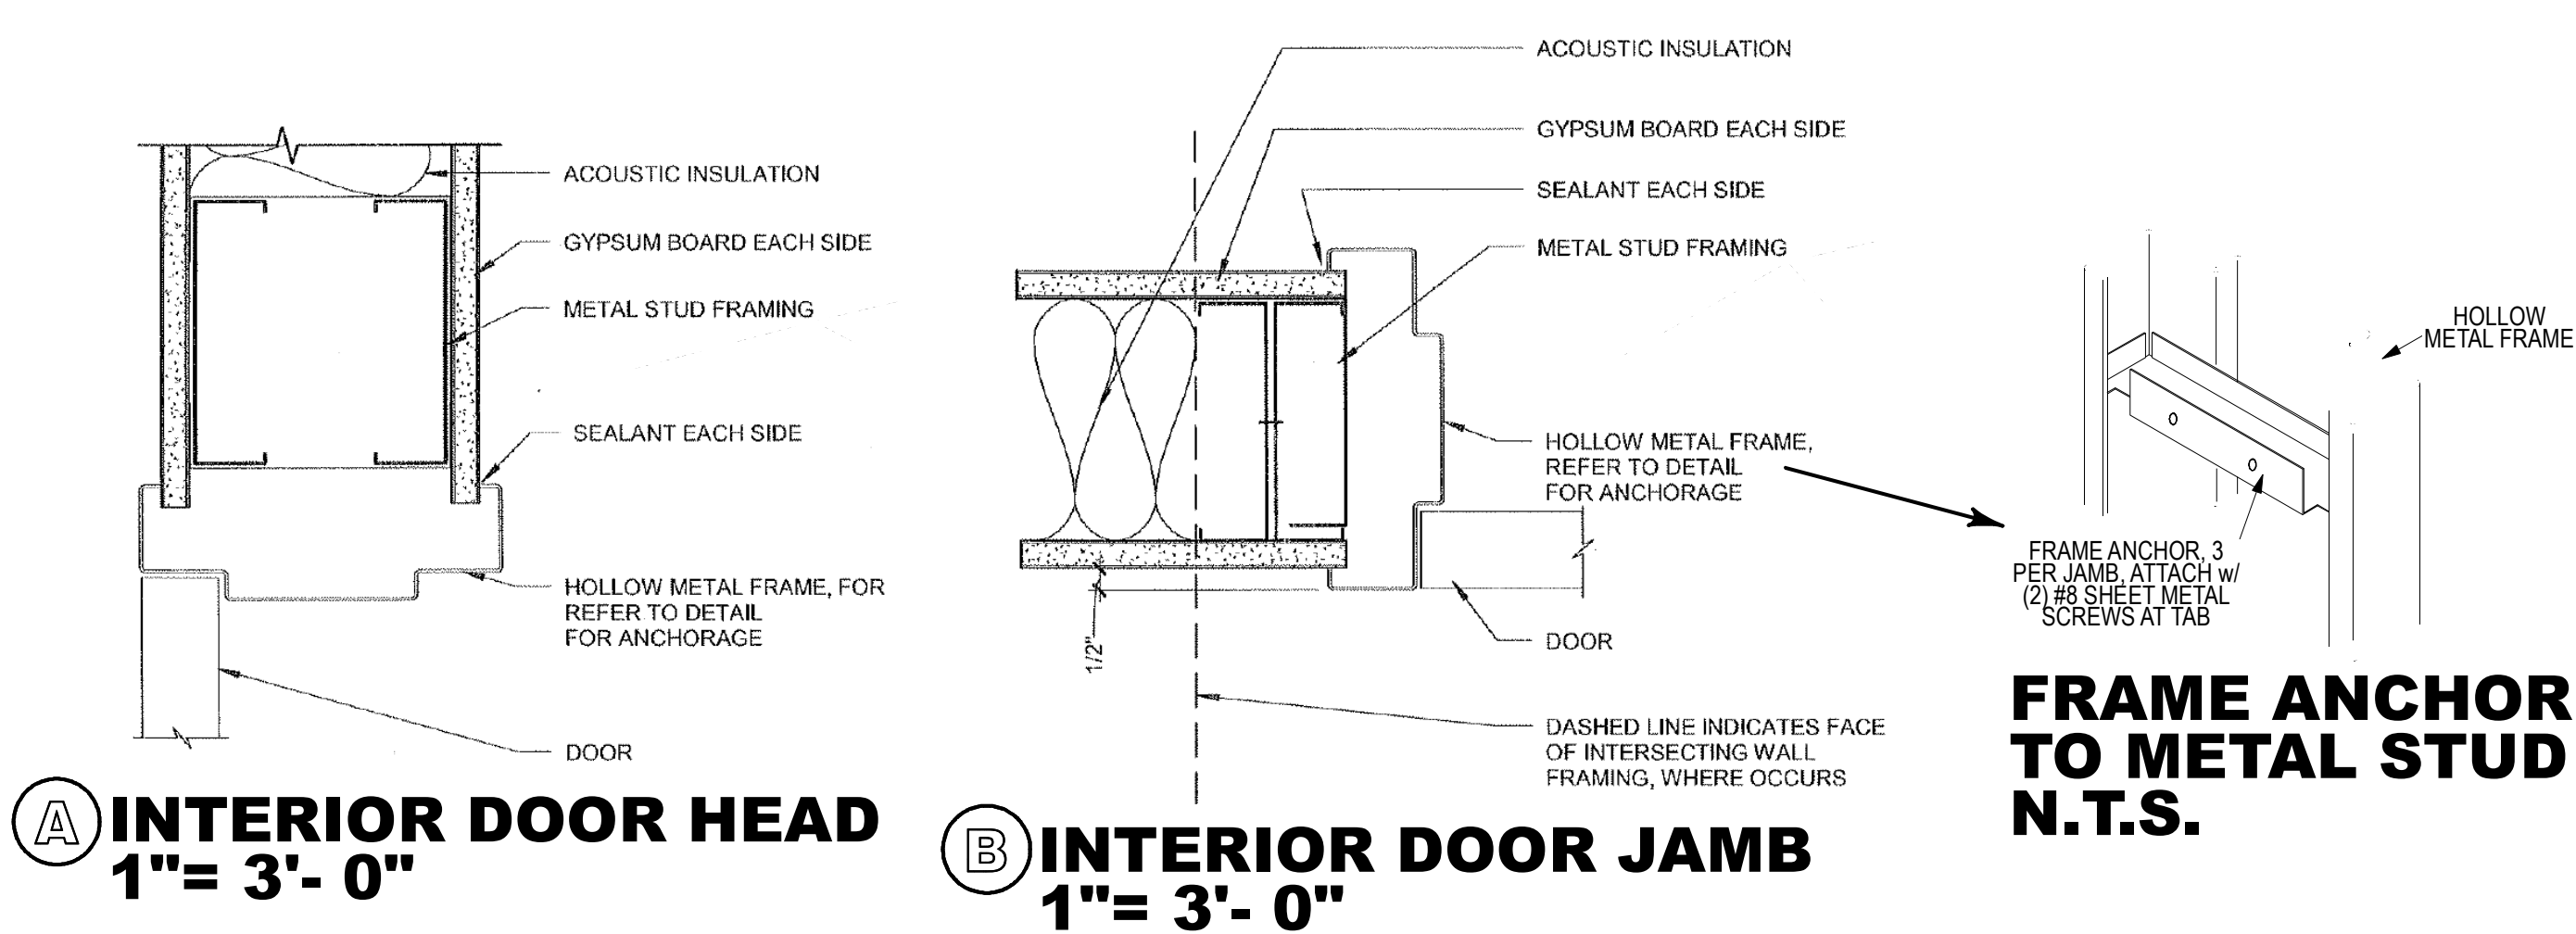

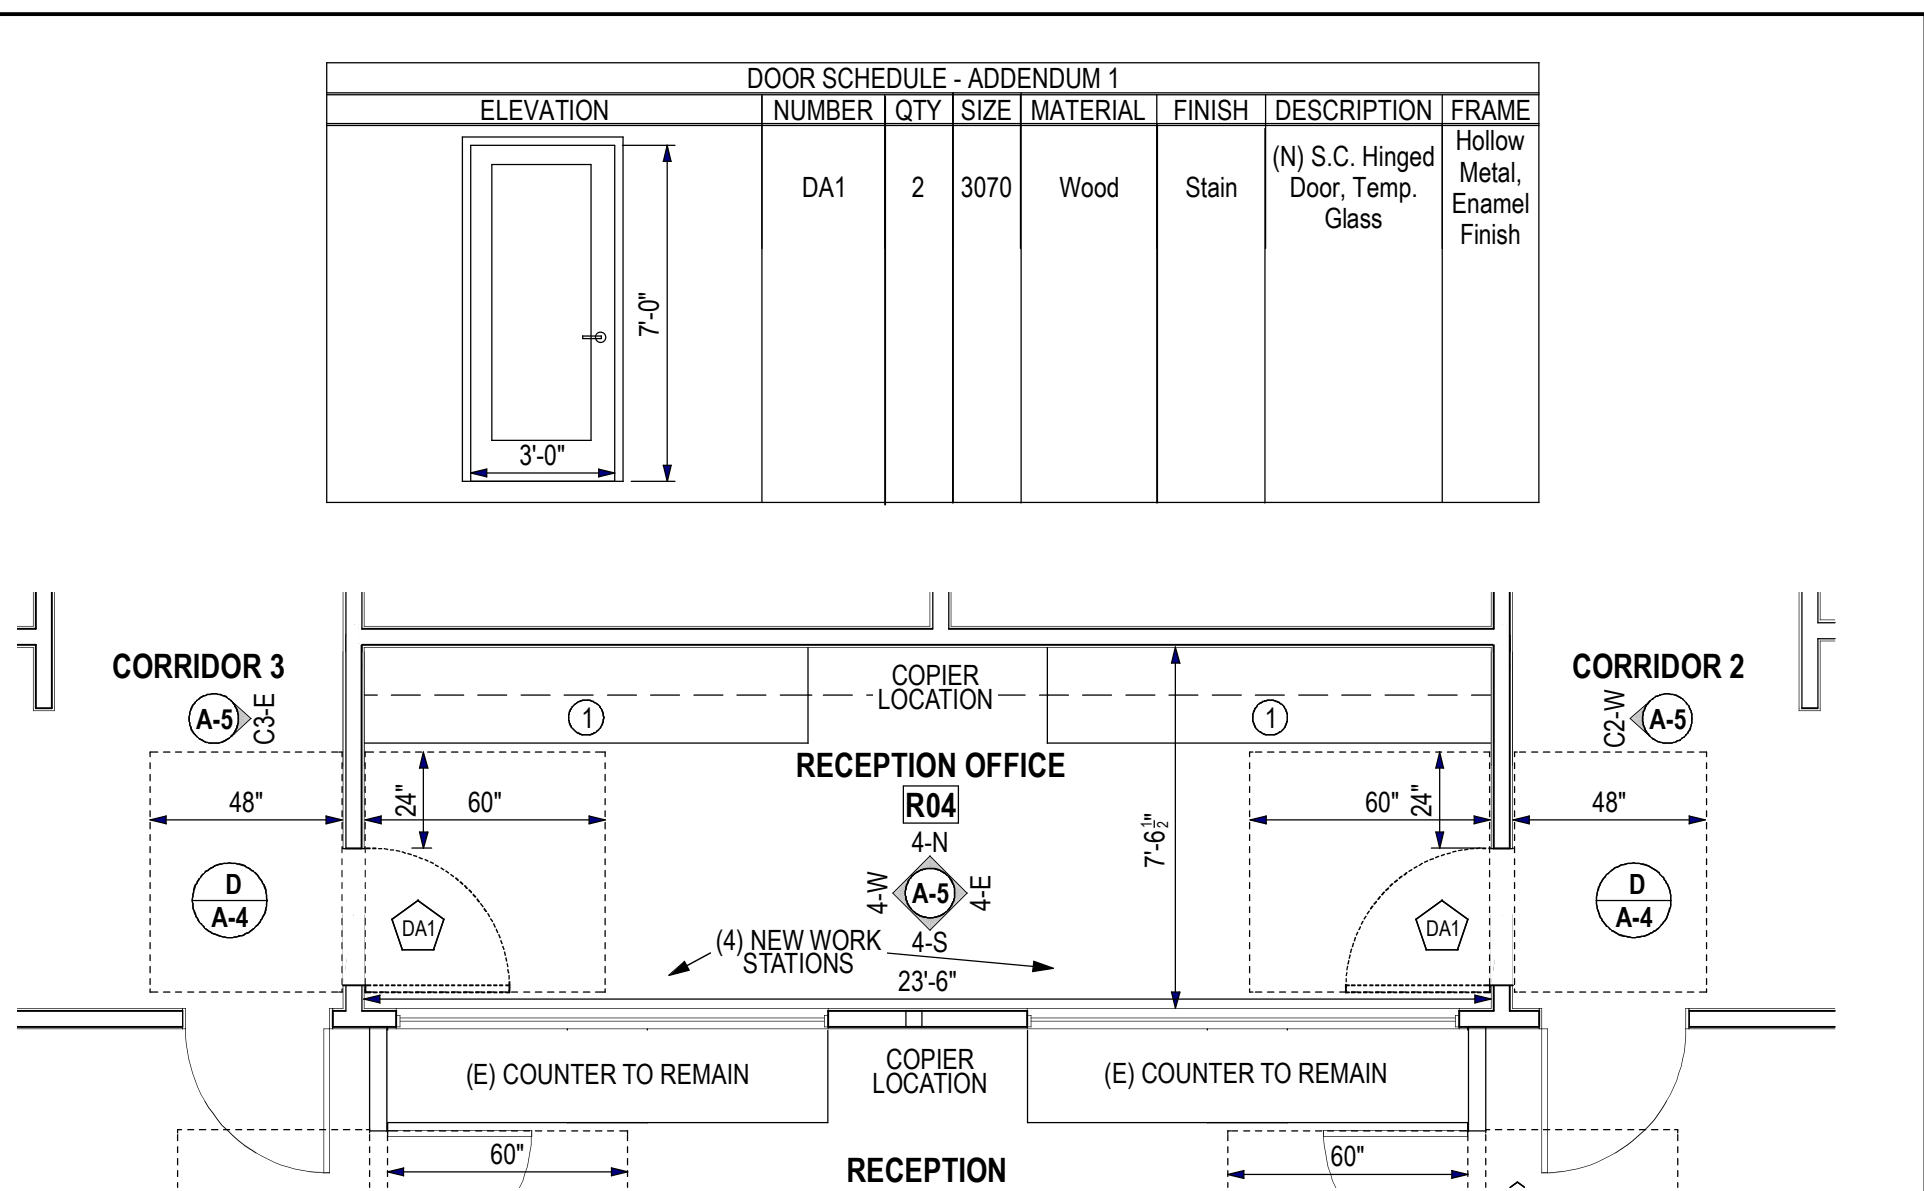


DOOR SCHEDULE						
ELEVATION	NUMBER	QTY	SIZE	MATERIAL	FINISH	DESCRIPTION
	D01	2	3039	Wood	Stain	(N) S.C. Hinged Door
	D02	2	3070	Wood	Stain	(N) S.C. Hinged Door
	D04	2	3070	Wood	Stain	(N) S.C. Pocket Door



ACCESSIBLE COUNTER

A PORTION OF THE COUNTER SURFACE THAT IS 36 INCHES LONG MINIMUM FOR A PARALLEL APPROACH OR 30 INCHES LONG MINIMUM FOR A FORWARD APPROACH AND 34 INCHES HIGH MAXIMUM ABOVE THE FINISH FLOOR SHALL BE PROVIDED. A 30 INCH BY 48 INCH CLEAR FLOOR SPACE ON AN ACCESSIBLE ROUTE MUST BE PROVIDED FOR EITHER A FORWARD OR PARALLEL APPROACH. ADDITIONALLY, IF A FORWARD APPROACH IS DESIRED, KNEE AND TOE SPACE MUST BE PROVIDED.

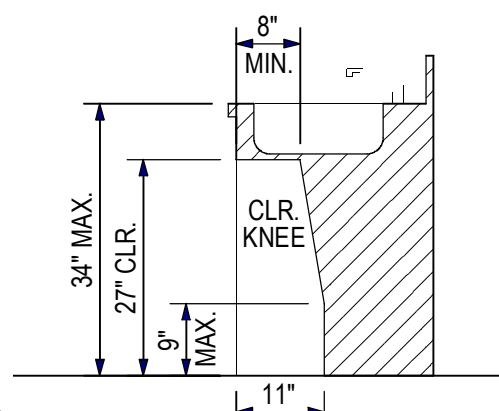

ACCESSIBLE SINK

MANEUVERING CLEARANCES AT MANUAL SWINGING DOORS AND GATES

11B-404.2.4.1 Swinging Doors and Gates
Swinging doors and gates shall have maneuvering clearances complying with Table 11B-404.2.4.1.

TYPE OF USE		MINIMUM MANEUVERING CLEARANCE	
Approach direction		Door or gate side	Perpendicular to doorway Parallel to doorway (beyond latch side unless noted)
From front	Pull	60 inches (1524 mm)	18 inches (457 mm)5
From front	Push	48 inches (1219 mm)	0 inches (0 mm)1
From hinge side	Pull	60 inches (1524 mm)	36 inches (914 mm)
From hinge side	Push	44 inches (1118 mm)2	22 inches (559 mm)3
From latch side	Pull	60 inches (1524 mm)	24 inches (610 mm)
From latch side	Push	44 inches (1118 mm)4	24 inches (610 mm)


1 Add 12 inches (305 mm) if closer and latch are provided.
2 Add 4 inches (102 mm) if closer and latch are provided.
3 Beyond hinge side.
4 Add 4 inches (102 mm) if closer is provided.
5 Add 6 inches (152 mm) at exterior side of exterior doors.

6 Doors:

- 11B-404.2.7 Door and Gate Hardware. Handles, pulls, latches, locks, and other operable parts on doors and gates shall comply with 11B-309.4 (Operation). Operable parts of such hardware shall be 34 inches minimum and 44 inches maximum above the finish floor or ground. Where sliding doors are in the fully open position, operating hardware shall be exposed and usable from both sides.
- 11B-404.2.8.1 Door closers and gate closers shall be adjusted so that from an open position of 90 degrees, the time required to move the door to a position of 12 degrees from the latch is 5 seconds minimum.
- 11B-404.2.9 Door and Gate Opening Force. The force for pushing or pulling open a door or gate shall be as follows: 1. Interior hinged doors and gates: 5 pounds maximum.
- 11B-404.2.10 Door and Gate Surfaces. Swinging door and gate surfaces within 10 inches of the finish floor or ground measured vertically shall have a smooth surface on the push side extending the full width of the door or gate. Parts creating horizontal or vertical joints in these surfaces shall be within 1/16 inch of the same plane as the other and be free of sharp or abrasive edges. Cavities created by added kick plates shall be capped.


ROOM 4 - RECEPTION OFFICE DOOR OPTION

ADDENDUM 1

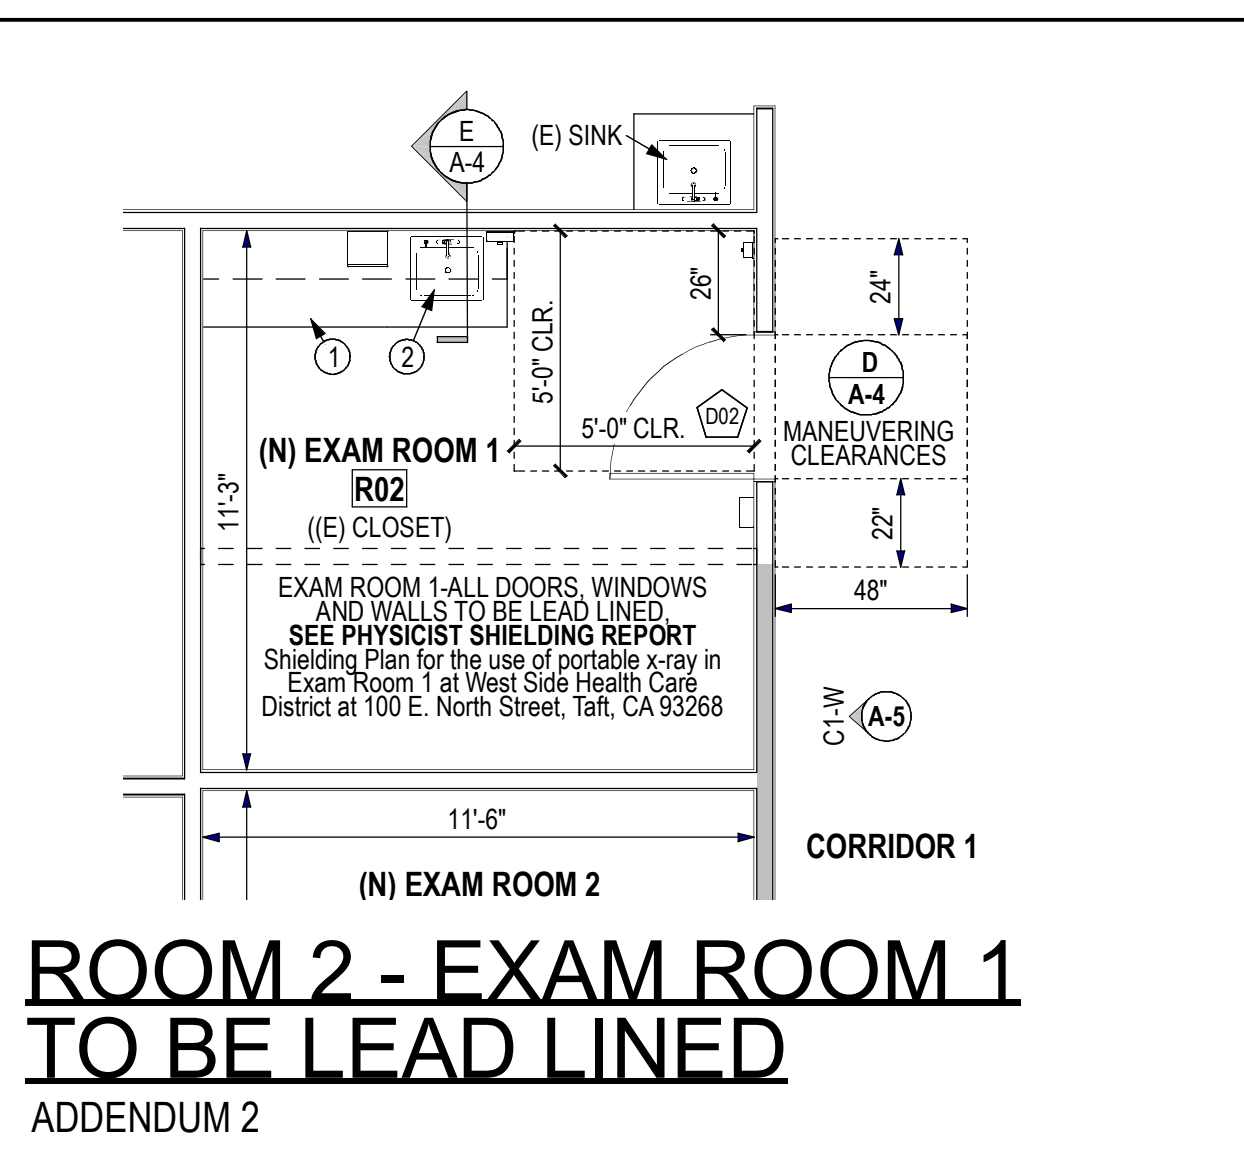


ROOM 2 - EXAM ROOM 1 TO BE LEAD LINED

ADDENDUM 2

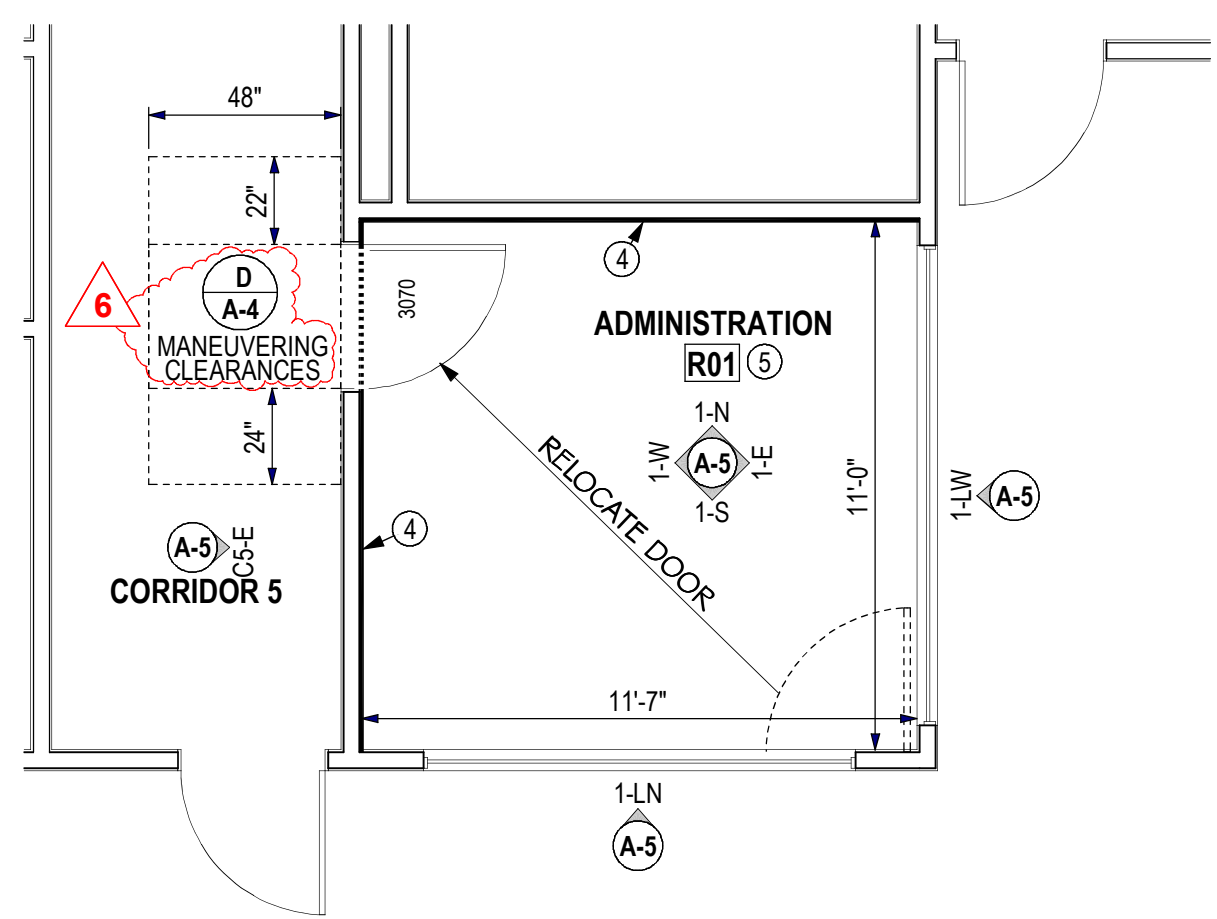


ROOM 1 - ADMINISTRATION REMODEL

FLOOR PLAN SCHEDULE	
1	(N) CABINETS
2	(N) SINK
4	SOUNDPROOF WALL, FLOOR TO ROOF
5	REMOVE AND REPLACE T-BAR CEILING

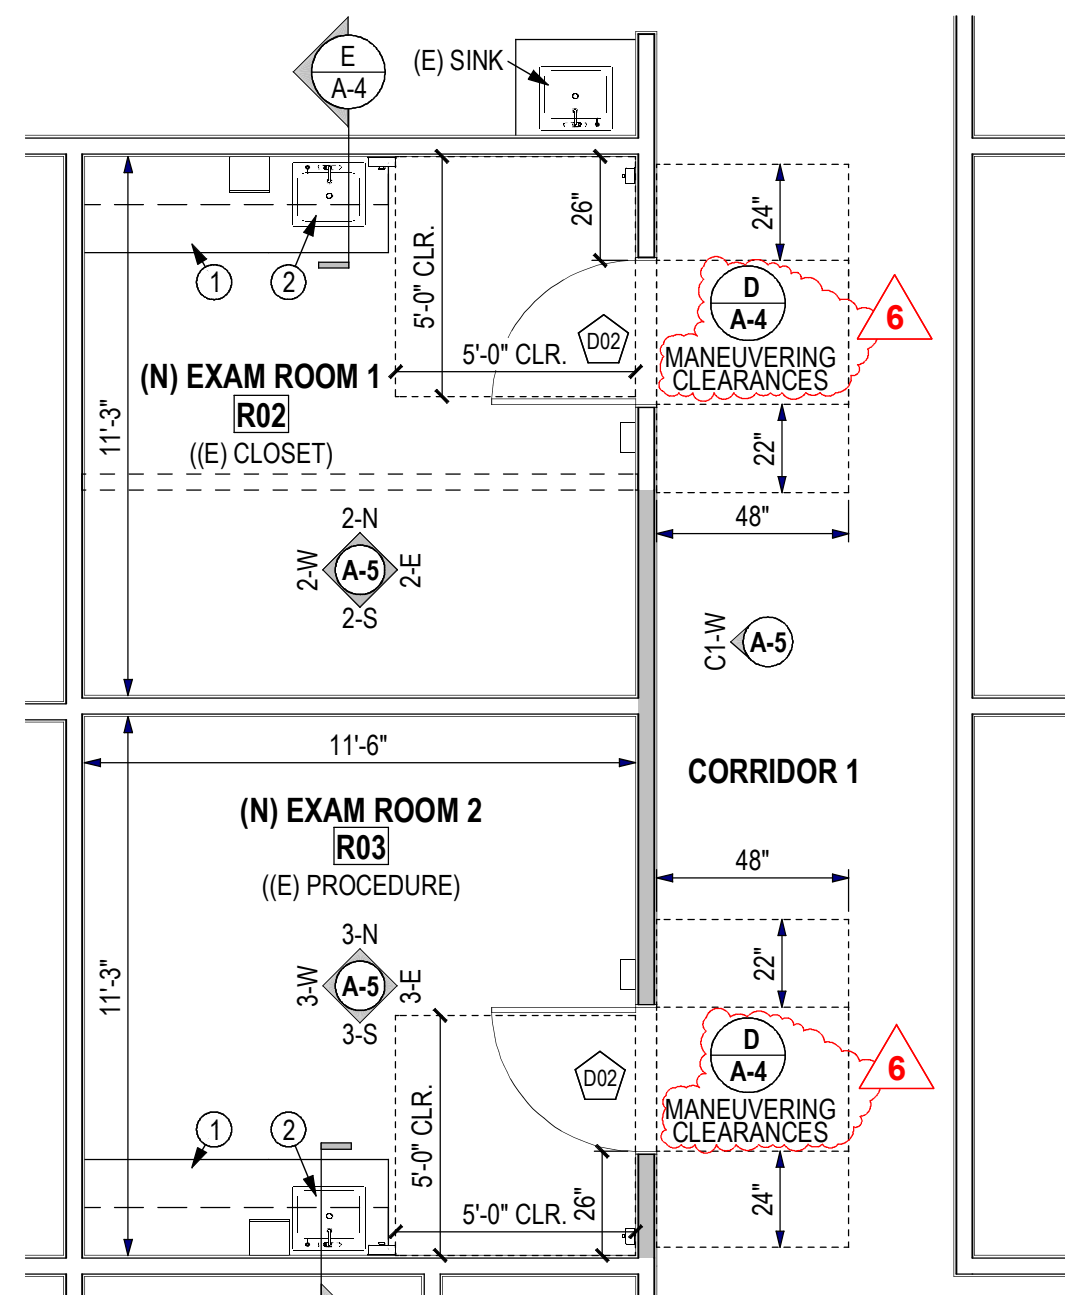

ROOMS 2 & 3 - EXAM CONVERT CLOSET AND PROCEDURE TO (2) EXAM ROOMS

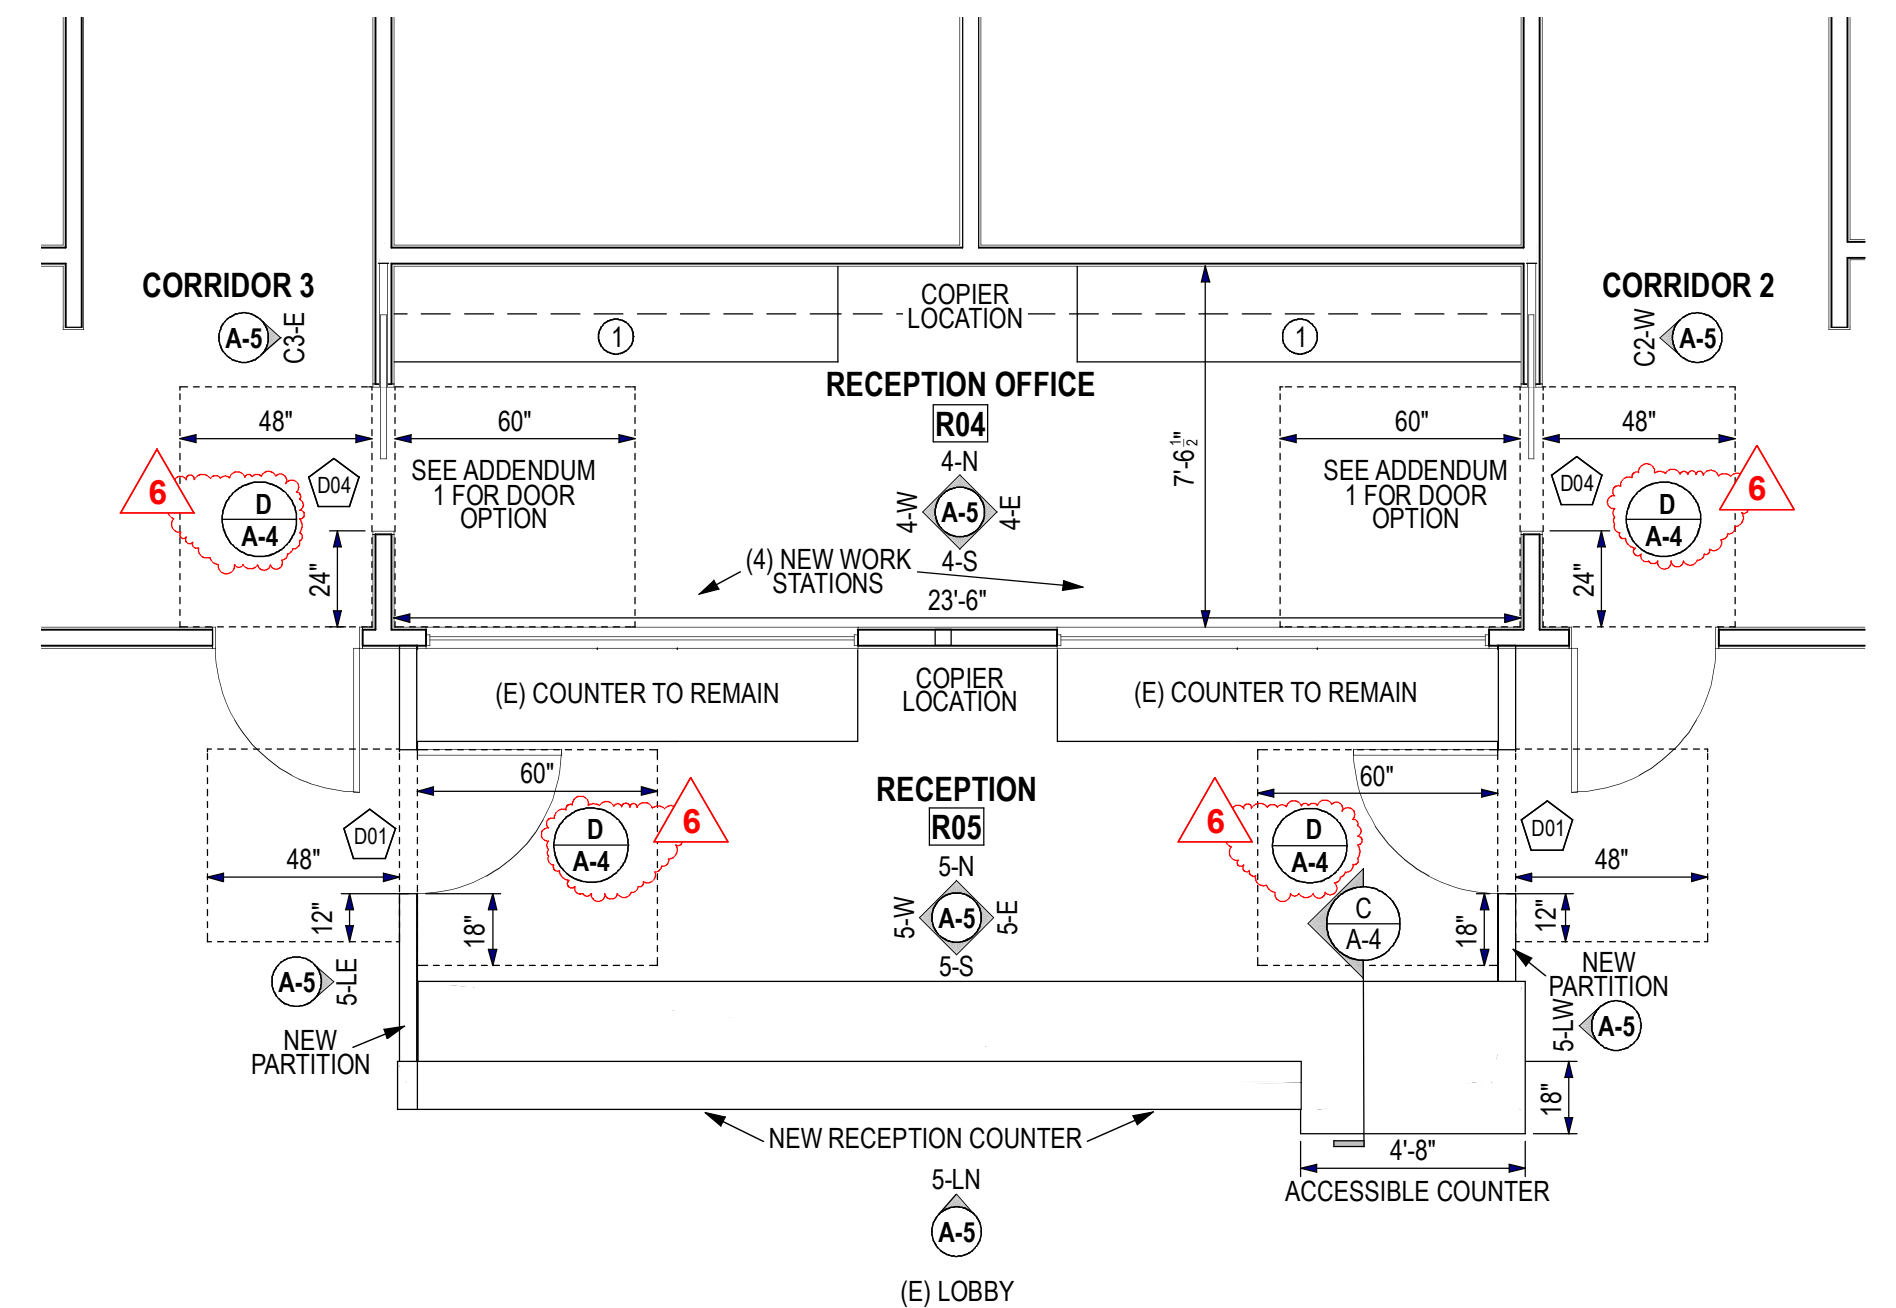


ROOMS 4 & 5 - RECEPTION / OFFICE REMODEL

ROOM FINISH SCHEDULE							
NUMBER	ROOM NAME	FLOOR FINISH	BASE	WALL MATERIAL	WALL FINISH	CEILING HEIGHT	CEILING FINISH
R01	ADMINISTRATION	VINYL PLANK	TOP SET BASE	GYPSUM BOARD	ENAMEL PAINT	109"	ACOUSTICAL CEILING TILES
R02	EXAM 1	RUBBER SHEET	TOP SET BASE	GYPSUM BOARD	ENAMEL PAINT, 4" HIGH FRP	120"	ACOUSTICAL CEILING TILES
R03	EXAM 2	RUBBER SHEET	TOP SET BASE	GYPSUM BOARD	ENAMEL PAINT, 4" HIGH FRP	120"	ACOUSTICAL CEILING TILES
R04	RECEPTION OFFICE	SMOOTH CONCRETE	TOP SET BASE	GYPSUM BOARD	ENAMEL PAINT	120"	ACOUSTICAL CEILING TILES
R05	RECEPTION	SMOOTH CONCRETE	TOP SET BASE	GYPSUM BOARD	ENAMEL PAINT		
TOTALS:							809


WINDOW SCHEDULE				
NUMBER	QTY	SIZE	TEMP.	DESCRIPTION
W01	1	10090	Yes	(N) Fixed Glass
W02	1	9020	Yes	(N) Fixed Glass
W03	2	9036	Yes	(N) Fixed Glass

WALL SCHEDULE	
Symbol	Wall Type(s)
	(N) 4" Steel Stud Wall
	(E) Interior Wall to Remain
	(E) Exterior Wall to Remain




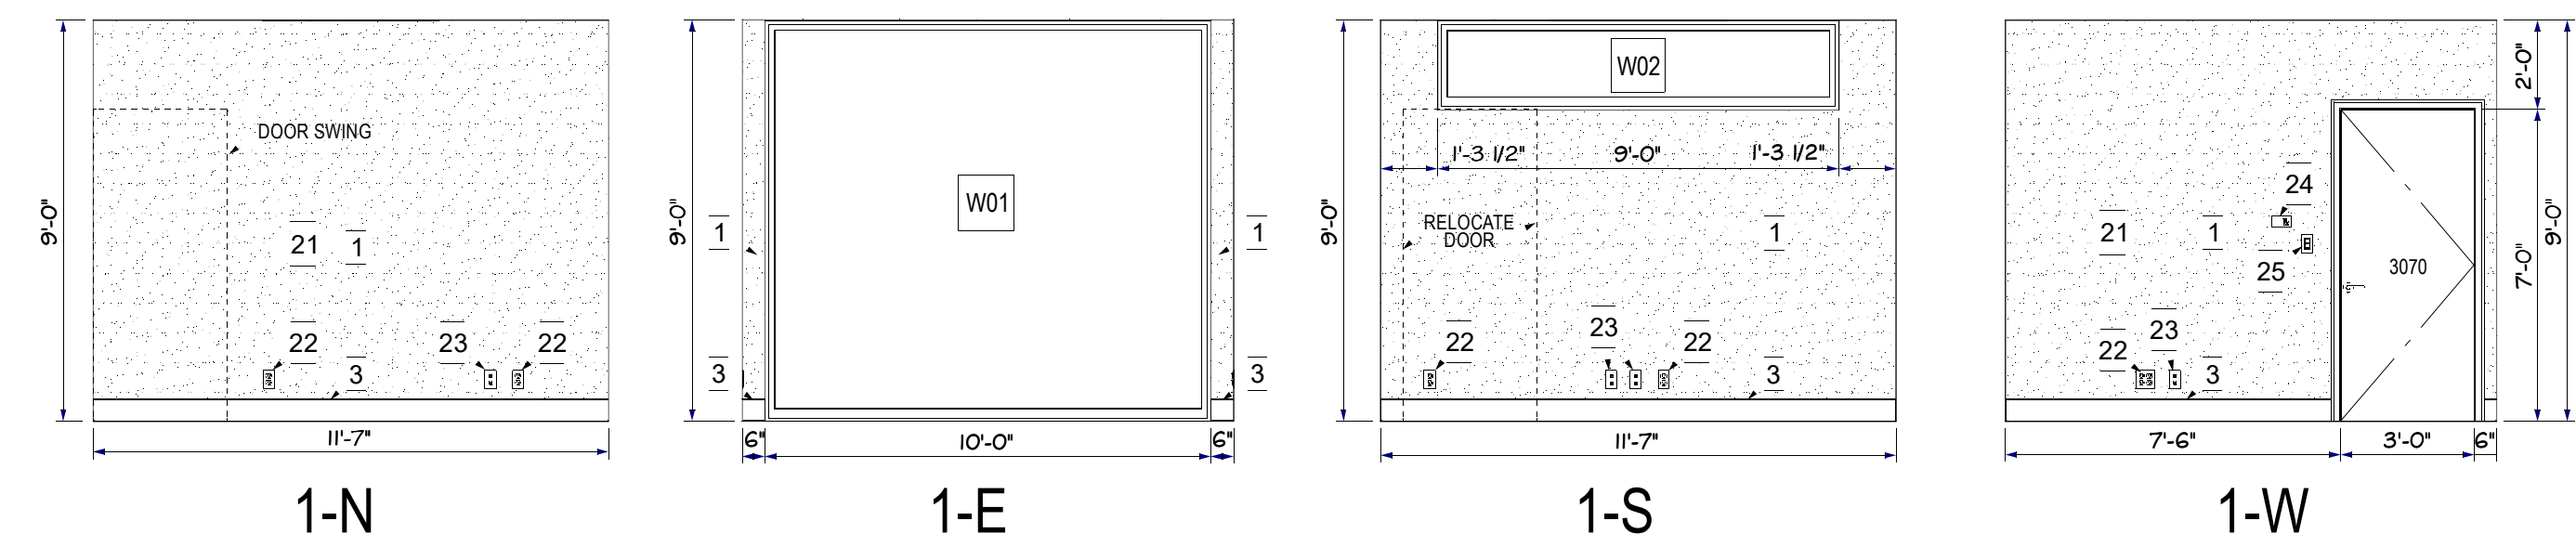


ROOM 1 - ADMINISTRATION

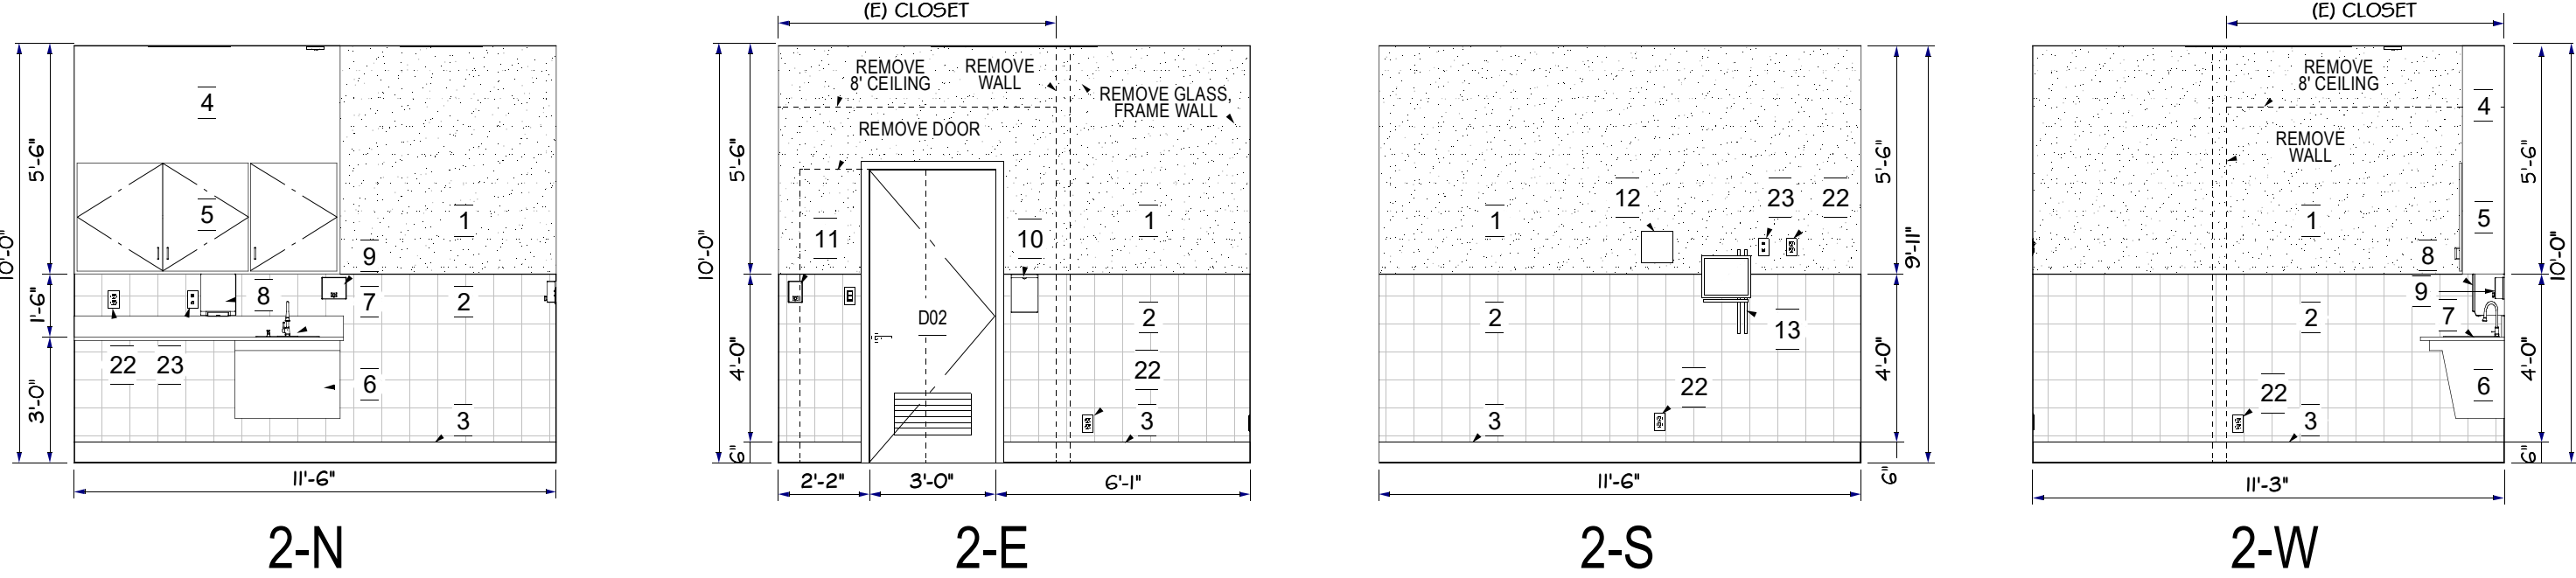


ROOM 2 - EXAM 1

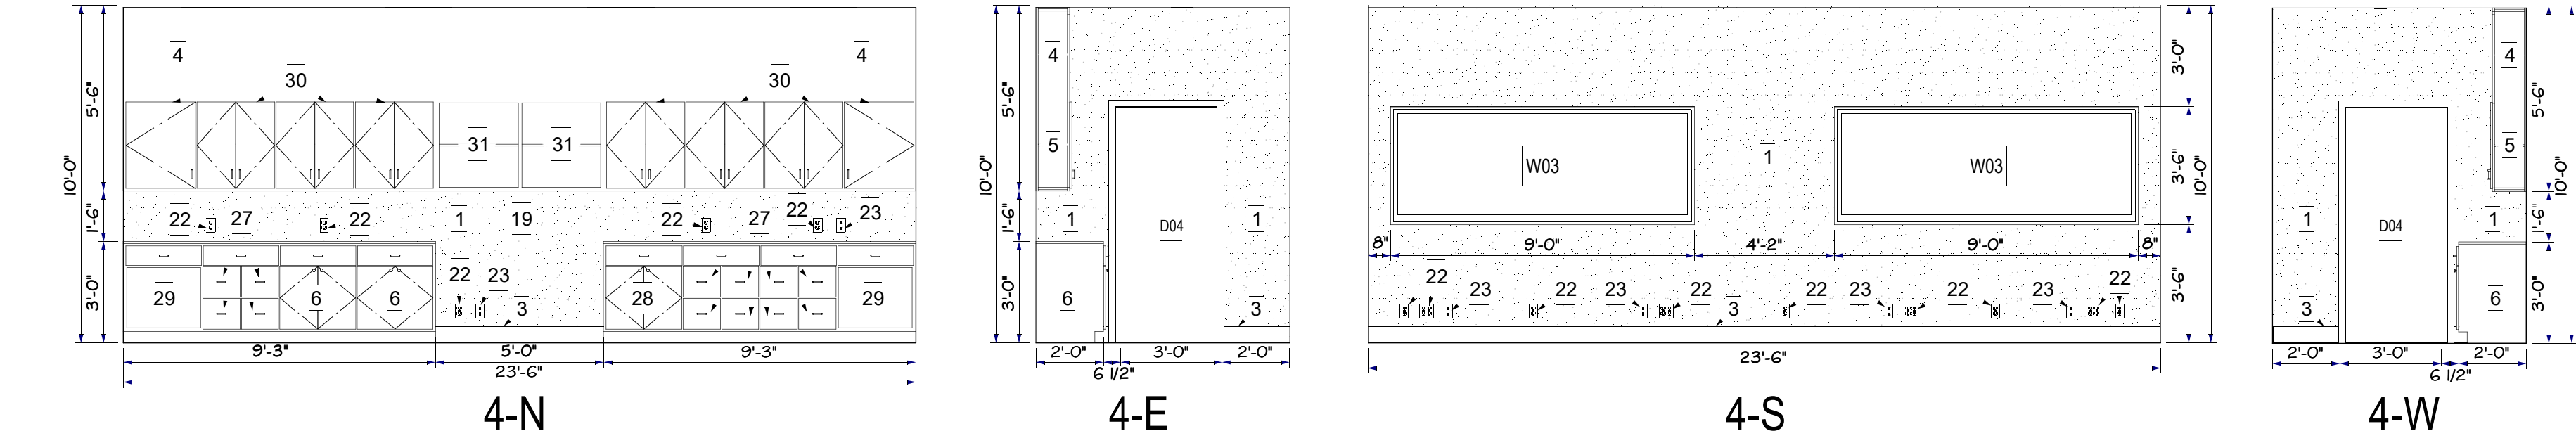


ROOM 4 - RECEPTION OFFICE

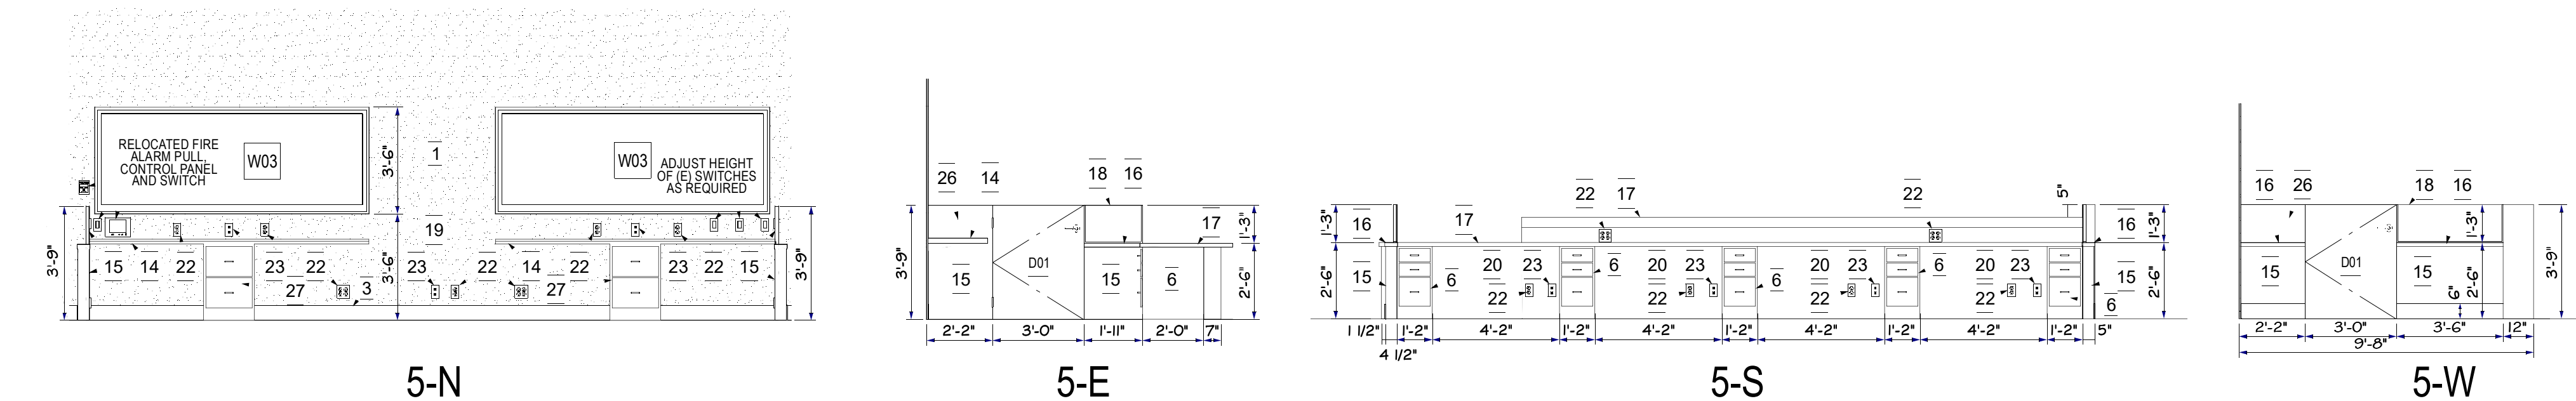

ROOM 5 - RECEPTION

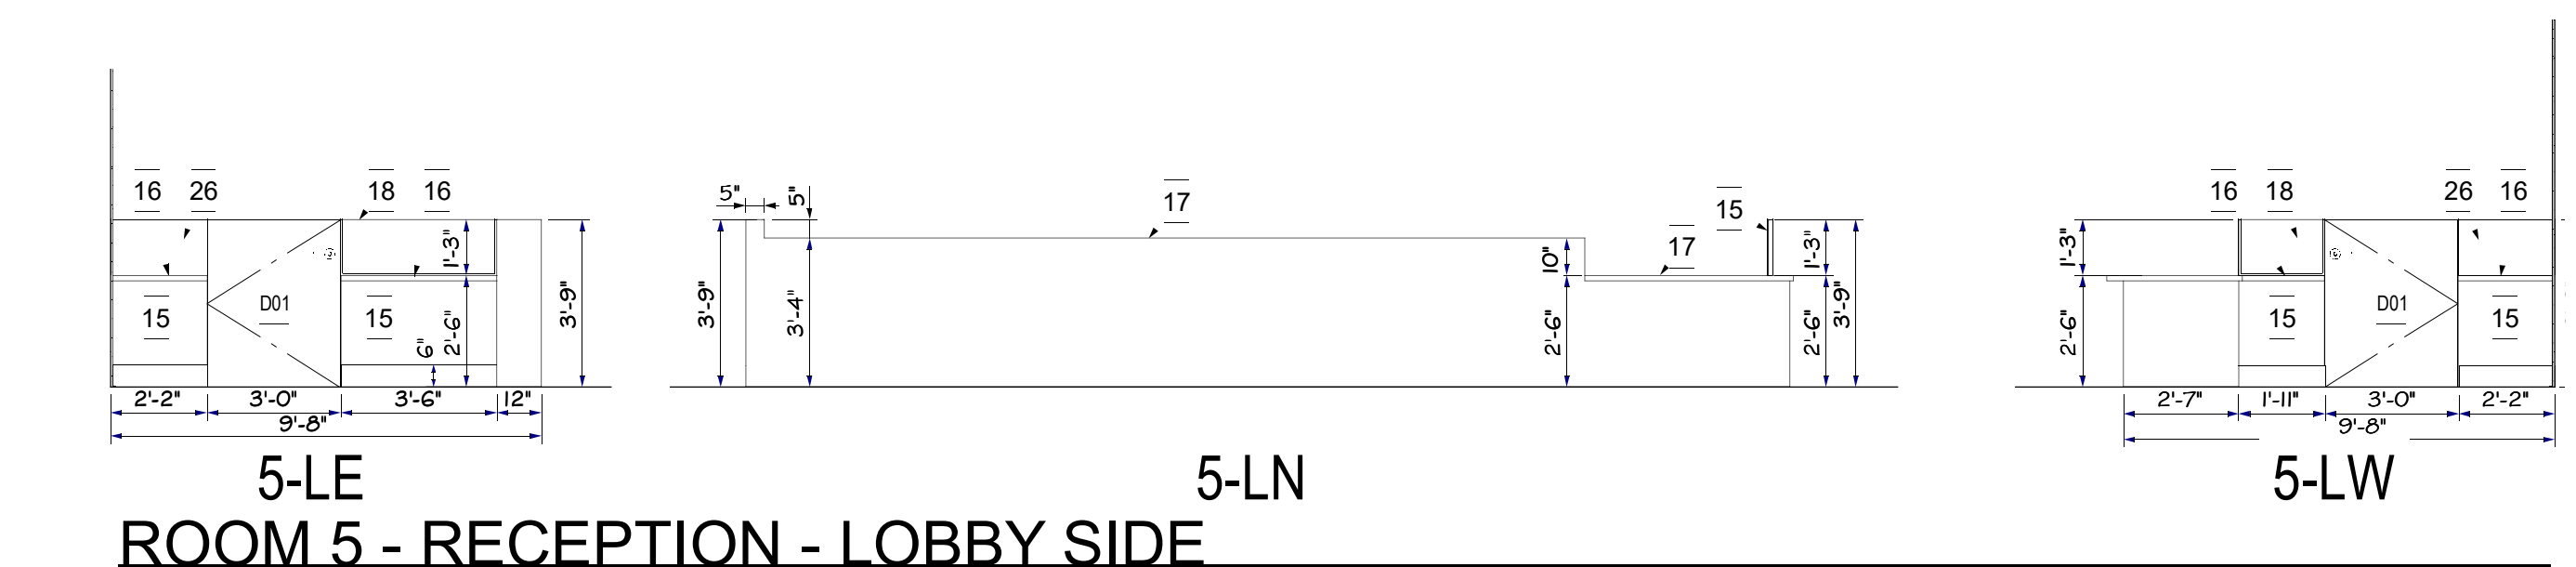

ROOM 5 - RECEPTION - LOBBY SIDE

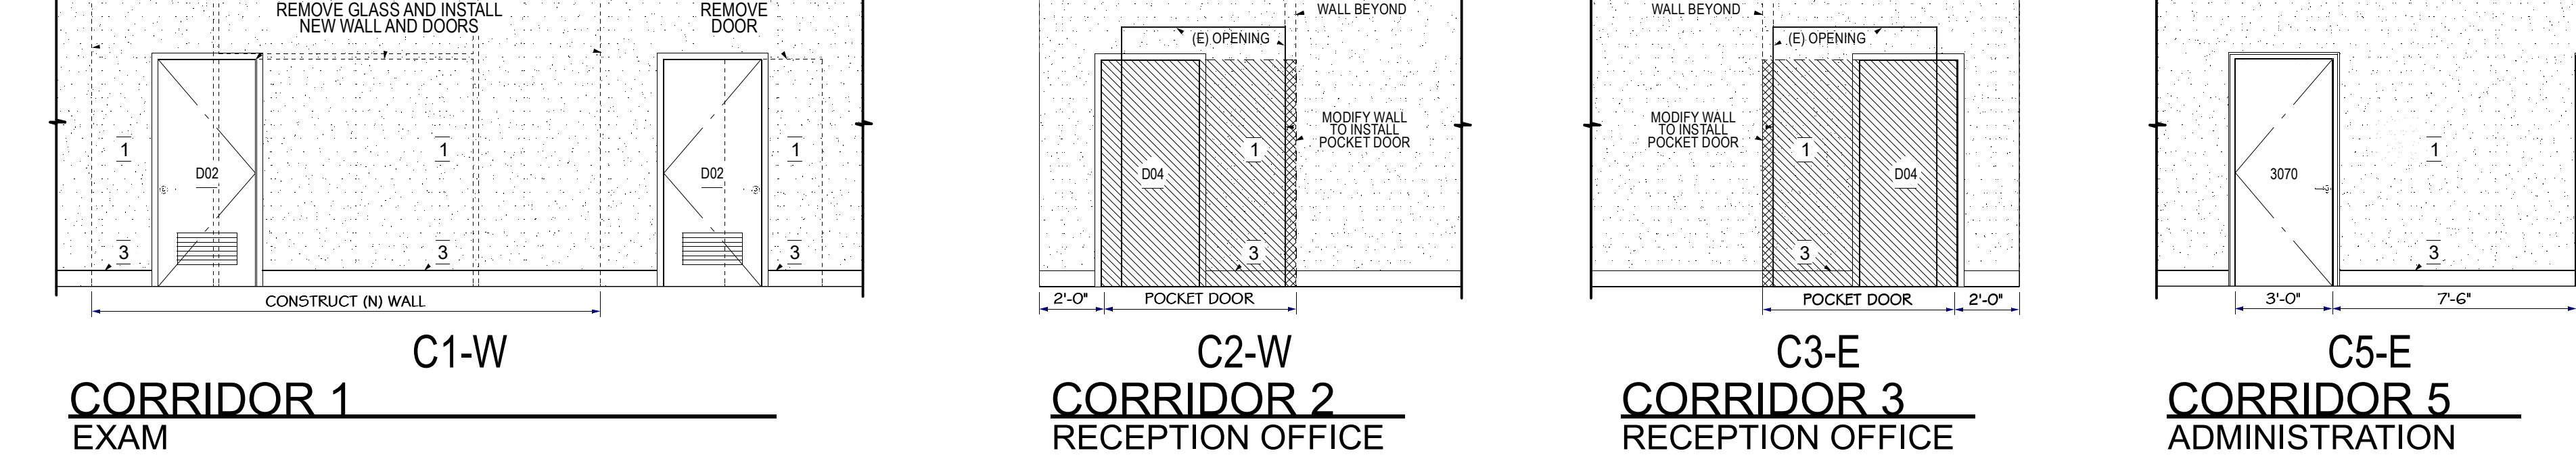


CORRIDOR 1
EXAM

CORRIDOR 2
RECEPTION OFFICE

CORRIDOR 3
RECEPTION OFFICE

CORRIDOR 5
ADMINISTRATION

ROOM 1 - ADMINISTRATION - LOBBY SIDE

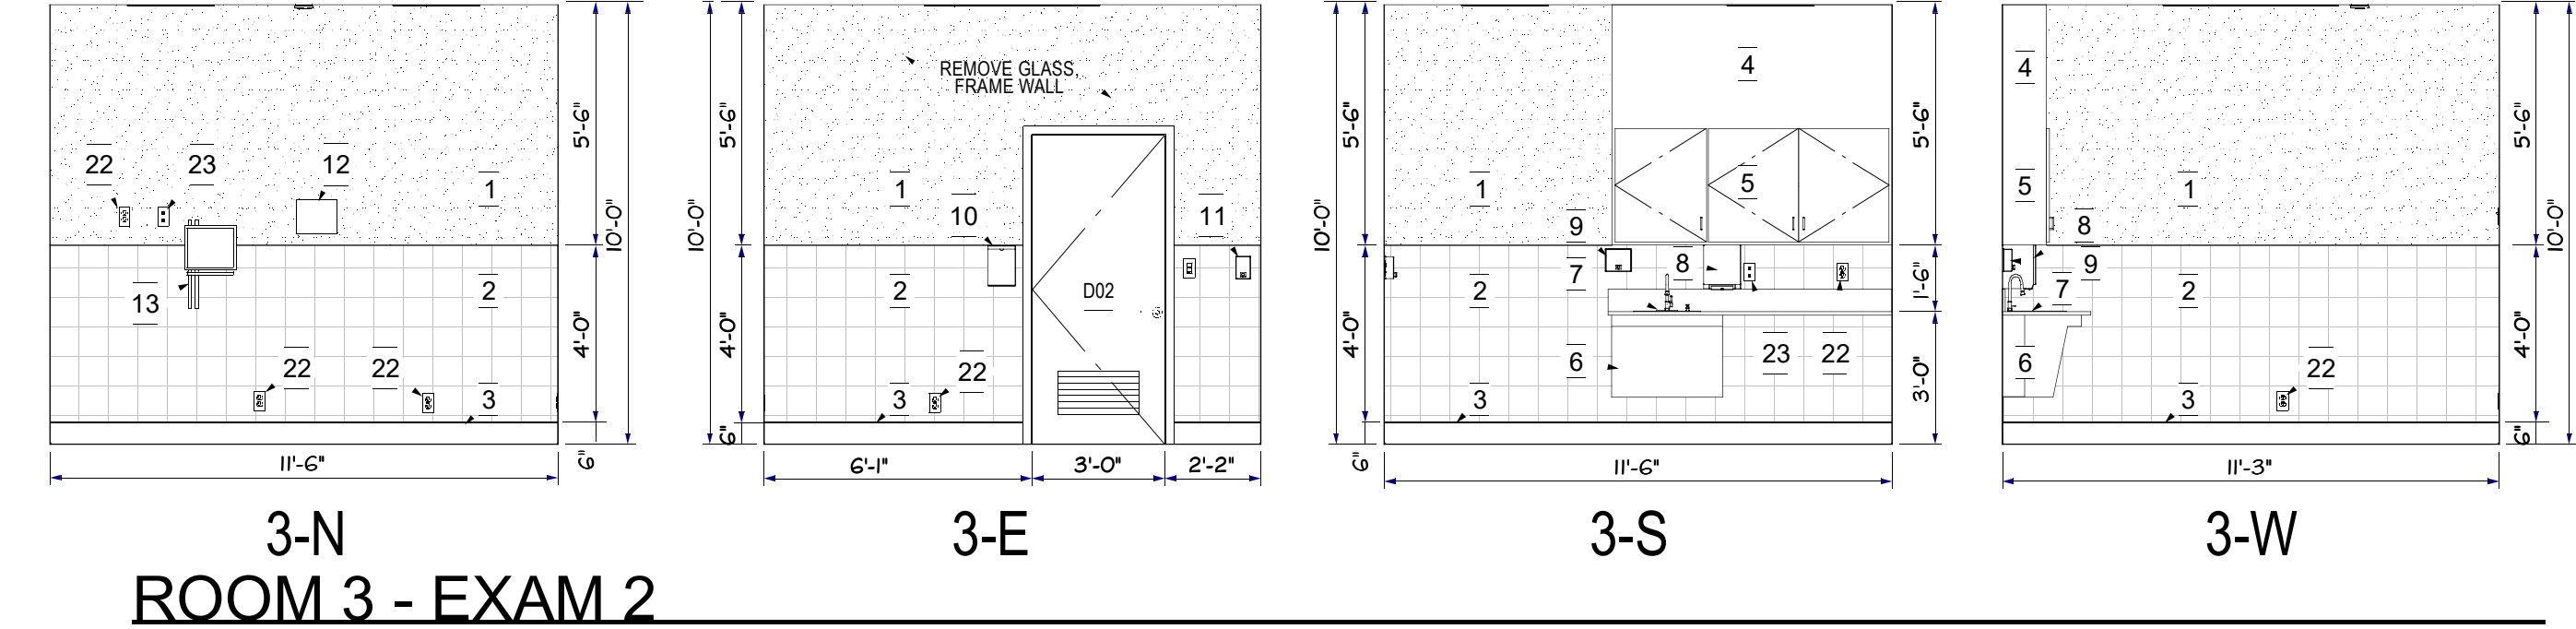

ROOM 3 - EXAM 2

INTERIOR ELEVATION SCHEDULE			
MATERIAL	FINISH		
1	GYPSUM BOARD	ENAMEL PAINT	
2	FIBERGLASS REINFORCED PLASTIC (FRP)	FACTORY	
3	TOP SET BASE	FACTORY	
4	(N) CLOSURE PANEL	FACTORY	
5	(N) WALL CABINET	FACTORY	
6	(N) BASE CABINET	FACTORY	
7	(N) SINK	FACYORY	
8	(N) WALL HUNG, SURFACE MOUNTED, PAPER TOWEL DISPENSER	FACTORY	
9	(N) WALL HUNG, SURFACE MOUNTED, SOAP DISPENSER	FACTORY	
10	WALL HUNG DISPOSAL CONTAINER	ENAMEL PAINT	
11	WALL HUNG SURFACE MOUNTED HAND SANITIZER	ENAMEL PAINT	
12	WALL HUNG SPIGONANOMETER (BLOOD PRESSURE MONITOR)	ENAMEL PAINT	
13	WALL HUNG COMPUTER ARM, MOUNTING HEIGHT PER MFR.	ENAMEL PAINT	
14	COUNTER TO REMAIN		
15	(N) PARTITION	FACTORY	
16	(N) WALL CAP	FACTORY	
17	(N) COUNTER	FACTORY	
18	(N) GLASS PANEL, TEMP.		
19	COPIER SPACE		
20	KNEE SPACE		
21	SOUNDPROOF WALL	2 LAYERS STC 60 SOUND PROOF DRYWALL	
22	DUPLEX RECEPTACLE, SEE PLAN	FACTORY	
23	DATA / PHONE, SEE PLAN	FACTORY	
24	RELOCATED THERMOSTAT	FACTORY	
25	RELOCATED OCCUPANT SENSOR SWITCH	FACTORY	
26	(N) SOLID PANEL TO MATCH ADJACENT		
27	(N) LOCKABLE FILE DRAWERS	FACTORY	
28	(N) BASE CABINET, NO SHELVING	FACTORY	
29	(N) OPEN BASE CABINET	FACTORY	
30	(N) LOCKABLE WALL CABINETS	FACTORY	
31	(N) OPEN WALL CABINET W/ ADJUSTABLE SHELVING	FACTORY	

NUMBER	QTY	SIZE	TEMP.	DESCRIPTION	COMMENTS
W01	1	10090	Yes	(N) Fixed Glass	ONE-WAY VIEW TC
W02	1	9020	Yes	(N) Fixed Glass	
W03	2	9036	Yes	(N) Fixed Glass	

WALL SCHEDULE	
Symbol	Wall Type(s)
(N) 4" Steel Stud Wall	
(E) Interior Wall to Remain	
(E) Exterior Wall to Remain	

REVISIONS


PROJECT CONTACT:
Ryan Shultz, MSHCA
Executive Director
(661) 765-7234 Office
(661) 203-5757 Cell
rshultz@wshcd.org

PROJECT ADDRESS:
Westside Health Care District
100 E. North Street
Taft, CA. 93268

MECHANICAL, ELECTRICAL & PLUMBING PLANS:
Cantelmi Engineering, Inc.
Frank Cantelmi, PE
2130 F St, Bakersfield, CA 93301
cantelmi@cantelmi.net (661) 324-5252


PRINCIPAL ENGINEER
Darren E. Strong, PE
STRONG
ENGINEERING & DESIGN
Commercial, Industrial, Residential
1400 Eaton Drive, Suite 208
Bakersfield, CA 93315
(805) 340-4300
dstrong@strong-engineering.com

SHEET
A-5
OF 20 SHEETS
DATE: 5/19/2025

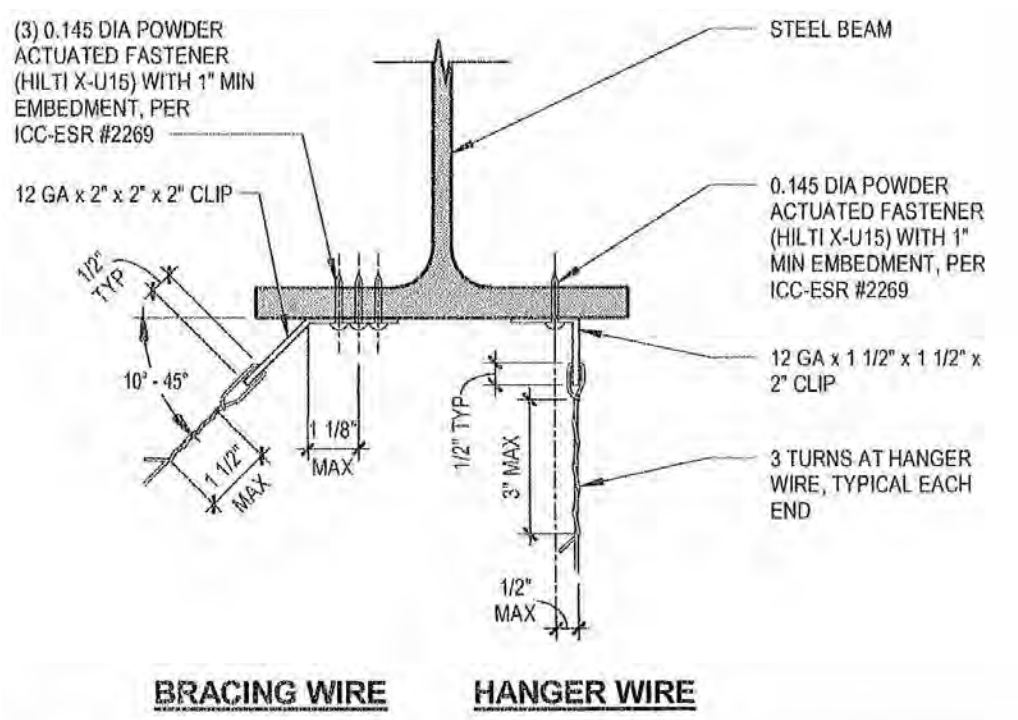


NOTES:
1. BEAM FLANGE THICKNESS SHALL NOT BE LESS THAN 3/16" OR MORE THAN 3/8".
2. FRAMING MEMBERS SHALL BE DESIGNED TO CARRY THE CEILING LOADS, RDP TO VERIFY.
3. RDP IN RESPONSIBLE CHARGE, IOR AND CONTRACTOR SHALL VERIFY THAT NO PAF IS INSTALLED IN THE PROTECTED ZONE OF ANY STEEL MEMBER, PER ANSI/AISC 34.


1 CP-1 WIRE ATTACHMENT

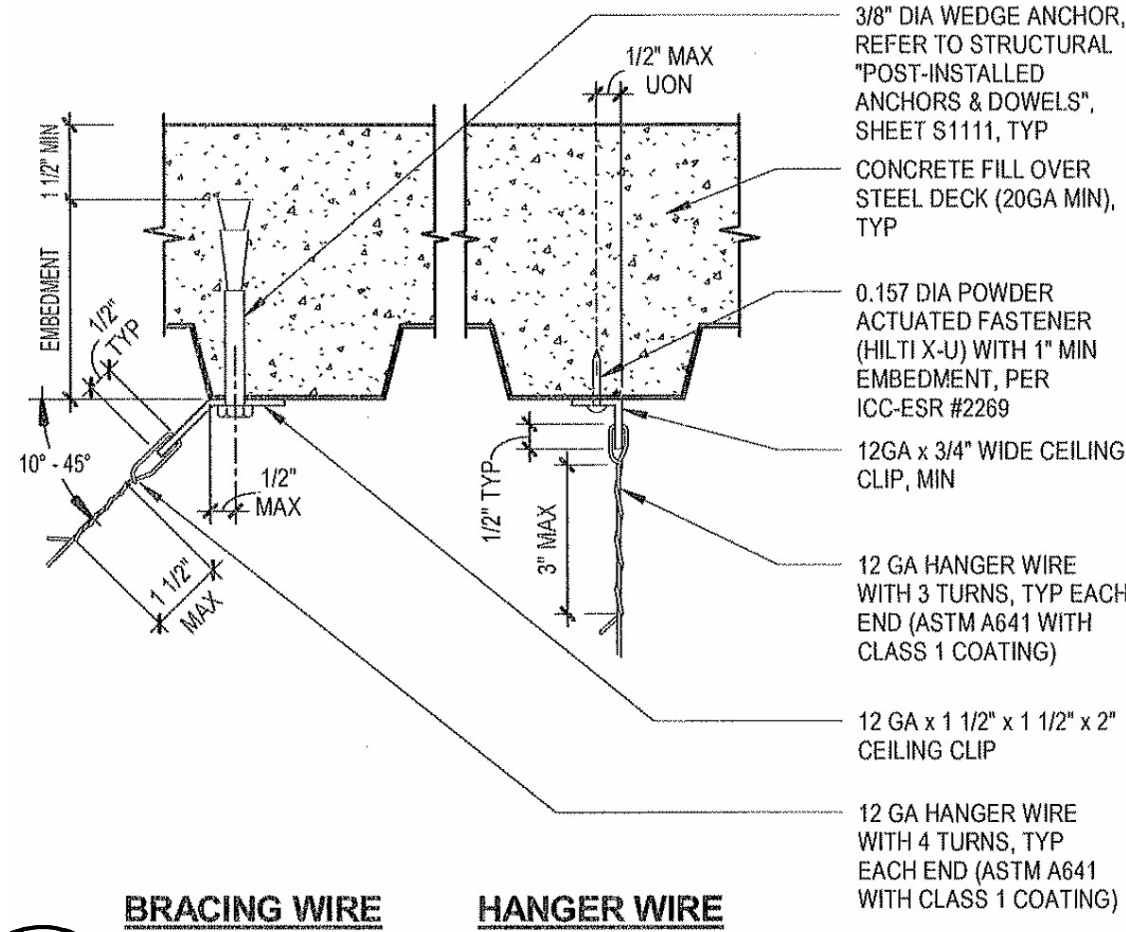


2 CP-1 WIRE TIE ATTACHMENT

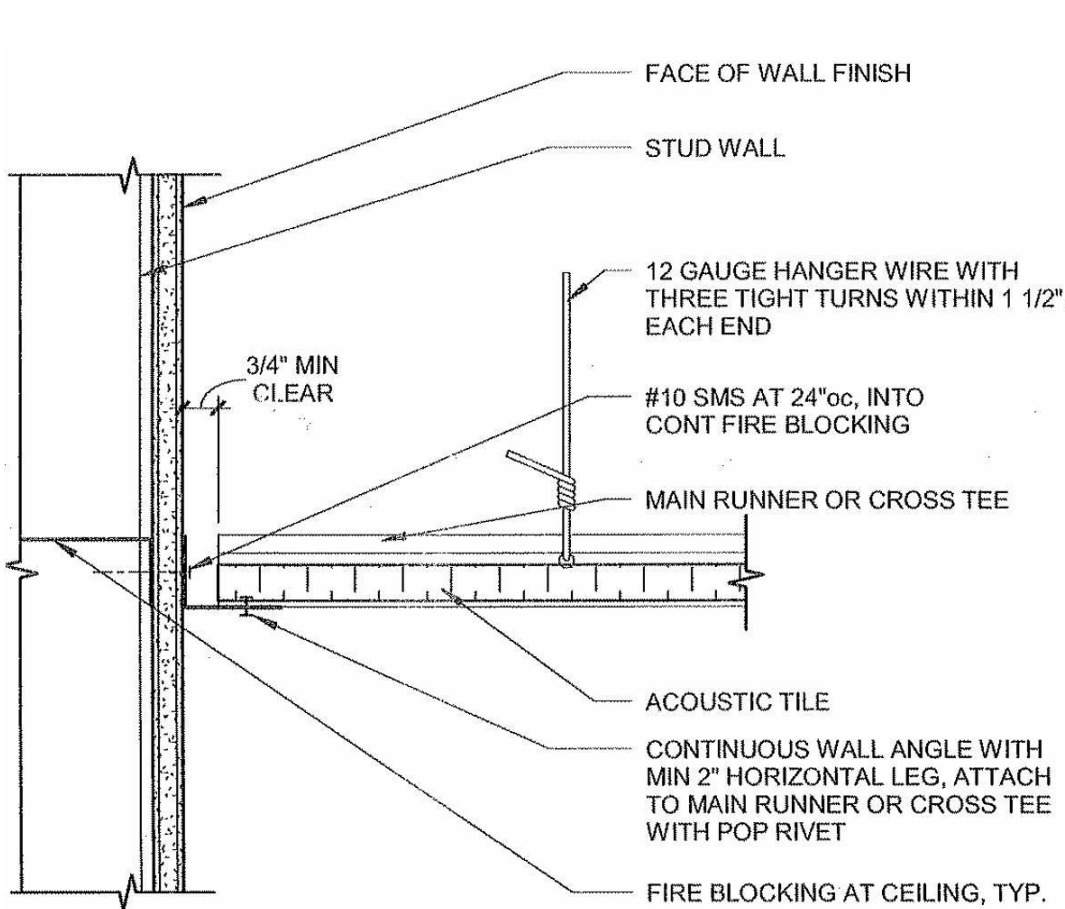


3 CP-1 CEILING AT FIXED END

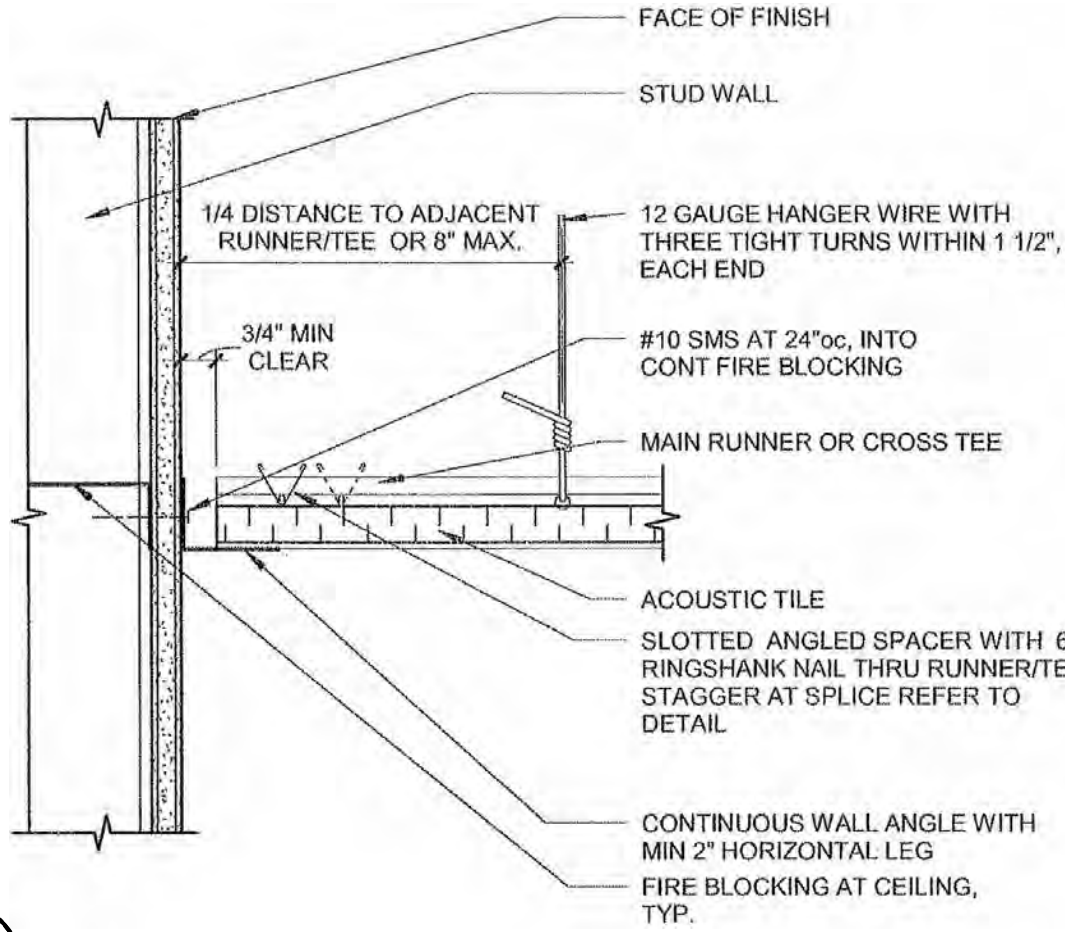


4 CP-1 CEILING AT FREE END

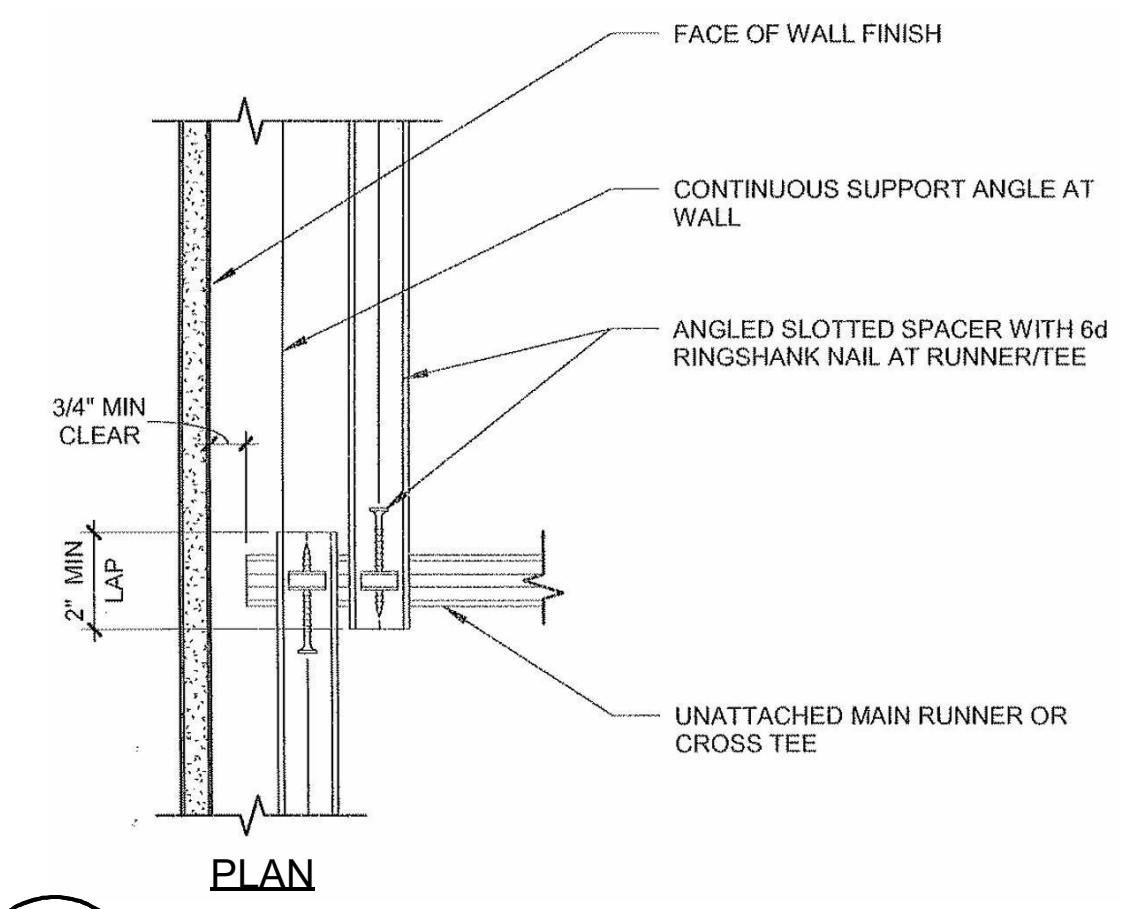


5 CP-1 SPACER ATTACHMENT

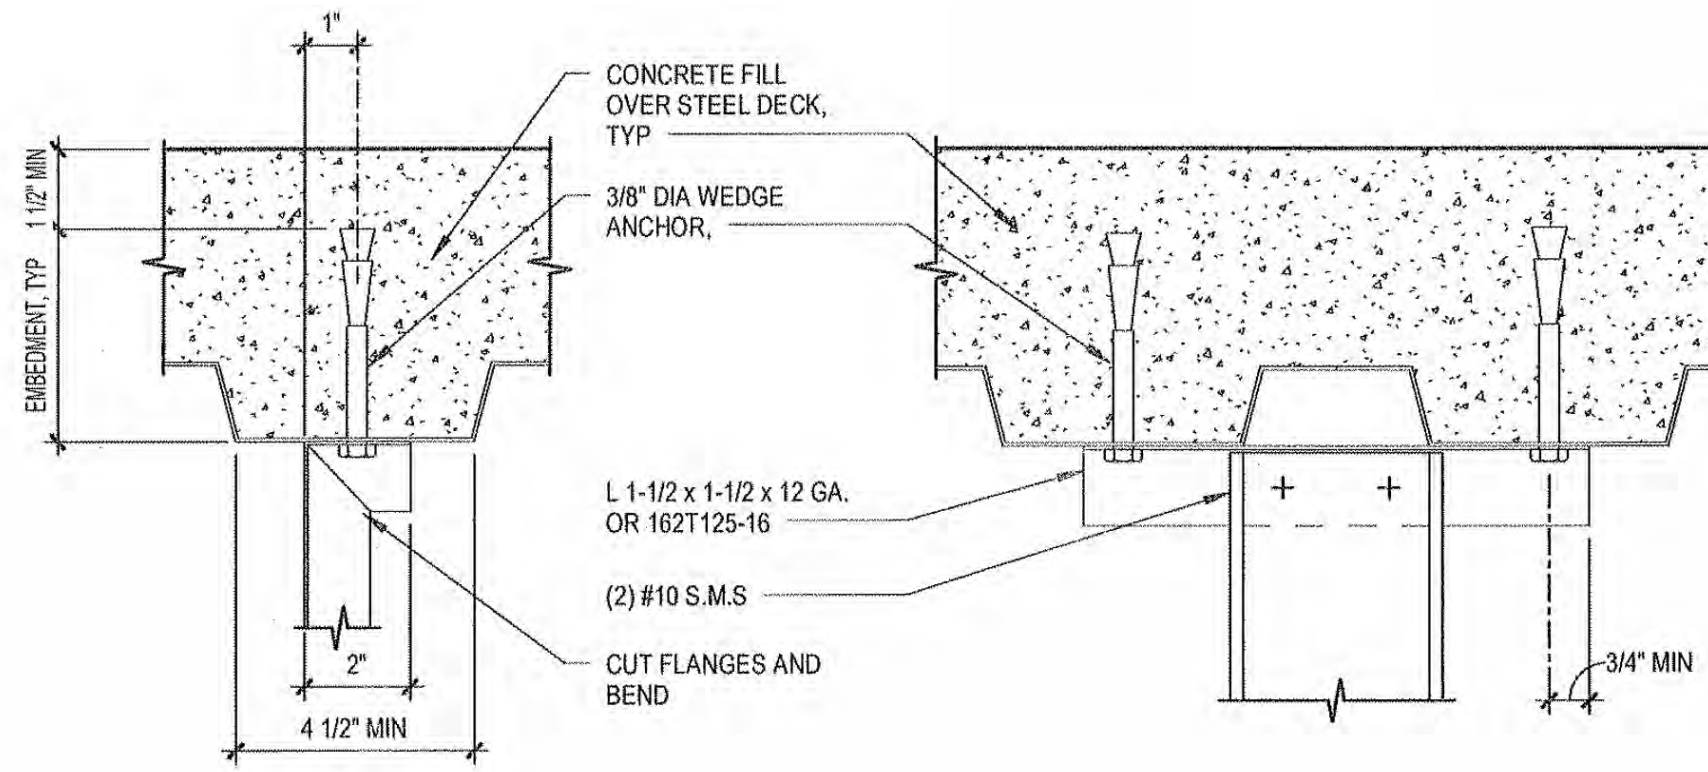

6 CP-1 CHANNEL STRUT

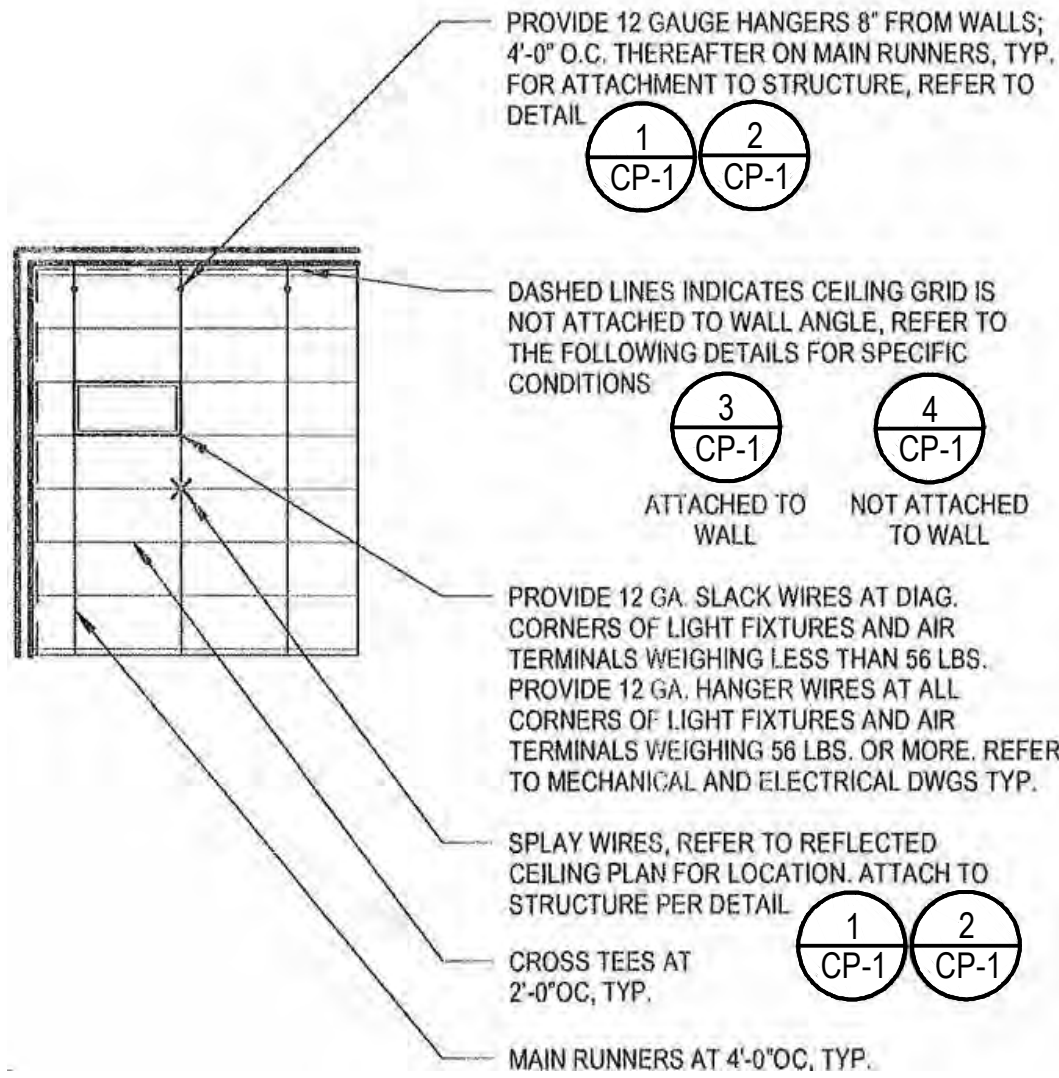

GENERAL NOTES
1. BRACING WIRES AND COMPRESSION STRUT SHALL OCCUR AT EVERY 96 SF, MAX IN ROOMS OVER 96 SF.
2. THE SLOPE OF BRACING WIRES MAY BE FROM 10 TO 45 DEGREES BUT MAY NOT EXCEED 45 DEGREES FROM THE PLANE OF THE CEILING AND WIRES SHALL BE TAUGHT.
3. STRUTS SHALL BE ADEQUATE TO RESIST THE VERTICAL COMPONENT INDUCED BY THE BRACING WIRES, AND SHALL NOT BE MORE THAN 1 (HORIZONTAL) IN 6 (VERTICAL) OUT OF PLUMB.

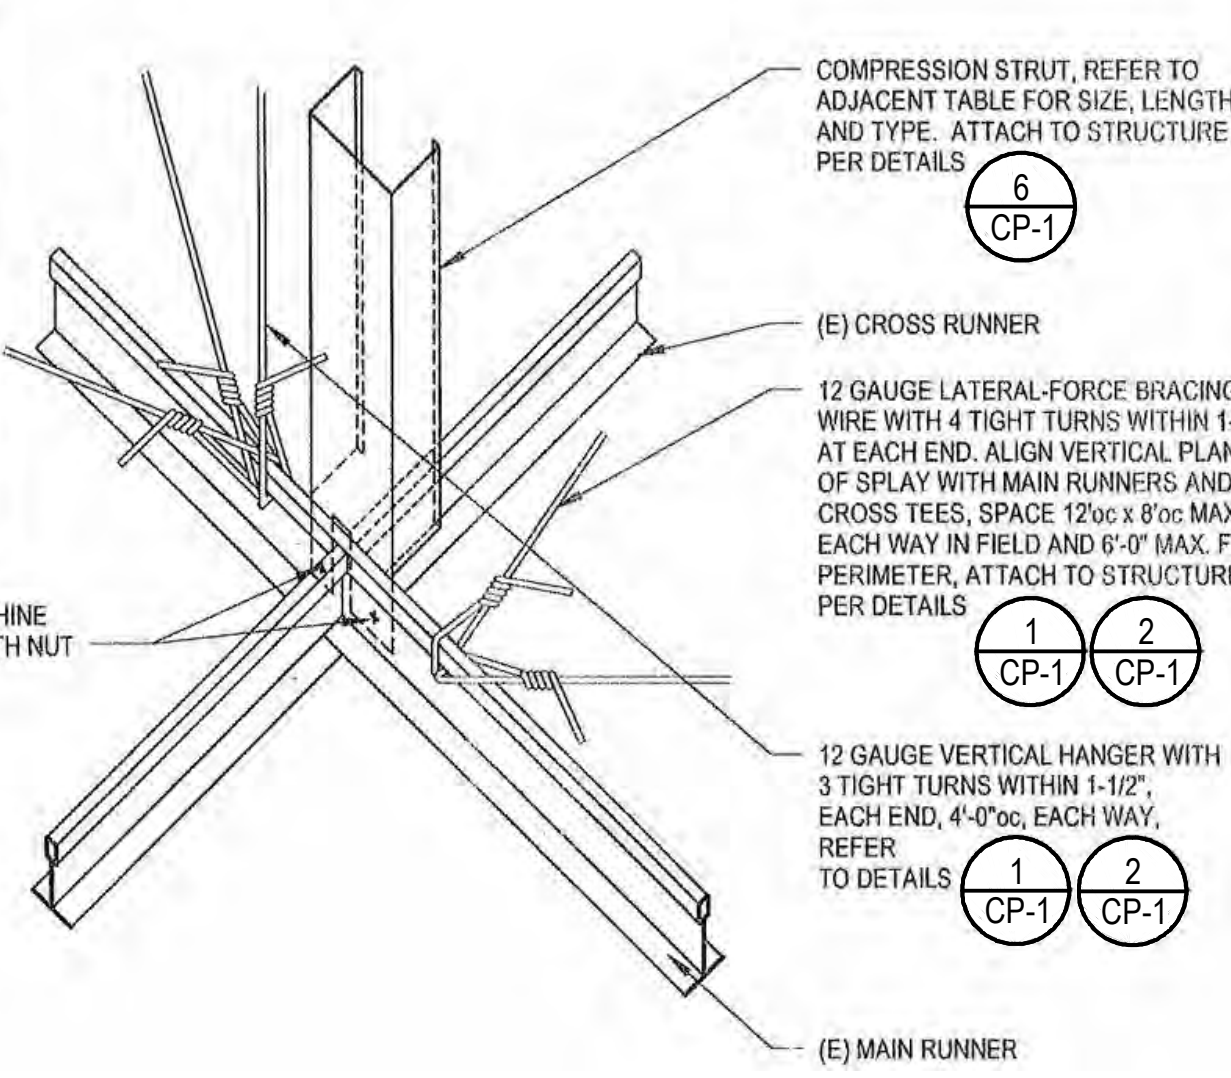

COMPRESSION STRUT TABLE	
MAXIMUM UNSUPPORTED LENGTH FOR SINGLE STUD USED AS CEILING COMPRESSION STRUT AT 12-0"OC (400S137-33 (20GA))	
SIZE	LENGTH
20GA x 4"	10'-5"
NOTES: 1. ALL STUDS SHALL HAVE 1 5/8" FLANGES WITH STIFFENED EDGES.	

SUSPENDED ACOUSTICAL CEILING LEGEND - SPLAY WIRE N.T.S.

RCP LEGEND			
Symbol	Description	Qty	Comments
	2x4 LED RECESSED LUMINAIRE	3	NORMAL BRANCH CIRCUIT
	2x4 LED RECESSED LUMINAIRE	3	SHADING DENOTES EMERGENCY / CRITICAL BRANCH CIRCUIT
	2x2 LED RECESSED LUMINAIRE	3	NORMAL BRANCH CIRCUIT
	2x2 LED RECESSED LUMINAIRE	1	SHADING DENOTES EMERGENCY / CRITICAL BRANCH CIRCUIT

ROOM 1 - ADMINISTRATION REMODEL

ROOMS 2 & 3 - EXAM CONVERT CLOSET AND PROCEDURE TO (2) EXAM ROOMS

ROOMS 4 & 5 - RECEPTION / OFFICE REMODEL



REFLECTED CEILING PLANS 1/4" = 1'- 0"

RCP NOTE SCHEDULE	
1	"HEAVY DUTY" 2X2 SUSPENDED ACOUSTICAL CEILING SYSTEM
2	2X4 LED RECESSED LUMINAIRE
3	2X2 LED RECESSED LUMINAIRE
4	CEILING DIFFUSER
5	RETURN AIR




PROJECT CONTACT:
Ryan Shultz, MSHCA
Executive Director
(661) 765-7234 Office
(661) 203-5757 Cell
rshultz@wshcd.org

PROJECT ADDRESS:
Westside Health Care District
100 E. North Street
Taft, CA. 93268

MECHANICAL, ELECTRICAL & PLUMBING PLANS:
Cantelmi Engineering, Inc.
Frank Cantelmi, PE
2130 F St, Bakersfield, CA 93301
cantelmi@cantelmi.net (661) 324-5252


PRINCIPAL ENGINEER
Darren E. Strong, PE
STRONG
ENGINEERING & DESIGN
Commercial, Industrial, Residential
1400 Eaton Drive, Suite 208
Bakersfield, CA 93311
(805) 340-4300
strong@strong-engineering.com

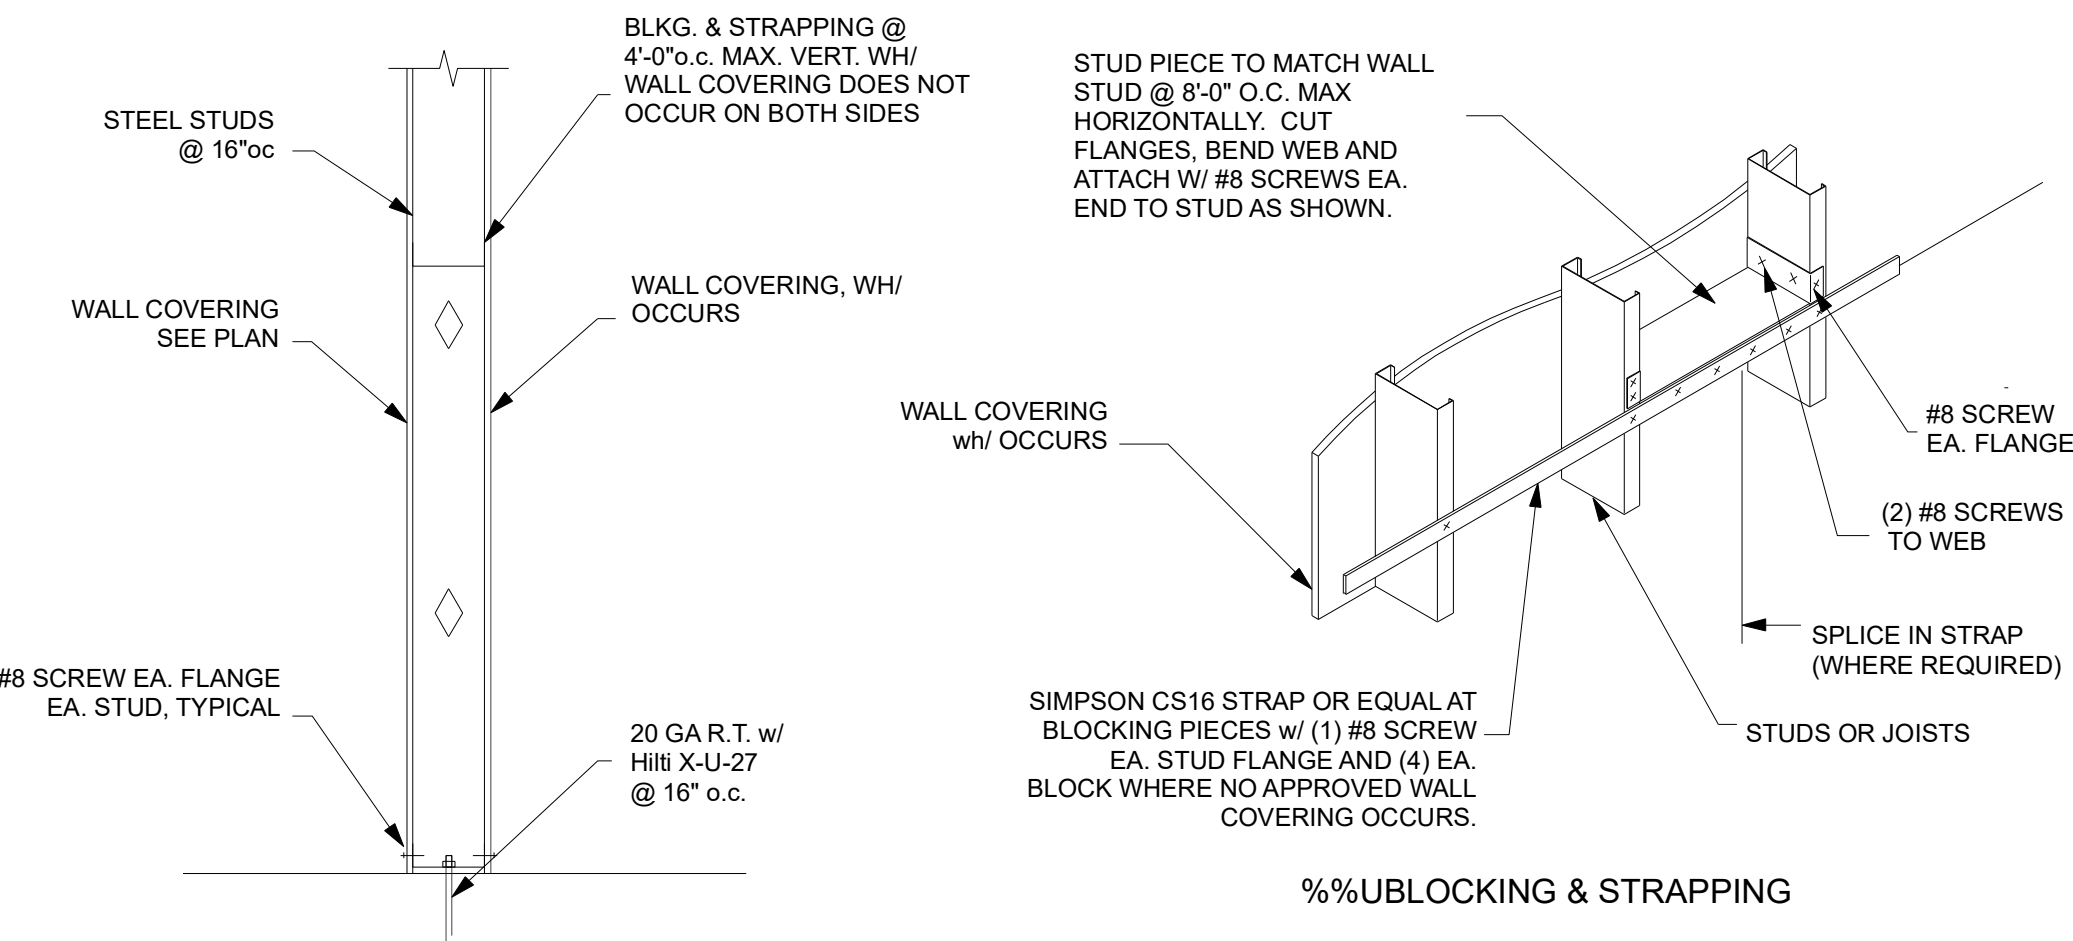

NOTE
A STRAP SHALL BE PLACED AT A DISTANCE
NO GREATER THAN 10" FROM THE TOP TRACK

STUD DESIGNATIONS	
NOTED ON PLAN	SSMA
3 5/8" x 20 GA	362 S162-33
3 5/8" x 20 GA RUNNER TRACK	362 T125-33
6" x 20 GA	600 S162-33
6" x 20 GA RUNNER TRACK	600 T125-33
8" x 20 GA	800 S162-33
8" x 20 GA RUNNER TRACK	800 T125-33

HEADER SCHEDULE	
MAX. SPAN	HEADER
6'-0"	BOXED 6"x20 GA. (600 S162-33)
10'-0"	BOXED 8"x20 GA. (800 S162-33)

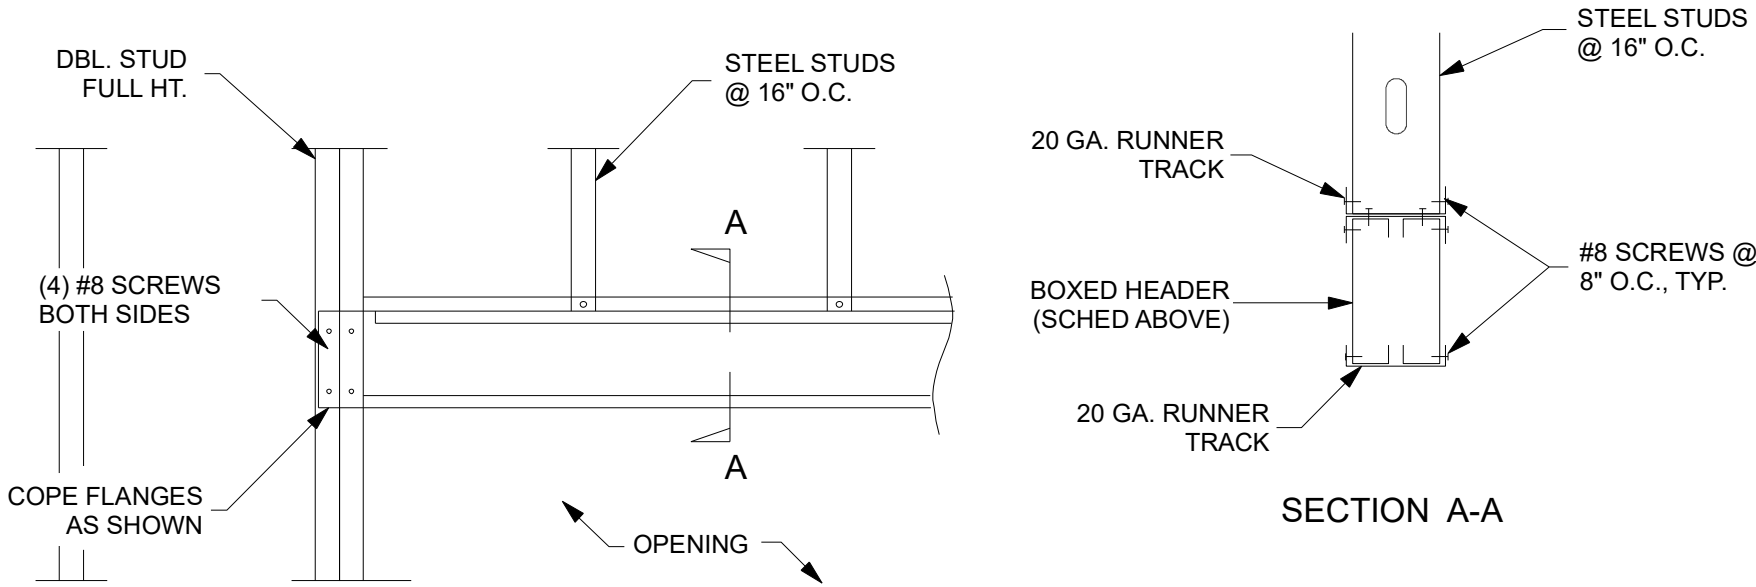


Steel Studs

3

Header


4

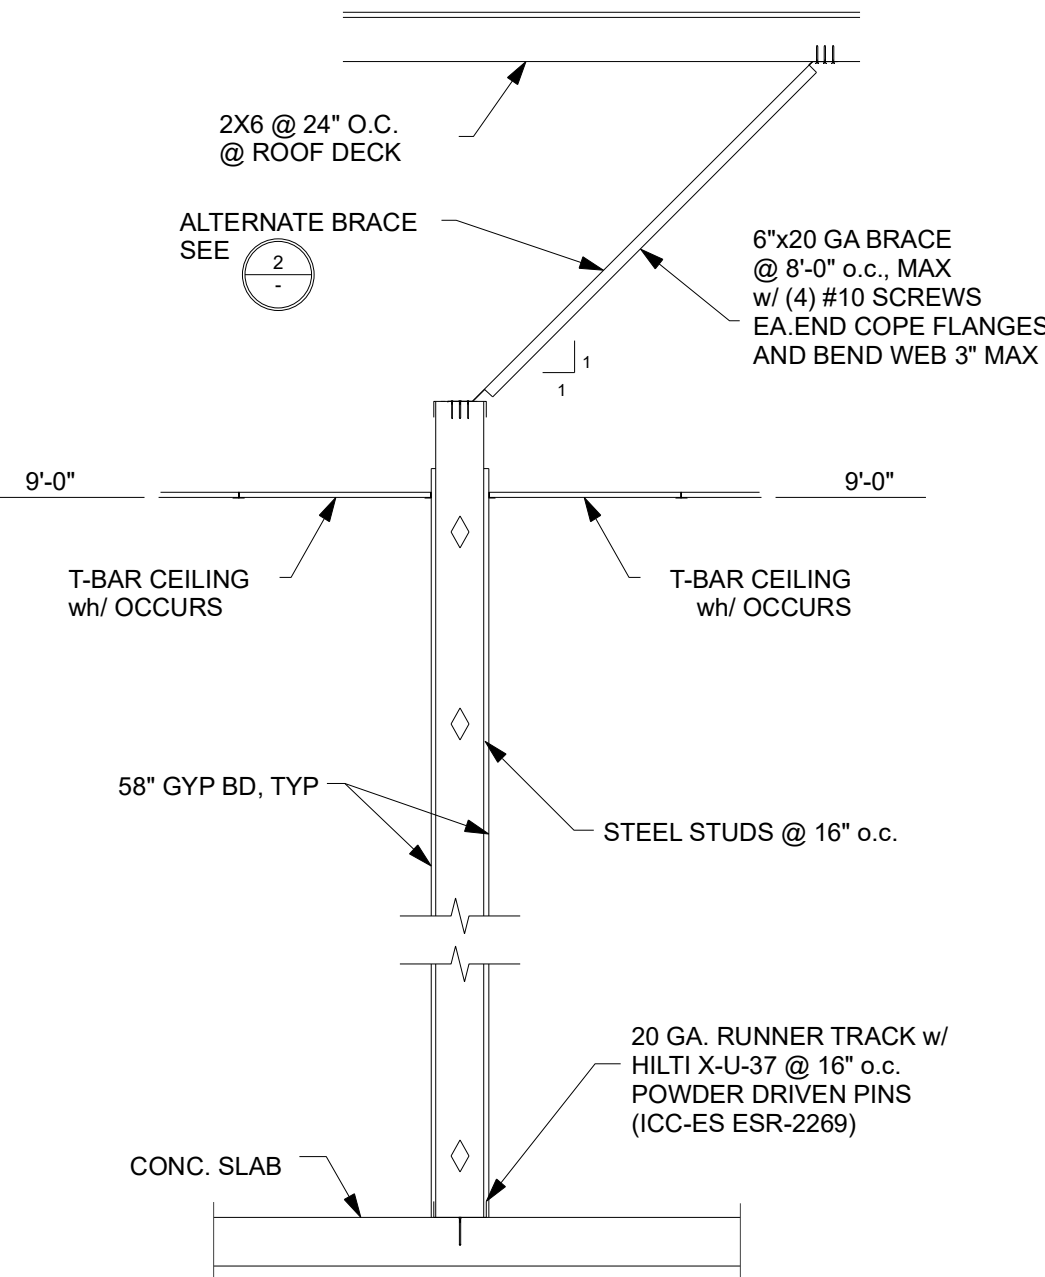

LIGHT GAUGE FRAMING

Scale: 1/2" = 1'-0"

1

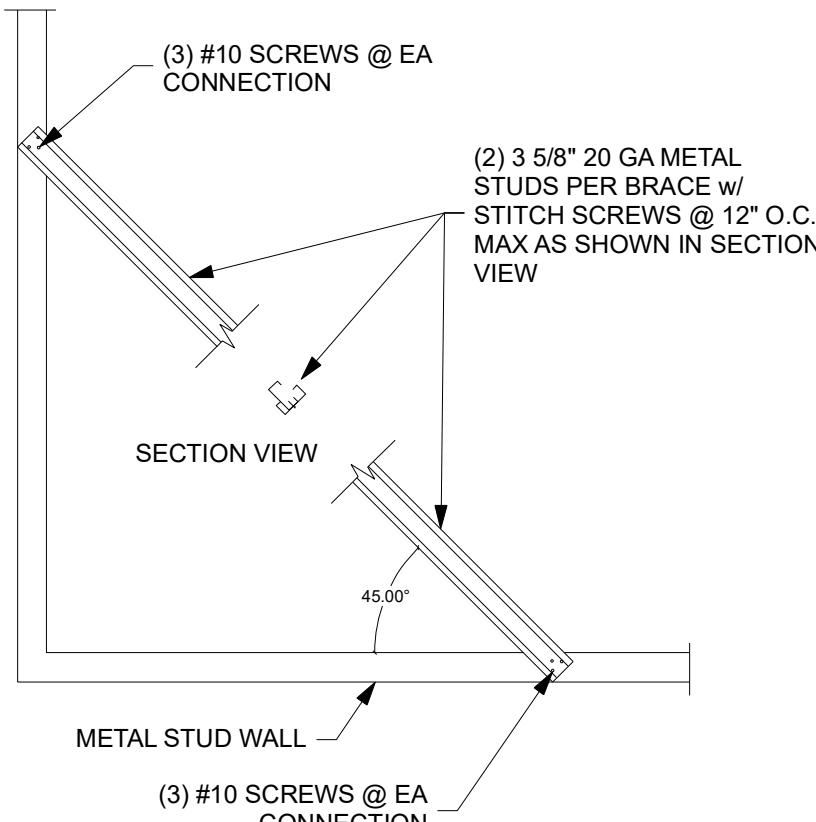


LIGHT GAUGE FRAMING

Scale: 1/2" = 1'-0"

2

METAL TO METAL FASTENER SIZE	
METAL THICKNESS "T"	SCREW TYPE
T < 12 GA	#10 W/ #3 POINT
12 GA < T < 3/16"	#12 W/ #3 POINT
3/16" < T < 5/16"	1/4" DIA. W/ #4 POINT

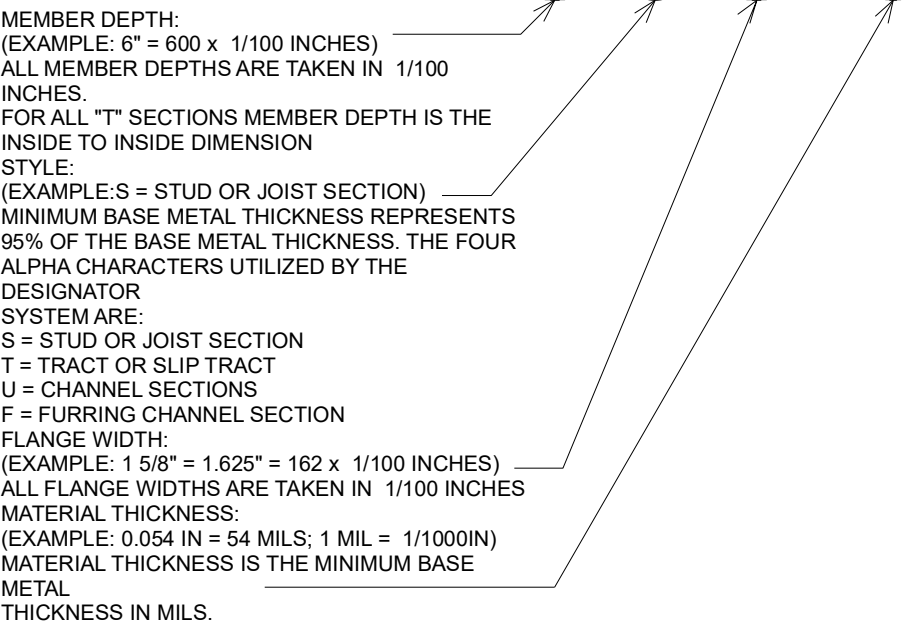

LIGHT GAUGE STEEL NOTES

- ALL MEMBERS SHALL BE MANUFACTURED BY A CURRENT MEMBER OF THE STEEL STUD MANUFACTURERS ASSOCIATION, IN ACCORDANCE WITH THE LATEST AMERICAN IRON AND STEEL INSTITUTE - NORTH AMERICAN SPECIFICATION FOR THE DESIGN OF COLD-FORMED STEEL STRUCTURAL MEMBERS INCLUDING THE LATEST SUPPLEMENTS (AISI-NAS).
- ALL GALVANIZED STUDS, TRACKS AND JOISTS SHALL BE FORMED FROM STEEL THAT CORRESPONDS TO THE MINIMUM REQUIREMENTS OF THE LATEST AISI-NAS STANDARD.
- ALL STEEL MEMBERS SHALL HAVE PHYSICAL MARKING AND IDENTIFICATION NUMBERS AS REQUIRED BY ASTM C645 AND ASTM C955. THESE MARKINGS MUST INCLUDE, BUT ARE NOT LIMITED TO, THE FOLLOWING INFORMATION: DEPTH, FLANGE WIDTH, MINIMUM STEEL THICKNESS, MANUFACTURER DESIGNATION, STEEL YIELD STRENGTH AND PROTECTIVE COATING WEIGHT.
- STRUCTURAL STEEL FRAMING MEMBERS MUST MEET THE PHYSICAL REQUIREMENTS OF ASTM C955. THE INSTALLATION REQUIREMENTS OF ASTM C1007 AND THE MINIMUM COATING REQUIREMENTS OF ASTM A653 COATING DESIGNATION G-60.
- NON-STRUCTURAL STEEL FRAMING MEMBERS MUST MEET THE PHYSICAL REQUIREMENTS OF ASTM C245. THE INSTALLATION REQUIREMENTS OF ASTM C754 AND THE MINIMUM COATING REQUIREMENTS OF ASTM A653 COATING DESIGNATION G-40.
- STEEL SHALL BE ASTM A1003, GRADE 50 FOR 12, 14, AND 16 GAUGE SECTIONS, AND ASTM A1003, GRADE 33 FOR 18 AND HIGHER GAUGE SECTIONS.
- PROVIDE STEEL MEMBERS WITH SECTION PROPERTIES EQUAL TO OR GREATER THAN THOSE SPECIFIED BY THE "STEEL STUD MANUFACTURERS ASSOCIATION" (SSMA) CATALOG, ICBO-ER 4943P, FOR THE MEMBER SIZES DESIGNATED ON THE PLANS.
- THE CONTRACTOR MUST PROVIDE A MATERIAL SUBMITTAL INDICATING THE SIZE, GAUGE, SECTIONAL PROPERTIES AND MATERIALS TO BE USED TO THE ARCHITECT AND ENGINEER FOR APPROVAL PRIOR TO CONSTRUCTION. IN ACCORDANCE WITH THE SPECIFICATIONS, CONTRACTOR SHALL BE RESPONSIBLE FOR OBTAINING AGENCY APPROVAL FOR ANY SUBSTITUTIONS.
- BENT, KINKED, DISTORTED, CORRODED OR DAMAGED SECTIONS SHALL NOT BE USED.
- STUDS MAY HAVE CUTOUTS (OR KNOCKOUTS). CUTOUTS MAY BE A MAXIMUM DIMENSION OF 1/2" WIDE x 4" LONG AND HAVE A MINIMUM SPACING OF 24" O.C. EXCEPT CUTOUTS FOR 1 5/8" AND 2 1/2" MUST NOT EXCEED A WIDTH OF 3/4". CUTOUTS SHALL NOT BE CLOSER THAN 12" FROM MEMBER ENDS.
- ALL WELDING TO BE PERFORMED BY LIGHT GAUGE WELDERS CERTIFIED FOR ALL APPROPRIATE DIRECTIONS COMPLYING WITH A.W.S. D1.3. WELDING RODS SHALL CONFORM TO THE FOLLOWING:
 - 11.1. 18 GA. AND LIGHTER: E60XX
 - 11.2. 16 GA. AND HEAVIER: E70XX OR E6013
 - 11.3. LIGHT GAUGE TO STRUCTURAL STEEL: E70XX LOW HYDROGEN
- ALL WELDS OF GALVANIZED STEEL SHALL BE TOUCHED UP WITH A ZINC RICH PAINT. ALL WELDS OF CARBON SHEET STEEL SHALL BE TOUCHED UP WITH PAINT.
- WIRE TYING OF COMPONENTS SHALL NOT BE PERMITTED.
- LATERAL BRIDGING FOR STEEL STUD IS REQUIRED WHEN WALL BOARD, INSTALLED IN ACCORDANCE WITH AISI-NAS REQUIREMENTS, DOES NOT CONTINUE FULL HEIGHT ON BOTH SIDES. BRIDGING SHALL BE INSTALLED IN ACCORDANCE WITH MANUFACTURER'S RECOMMENDATIONS AND TYPICAL BRIDGING DETAILS. ALL EXTERIOR WALLS SHALL HAVE BRIDGING PER TYPICAL BRIDGING DETAILS.
- SCREWS SHALL BE SELF-DRILLING/SELF-TAPPING STEEL SCREWS INSTALLED IN ACCORDANCE WITH THE AISI-NAS SCREWS SHALL HAVE SUFFICIENT LENGTH TO ENSURE A MINIMUM OF 3 FULL THREADS SHOWING AFTER PENETRATION OF JOINED LIGHT GAUGE MATERIALS. SCREWS SHALL HAVE A MINIMUM OF 1" EDGE SPACING DISTANCE. THE MINIMUM SCREW HEAD DIAMETER SHALL BE 5/16", AND SCREW SIZES SHALL CONFORM TO THE FOLLOWING: U.N.O.
- LIGHT GAUGE STEEL CONTRACTOR SHALL PROVIDE ALL ACCESSORIES INCLUDING, BUT NOT LIMITED TO, TRACTS, CLIPS, WEB STIFFENERS, ANCHORS, FASTENING DEVICES AND OTHER ACCESSORIES REQUIRED FOR A COMPLETE AND PROPER INSTALLATION, AND AS RECOMMENDED BY THE MANUFACTURER FOR THE STEEL MEMBERS BEING USED.
- STEEL TRACTS THAT OCCUR UNDER ALL EXTERIOR CURTAIN WALLS, BEARING WALLS AND SHEAR WALLS SHALL BE BOLTED TO MASONRY OR CONCRETE WITH 5/8" DIA. x 12" BOLTS SPACED NOT MORE THAN 5'-0" O.C. WITH A MIN. OF 2 BOLTS FOR EACH PIECE OF TRACK. U.N.O. USE STANDARD STEEL PLATE WASHERS AT EACH BOLT LOCATION.
- ALL ANCHOR BOLTS IN STEEL TRACKS SHALL BE 4 INCH MINIMUM AND 12 INCH MAXIMUM FROM THE END OF THE TRACK AND HAVE 7 INCH MINIMUM EMBEDMENT INTO CONCRETE OR MASONRY. ANY LOCATION WHERE A HOLE OR NOTCH OCCURS THROUGH A TRACK FLANGE, TRACK SHALL HAVE AN ADDITIONAL ANCHOR BOLT PLACED 4 INCHES TO 12 INCHES ON EACH SIDE OF THE HOLE OR NOTCH.
- ALL ANCHOR BOLTS SHALL BE MACHINE MADE TYPE F1554 GRADE 36 U.N.O. BOLTS WITH UPSET THREADS ARE NOT PERMITTED.
- ALL STEEL FRAMING MEMBERS SHALL BE DESIGNATED ON PLANS WITH THE SSMA STUD AND TRACK SECTION NOMENCLATURE AS DESCRIBED BELOW.

REVISIONS

PROJECT CONTACT:
Ryan Shultz, MSHCA
Executive Director
(661) 765-7234 Office
(661) 203-5757 Cell
rshultz@wshcd.org

PROJECT ADDRESS:
Westside Health Care District
100 E. North Street
Taft, CA. 93268

MECHANICAL, ELECTRICAL & PLUMBING PLANS:
Cantelmi Engineering, Inc.
Frank Cantelmi, PE
2130 F St., Bakersfield, CA 93301
cantelmi@cantelmi.net (661) 324-5252

PRINCIPAL ENGINEER
Darren E. Strong, PE
STRONG
ENGINEERING & DESIGN
1400 Eaton Drive, Suite 228
Bakersfield, CA 93309
(805) 340-4300
strong@strong-engineering.com

SHEET
S-1
OF 20 SHEETS
DATE: 5/19/2025



STATE OF CALIFORNIA

Indoor Lighting

CERTIFICATE OF COMPLIANCE

Project Name:

Report Page:

Date Prepared:

NRCC-LTH-E
(Page 3 of 7)

1/16/2025

CA Building Energy Efficiency Standards - 2022 Nonresidential Compliance

Report Version: 2022.0.000

Schema Version: rev 20220101

Documentation Software: EnergyPro

Compliance ID: EnergyPro-2545-0125-6682

Report Generated: 2025-01-16 10:30:33

F. INDOOR LIGHTING FIXTURE SCHEDULE

This table includes all planned permanent and portable lighting other than dwelling unit/ hotel/ motel room lighting. Multifamily dwelling unit and hotel/motel room lighting is documented in Table I. If using Table T to document lighting in multifamily common use areas providing shared provisions for living, eating, cooking or sanitation, those luminaires are not included here.

Designed Wattage: Conditioned Spaces

01	02	03	04	05	06	07	08	09	10
Name or Item Tag	Complete Luminaire Description	Modular (Track) Fixture	Small Aperture & Color Change¹	Watts per luminaire²	How is Wattage determined	Total Number of Luminaires	Excluded per 140.6(a)3 / 170.2(e)2C	Design Watts	Field Inspector
7	2X4 LED	No	NA	51	Mfr. Spec	4	No	204	Pass
Total Designed Watts: CONDITIONED SPACES								204	

¹FOOTNOTE: Design Watts for small aperture and color changing luminaires which qualify per 140.6(a)8 / 170.2(e)2D is adjusted to be 75%/80% of their rated wattage. Table F automatically makes this adjustment, the permit applicant should enter full rated wattage in column 05.

²Authority Having Jurisdiction may ask for Luminaire cut sheets to confirm wattage used for compliance per 130.0(c) / 160.5(b). Wattage used must be the maximum rated for the luminaire, not the lamp.

G. MODULAR LIGHTING SYSTEMS

This section does not apply to this project.

H. INDOOR LIGHTING CONTROLS (Not including PAFs)

This table includes lighting controls for conditioned and unconditioned spaces.

Building Level Controls

01	02	03
		Field Inspector
Mandatory Demand Response 110.12(c)	Shut-off controls 130.1(c) / 160.5(b)4C	Pass
Required >= 4,000W subject to multilevel	Whole Building Auto Time Switch	

I. LIGHTING POWER ALLOWANCE: COMPLETE BUILDING OR AREA CATEGORY METHODS

Each area complying using the Complete Building or Area Category Methods per 140.6(b) are included in this table. Column 06 indicates if additional lighting power allowances per 140.6(c) or adjustments per 140.6(a) are being used.

Conditioned Spaces

04	05	06	07	08	09	10	11	12
Area Description	Complete Building or Area Category Primary Function Area	Manual Area Controls 130.1(a) / 160.5(b)4A	Multi-Level Controls 130.1(b) / 160.5(b)4B	Shut-Off Controls 130.1(c) // 160.5(b)4C	Primary/Sky lit Daylighting 130.1(d) / 160.5(b)4D	Secondary Daylighting 130.1(d) / 160.5(b)4D	Interlocked Systems 140.6(a)1/ 170.2(e)2A	Field Inspector
Whole Building	All Other Space Types	Readily Accessible	Dimmer	See Building Level	Included	Included	No	Pass
13								
Plan Sheet Showing Daylit Zones:								

J. ADDITIONAL ALLOWANCE: AREA CATEGORY METHOD QUALIFYING LIGHTING SYSTEM

This section does not apply to this project.

K. TAILORED METHOD GENERAL LIGHTING POWER ALLOWANCE

This section does not apply to this project.

L. ADDITIONAL LIGHTING ALLOWANCE: TAILORED WALL DISPLAY

This section does not apply to this project.

M. ADDITIONAL LIGHTING ALLOWANCE: TAILORED FLOOR AND TASK LIGHTING

This section does not apply to this project.

N. ADDITIONAL LIGHTING ALLOWANCE: TAILORED DECORATIVE /SPECIAL EFFECTS

This section does not apply to this project.

O. ADDITIONAL LIGHTING ALLOWANCE: TAILORED VERY VALUABLE MERCHANDISE

This section does not apply to this project.

P. POWER ADJUSTMENT: LIGHTING CONTROL CREDIT (POWER ADJUSTMENT FACTOR (PAF))

This section does not apply to this project.

Q. RATED POWER REDUCTION COMPLIANCE FOR ONE-FOUR ONE ALTERATIONS

This section does not apply to this project.

R. 80% LIGHTING POWER FOR ALL ALTERATIONS - CONTROLS EXCEPTIONS

This section does not apply to this project.

STATE OF CALIFORNIA

Indoor Lighting

CERTIFICATE OF COMPLIANCE

Project Name:

Report Page:

Page 6 of 7

Project Address:

Date Prepared:

1/16/2025

S. DAYLIGHT DESIGN POWER ADJUSTMENT FACTOR (PAF)

This section does not apply to this project.

T. DWELLING UNIT LIGHTING

This section does not apply to this project.

U. DECLARATION OF REQUIRED CERTIFICATES OF INSTALLATION

Selections have been made based on information provided in this document. If any selections have been changed by the permit applicant, an explanation should be included in Table E. Additional Remarks. These documents must be provided to the building inspector during construction and can be found online

Form/Title

Systems/Spaces To Be Field Verified

NRCI-LTI-E - Must be submitted for all buildings

Whole Building Time Switch;

Whole Building;

Whole Building Demand Response;

V. DECLARATION OF REQUIRED CERTIFICATES OF ACCEPTANCE

Selections have been made based on information provided in this document. If any selections have been changed by the permit applicant, an explanation should be included in Table E. Additional Remarks. These documents must be provided to the building inspector during construction and any with "A" in the form name must be completed through an Acceptance Test Technician Certification Provider (ATTCP). For more information visit: <http://www.energy.ca.gov/tltc24/attcp/providers.html>

Form/Title

Systems/Spaces To Be Field Verified

NRCA-LTI-02-A - Must be submitted for occupancy sensors and automatic time switch controls.

Whole Building Time Switch;

NRCA-LTI-03-A - Must be submitted for automatic daylight controls.

Whole Building;

NRCA-LTI-04-A - Must be submitted for demand responsive lighting controls.

Whole Building Demand Response;

STATE OF CALIFORNIA

Indoor Lighting

CERTIFICATE OF COMPLIANCE

Project Name:

Report Page:

Page 7 of 7

Project Address:

Date Prepared:

1/16/2025

DOCUMENTATION AUTHOR'S DECLARATION STATEMENT

I certify that this Certificate of Compliance documentation is accurate and complete.

Documentation Author Name:

Documentation Author Signature:

Company:

Signature Date:

Address:

CSA/HERS Certification Identification (if applicable):

City/State/Zip:

Phone:

RESPONSIBLE PERSON'S DECLARATION STATEMENT

I certify the following under penalty of perjury, under the laws of the State of California:

1. The information provided on this Certificate of Compliance is true and correct;

2. I am eligible under Division 3 of the Business and Professions Code to accept responsibility for the building design or system design identified on this Certificate of Compliance (responsible designer);

3. The energy features and performance specifications, materials, components, and manufactured devices for the building design or system design identified on this Certificate of Compliance conform to the requirements of Title 24, Part 1 and Part 6 of the California Code of Regulations;

4. The building design features or system design features identified on this Certificate of Compliance are consistent with the information provided on other applicable compliance documents, worksheets, calculations, plans and specifications submitted to the enforcement agency for approval with this building permit application;

5. I will ensure that a completed signed copy of this Certificate of Compliance shall be made available with the building permit(s) issued for the building, and made available to the enforcement agency for all applicable inspections. I understand that a completed signed copy of this Certificate of Compliance is required to be included with the documentation the builder provides to the building owner at occupancy.

Responsible Designer Name:

Responsible Designer Signature:

Company:

Date Signed:

Address:

License:

City/State/Zip:

Phone:

CA Building Energy Efficiency Standards - 2022 Nonresidential Compliance

Report Version: 2022.0.000

Schema Version: rev 20220101

Documentation Software: EnergyPro

Compliance ID: EnergyPro-2545-0125-6682

Report Generated: 2025-01-16 10:30:33

STATE OF CALIFORNIA

Mechanical Systems

CERTIFICATE OF COMPLIANCE

Project Name:

Report Page:

Page 1 of 9

Project Address:

Date Prepared:

1/16/2025

A. GENERAL INFORMATION

01 Project Location (city)

04 Total Conditioned Floor Area

441

02 Climate Zone

05 Total Unconditioned Floor Area

0

03 Occupancy Types Within Project:

06 # of Stories (Habitable Above Grade)

1

● Healthcare Facility

● Office

B. PROJECT SCOPE

This table includes mechanical systems or components that are within the scope of the permit application and are demonstrating compliance using the prescriptive path outlined in 140.4, 170.2(b) or 141.0(b)(2) and 180.2(b)(2) for alterations.

01

02

03

Air System(s)

Wet System Components

Dry System Components

☐ Heating Air System

☐ Water Economizer

☐ Air Economizer

☐ Cooling Air System

☐ Pumps

☐ Electric Resistance Heat

Mechanical Controls

System Piping

Fan Systems

☒ Mechanical Controls (existing to remain, altered or new)

☐ Cooling Towers

☒ Ductwork (existing to remain, altered or new)

☐ Chillers

☒ Ventilation

☐ Boilers

☐ Zonal Systems/ Terminal Boxes

ALERT! Healthcare facilities must be ventilated in accordance with Chapter 4 of the CMC as amended by OSHPD and do not need to show compliance with Title 24, Part 6 ventilation requirements in Table J.

CA Building Energy Efficiency Standards - 2022 Nonresidential Compliance

Report Version: 2022.0.000

Schema Version: rev 20220101

Documentation Software: EnergyPro

Compliance ID: EnergyPro-2545-0125-6681

Report Generated: 2025-01-16 10:30:33

STATE OF CALIFORNIA

Mechanical Systems

CALIFORNIA ENERGY COMMISSION

CERTIFICATE OF COMPLIANCE

Report Page: NRCC-MCH-4

Project Name: (Page 2 of 9)

Date Prepared: 1/16/2025

C. COMPLIANCE RESULTS

Table C will indicate if the project data input into the compliance document is compliant with mechanical requirements. This table is not editable by the user. If this table says "DOES NOT COMPLY" or "COMPLIES with Exceptional Conditions" refer to Table D., or the table indicated as not compliant for guidance.

01	02	03	04	05	06	07	08	09
System Summary 110.1, 110.2, 140.4, 170.2(c)	AND Pumps 140.4(k), 170.2(c)4f	AND Fans/ Economizers 140.4(c), 140.4(e), 170.2(c)	AND System Controls 110.2, 120.2, 140.4(f), 170.2(c)	AND Ventilation 120.1, 160.2	AND Terminal Box Controls 140.4(d), 170.2(c)4B	AND Distribution 120.3, 140.4(f), 160.2, 160.3	AND Cooling Towers 110.2(e)2	Compliance Results
(See Table F)	(See Table G)	(See Table H)	(See Table I)	(See Table J)	(See Table K)	(See Table L)	(See Table M)	
AND	AND	AND	Yes	AND	AND	AND	Yes	AND
Mandatory Measures Compliance (See Table Q for Details)								COMPLIES

D. EXCEPTIONAL CONDITIONS

This table is auto-filled with uneditable comments because of selections made or data entered in tables throughout the form.

E. ADDITIONAL REMARKS

This table includes remarks made by the permit applicant to the Authority Having Jurisdiction.

F. HVAC SYSTEM SUMMARY (DRY & WET SYSTEMS)

This section does not apply to this project.

G. PUMPS

This section does not apply to this project.

Generated Date/Time: Documentation Software: EnergyPro

CA Building Energy Efficiency Standards - 2022 Nonresidential Compliance Report Version: 2022.0.000 Schema Version: rev 20220101 Compliance ID: EnergyPro-2545-0125-6681 Report Generated: 2025-01-16 10:30:33

STATE OF CALIFORNIA

Mechanical Systems

CALIFORNIA ENERGY COMMISSION

CERTIFICATE OF COMPLIANCE

Report Page: NRCC-MCH-4

Project Name: (Page 3 of 9)

Date Prepared: 1/16/2025

H. FAN SYSTEMS & AIR ECONOMIZERS

This section does not apply to this project.

I. SYSTEM CONTROLS

This table is used to demonstrate compliance with mandatory controls in 110.2 and 120.2 and prescriptive controls in 140.4(f) and (n), 170.2(c)4D 170.2(c)4L or requirements in 141.0(b)2E 180.2(b)2 for altered space conditioning systems.

01	02	03	04	05	06	07	08	09
System Name	System Zoning	Conditioned Floor Area Being Served (ft²)	Thermostats 110.2(b) & (c)¹, 120.2(a) 160.3(a)2A or 141.0(b)2E & 180.2(b)2	Shut-Off Controls 120.2(e) & 160.3(a)2D	Isolation Zone Controls 120.2(g) & 160.3(a)2F	Demand Response 110.12 120.2(b) & 160.3(a)2B	Supply Air Temp. Reset 140.4(f) & 170.2(c)4D	Window Interlocks per 140.4(n) & 170.2(c)4D

¹FOOTNOTES: Gravity gas wall heaters, gravity floor heaters, gravity room heaters, non-central electric heaters, fireplaces or decorative gas appliances, wood stoves are not required to have setback thermostats.

J. VENTILATION AND INDOOR AIR QUALITY

This table is used to demonstrate compliance with mandatory ventilation requirements in 120.1 120.2(e)3B 140.4(a) and 140.4(a) for all nonresidential and hotel/motel and 141.0(d)4(f)150.2 160.3(a)3D, 170.2(a)4N, 170.2(a)4D for high-rise residential occupancies. For alterations, only ventilation systems being altered within the scope of the permit application need to be documented in this table. In lieu of this table, the required outdoor ventilation rates and airflow may be shown on the plans or the calculations can be presented in a spreadsheet.

01	<input type="checkbox"/>	Check the box if the project is showing ventilation calculations on the plans, or attaching the calculations instead of completing this table.
02	<input checked="" type="checkbox"/>	Check this box if the project included Nonresidential, Hotel/Motel Spaces or Multifamily Common Use Spaces
03	<input type="checkbox"/>	
04	<input type="checkbox"/>	Check the box if the project is using natural ventilation in any nonresidential or hotel/motel spaces to meet required ventilation rates per 120.1(c)2.

Nonresidential and Hotel/Motel Multifamily Common Use Ventilation Systems

04	05	06	07
System Name	EX AC 1 System	System Design OA CFM Airflow¹	40
08	09	10	11
12	13	14	15
			16

Generated Date/Time: Documentation Software: EnergyPro

CA Building Energy Efficiency Standards - 2022 Nonresidential Compliance Report Version: 2022.0.000 Schema Version: rev 20220101 Compliance ID: EnergyPro-2545-0125-6681 Report Generated: 2025-01-16 10:30:33

STATE OF CALIFORNIA

Mechanical Systems

CALIFORNIA ENERGY COMMISSION

CERTIFICATE OF COMPLIANCE

Report Page: NRCC-MCH-4

Project Name: (Page 4 of 9)

Date Prepared: 1/16/2025

J. VENTILATION AND INDOOR AIR QUALITY

Space Name or Item Tag	Mechanical Ventilation Required per 120.1(c)3³ & 160.2(c)3				Exh. Vent per 120.1(c)4 & 160.2(c)4		DCV or Sensor Controls per 120.1(d)3, 120.1(d)5, and 120.1(e)3¹ 160.2(c)3D 160.2(c)5E 160.2(c)5D	
	Occupancy Type¹	Conditioned Floor Area (ft²)	# of Shower heads/ toilets	# of people¹	Required Min OA CFM	Required Min CFM	Provided per Design CFM	
Zone 1	All others	270			40.5	0	0	DCV Provided per §120.1(d)4
17	Total System Required Min OA CFM				40	18	Ventilation for this System Completes? Yes	

04050607

System Name	EX AC2	System Design OA CFM Airflow¹	26	System Design Transfer Air CFM	0	Air Filtration per 120.1(c) 141.0(b)2 and 160.2(c)21²		
08	09	10	11	12	13	14	15	16
						Provide		

Space Name or Item TagOccupancy Type¹Conditioned Floor Area (ft²)# of Shower heads/ toilets# of people¹Required Min OA CFMRequired Min CFMProvided per Design CFM

Zone	Office space	171			25.6	0	0	DCV Provided per §120.1(d)4
17	Total System Required Min OA CFM				26	18	Ventilation for this System Completes? Yes	

¹ FOOTNOTES: System CFM should include both mechanical and natural ventilation for the zone/system
² Air Filtration requirements apply to the following three system types per 120.1(c)1A: space conditioning systems utilizing ducts to supply air to occupiable space; supply-only ventilation systems providing outside air to occupiable space; supply side of balanced ventilation systems including heat recovery and energy recovery ventilation systems providing outside air to occupiable space.
³ Uniform Mechanical Code may have more stringent ventilation requirements; the most stringent code requirement takes precedence.

Generated Date/Time: Documentation Software: EnergyPro

CA Building Energy Efficiency Standards - 2022 Nonresidential Compliance Report Version: 2022.0.000 Schema Version: rev 20220101 Compliance ID: EnergyPro-2545-0125-6681 Report Generated: 2025-01-16 10:30:33

THESE DRAWINGS ARE THE PROPERTY OF CANTELMI ENGINEERING. NO PART OF THESE DRAWINGS SHALL BE REPRODUCED, COPIED, OR TRANSMITTED IN ANY FORM OR BY ANY MEANS, WITHOUT THE WRITTEN PERMISSION OF CANTELMI ENGINEERING. ANY VIOLATION OF THIS NOTICE SHALL BE CONSIDERED A VIOLATION OF THE BUILDING CODES AND/OR RESTRICTIONS. THE CONTRACTOR SHALL BE RESPONSIBLE FOR OBTAINING ALL NECESSARY PERMITS AND APPROVALS PRIOR TO CONSTRUCTION. THE CONTRACTOR SHALL BE RESPONSIBLE FOR OBTAINING ALL NECESSARY PERMITS AND APPROVALS PRIOR TO CONSTRUCTION. THE CONTRACTOR SHALL BE RESPONSIBLE FOR OBTAINING ALL NECESSARY PERMITS AND APPROVALS PRIOR TO CONSTRUCTION.

STATE OF CALIFORNIA
Mechanical Systems
CERTIFICATE OF COMPLIANCE
Project Name: Report Page: NRCC-MCH-E (Page 5 of 9)
Date Prepared: 1/16/2025

CALIFORNIA ENERGY COMMISSION

J. VENTILATION AND INDOOR AIR QUALITY
See Standards Tables 120.1-A and 120.1-B.
For lecture halls with fixed seating, the expected number of occupants shall be determined in accordance with the California Building Code.
120.2(e)3 requires systems serving rooms that are required by 130.1(c) to have lighting occupancy sensing controls to also have occupancy sensing zone controls for ventilation.
Examples of spaces which require lighting occupancy sensors include offices 250ft² or smaller, multipurpose rooms less than 1,000 ft², classrooms, conference rooms, restrooms, aisles and open areas in warehouses, library book stack aisles, corridors, stairwells, parking garages, and loading and unloading zones, unless excepted by 130.1(c).

K. TERMINAL BOX CONTROLS
This section does not apply to this project.

L. DISTRIBUTION (DUCTWORK and PIPING)
This table is used to show compliance with mandatory pipe insulation requirements found in 120.3 and mandatory requirements found in 120.4(g) for duct sealing.
01 Insulation shall be protected from damage, including that due to sunlight, moisture, equipment maintenance, and wind. Insulation exposed to weather shall be installed with a cover suitable for outdoor service. Insulation covering chilled water piping and refrigerant suction piping located outside the conditioned space shall have a Class I or Class II vapor retarder. All penetrations and joints of which shall be sealed.
Duct Leakage Testing
The answers to the questions below apply to the following duct systems: EX AC 1 System NR/ Common Use: Duct leakage testing shall not exceed 6% per NA7.5.3 required for these systems? No
Generated Date/Time: Documentation Software: EnergyPro
CA Building Energy Efficiency Standards - 2022 Nonresidential Compliance Report Version: 2022.0.000 Compliance ID: EnergyPro-2545-0125-6681 Schema Version: rev 20220101 Report Generated: 2025-01-16 10:30:33

STATE OF CALIFORNIA
Mechanical Systems
CERTIFICATE OF COMPLIANCE
Project Name: Report Page: NRCC-MCH-E (Page 6 of 9)
Date Prepared: 1/16/2025

CALIFORNIA ENERGY COMMISSION

L. DISTRIBUTION (DUCTWORK and PIPING)
Dwelling Units: Total duct leakage of duct system shall not exceed 12% or duct system to outside shall not exceed 6% per RA3.1.4 required for systems? No
Duct leakage testing per CMC Section 603.10.1 required for these systems? Yes
11 No The scope of the project includes only duct systems serving healthcare facilities
12 Yes Duct system provides conditioned air to an occupiable space for a constant volume, single zone, space-conditioning system.
13 Yes The space conditioning system serves less than 5,000 ft² of conditioned floor area.
14 No The combined surface area of the ducts is more than 25% of the total surface area of the entire duct system:
15 The scope of the project includes extending an existing duct system, which is constructed, insulated or sealed with asbestos.
16 No The scope of the project includes an existing duct system that is documented to have been previously sealed as confirmed through field verification and diagnostic testing in accordance with procedures in the Reference Nonresidential Appendix NA2.
17 All Ductwork and plenums with pressure class ratings shall be constructed to Seal Class A
18 All ductwork is an extension of an existing duct system
19 Ductwork serving individual dwelling unit
20 < 25 ft of new or replacement space conditioning ducts installed
21 R-8 Duct Insulation R-value
22
23
The answers to the questions below apply to the following duct systems: EX AC2 NR/ Common Use: Duct leakage testing shall not exceed 6% per NA7.5.3 required for these systems? No
Generated Date/Time: Documentation Software: EnergyPro
CA Building Energy Efficiency Standards - 2022 Nonresidential Compliance Report Version: 2022.0.000 Compliance ID: EnergyPro-2545-0125-6681 Schema Version: rev 20220101 Report Generated: 2025-01-16 10:30:33

STATE OF CALIFORNIA
Mechanical Systems
CERTIFICATE OF COMPLIANCE
Project Name: Report Page: NRCC-MCH-E (Page 7 of 9)
Date Prepared: 1/16/2025

CALIFORNIA ENERGY COMMISSION

L. DISTRIBUTION (DUCTWORK and PIPING)
Dwelling Units: Total duct leakage of duct system shall not exceed 12% or duct system to outside shall not exceed 6% per RA3.1.4 required for systems? No
Duct leakage testing per CMC Section 603.10.1 required for these systems? Yes
11 No The scope of the project includes only duct systems serving healthcare facilities
12 Yes Duct system provides conditioned air to an occupiable space for a constant volume, single zone, space-conditioning system.
13 Yes The space conditioning system serves less than 5,000 ft² of conditioned floor area.
14 No The combined surface area of the ducts is more than 25% of the total surface area of the entire duct system:
15 The scope of the project includes extending an existing duct system, which is constructed, insulated or sealed with asbestos.
16 No The scope of the project includes an existing duct system that is documented to have been previously sealed as confirmed through field verification and diagnostic testing in accordance with procedures in the Reference Nonresidential Appendix NA2.
17 All Ductwork and plenums with pressure class ratings shall be constructed to Seal Class A
18 All ductwork is an extension of an existing duct system
19 Ductwork serving individual dwelling unit
20 < 25 ft of new or replacement space conditioning ducts installed
21 R-8 Duct Insulation R-value
22
23
The answers to the questions below apply to the following duct systems: EX AC2 NR/ Common Use: Duct leakage testing shall not exceed 6% per NA7.5.3 required for these systems? No
Generated Date/Time: Documentation Software: EnergyPro
CA Building Energy Efficiency Standards - 2022 Nonresidential Compliance Report Version: 2022.0.000 Compliance ID: EnergyPro-2545-0125-6681 Schema Version: rev 20220101 Report Generated: 2025-01-16 10:30:33

STATE OF CALIFORNIA
Mechanical Systems
CERTIFICATE OF COMPLIANCE
Project Name: Report Page: NRCC-MCH-E (Page 8 of 9)
Date Prepared: 1/16/2025

CALIFORNIA ENERGY COMMISSION

N. DECLARATION OF REQUIRED CERTIFICATES OF INSTALLATION
Selections have been made based on information provided in previous tables of this document. If any selection needs to be changed, please explain why in Table E Additional Remarks.
These documents must be provided to the building inspector during construction and can be found online at https://www.energy.ca.gov/title24/2019standards/2019_compliance_documents/Nonresidential_Documents/NRCL/
Form/Title
NRCC-MCH-01-E - Must be submitted for all buildings
O. DECLARATION OF REQUIRED CERTIFICATES OF ACCEPTANCE
There are no NRCA forms required for this project.
P. DECLARATION OF REQUIRED CERTIFICATES OF VERIFICATION
There are no NRCC forms required for this project.
Q. MANDATORY MEASURES DOCUMENTATION LOCATION
This table is used to indicate where mandatory measures are documented in the plan set or construction documentation.
01 Compliance with Mandatory Measures documented through MCH
02 Yes Plan sheet or construction document location
M-Sheets
Generated Date/Time: Documentation Software: EnergyPro
CA Building Energy Efficiency Standards - 2022 Nonresidential Compliance Report Version: 2022.0.000 Compliance ID: EnergyPro-2545-0125-6681 Schema Version: rev 20220101 Report Generated: 2025-01-16 10:30:33

STATE OF CALIFORNIA
Mechanical Systems
CERTIFICATE OF COMPLIANCE
Project Name: Report Page: NRCC-MCH-E (Page 9 of 9)
Date Prepared: 1/16/2025

CALIFORNIA ENERGY COMMISSION

DOCUMENTATION AUTHOR'S DECLARATION STATEMENT
I certify that this Certificate of Compliance documentation is accurate and complete.
Documentation Author Name: Frank Cantelmi Mechanical Engineering
Signature Date: 2025-01-16
Address: 1300 F STREET BAKERSFIELD, CA 93301
City/State/Zip: TEL: (661) 324-3532 FAX: (661) 324-8439 cantelmi@cantelmi.net
RESPONSIBLE PERSON'S DECLARATION STATEMENT
I certify the following under penalty of perjury, under the laws of the State of California:
1. The information provided on this Certificate of Compliance is true and correct.
2. I am eligible under Division 3 of the Business and Professions Code to accept responsibility for the building design or system design identified on this Certificate of Compliance (responsible designer).
3. The energy features and performance specifications, materials, components, and manufactured devices for the building design or system design identified on this Certificate of Compliance conform to the requirements of Title 24, Part 1 and Part 6 of the California Code of Regulations.
4. The building design features or system design features identified on this Certificate of Compliance are consistent with the information provided on other applicable compliance documents, worksheets, calculations, plans and specifications submitted to the enforcement agency for approval with this building permit application.
5. I will ensure that a completed signed copy of this Certificate of Compliance shall be made available with the building permit(s) issued for the building, and made available to the enforcement agency for all applicable inspections. I understand that a completed signed copy of this Certificate of Compliance is required to be included with the documentation the building owner provides to the building owner at occupancy.
Responsible Designer Name: Frank Cantelmi
Signature Date: 2025-01-16
Address: 1300 F STREET BAKERSFIELD, CA 93301
City/State/Zip: TEL: (661) 324-3532 FAX: (661) 324-8439 cantelmi@cantelmi.net
Generated Date/Time: Documentation Software: EnergyPro
CA Building Energy Efficiency Standards - 2022 Nonresidential Compliance Report Version: 2022.0.000 Compliance ID: EnergyPro-2545-0125-6681 Schema Version: rev 20220101 Report Generated: 2025-01-16 10:30:33

STATE OF CALIFORNIA
Mechanical Systems
CERTIFICATE OF COMPLIANCE
Project Name: Report Page: NRCC-MCH-E (Page 8 of 9)
Date Prepared: 1/16/2025

CALIFORNIA ENERGY COMMISSION

N. DECLARATION OF REQUIRED CERTIFICATES OF INSTALLATION
Selections have been made based on information provided in previous tables of this document. If any selection needs to be changed, please explain why in Table E Additional Remarks.
These documents must be provided to the building inspector during construction and can be found online at https://www.energy.ca.gov/title24/2019standards/2019_compliance_documents/Nonresidential_Documents/NRCL/
Form/Title
NRCC-MCH-01-E - Must be submitted for all buildings
O. DECLARATION OF REQUIRED CERTIFICATES OF ACCEPTANCE
There are no NRCA forms required for this project.
P. DECLARATION OF REQUIRED CERTIFICATES OF VERIFICATION
There are no NRCC forms required for this project.
Q. MANDATORY MEASURES DOCUMENTATION LOCATION
This table is used to indicate where mandatory measures are documented in the plan set or construction documentation.
01 Compliance with Mandatory Measures documented through MCH
02 Yes Plan sheet or construction document location
M-Sheets
Generated Date/Time: Documentation Software: EnergyPro
CA Building Energy Efficiency Standards - 2022 Nonresidential Compliance Report Version: 2022.0.000 Compliance ID: EnergyPro-2545-0125-6681 Schema Version: rev 20220101 Report Generated: 2025-01-16 10:30:33

STATE OF CALIFORNIA
Mechanical Systems
CERTIFICATE OF COMPLIANCE
Project Name: Report Page: NRCC-MCH-E (Page 9 of 9)
Date Prepared: 1/16/2025

CALIFORNIA ENERGY COMMISSION

DOCUMENTATION AUTHOR'S DECLARATION STATEMENT
I certify that this Certificate of Compliance documentation is accurate and complete.
Documentation Author Name: Frank Cantelmi Mechanical Engineering
Signature Date: 2025-01-16
Address: 1300 F STREET BAKERSFIELD, CA 93301
City/State/Zip: TEL: (661) 324-3532 FAX: (661) 324-8439 cantelmi@cantelmi.net
RESPONSIBLE PERSON'S DECLARATION STATEMENT
I certify the following under penalty of perjury, under the laws of the State of California:
1. The information provided on this Certificate of Compliance is true and correct.
2. I am eligible under Division 3 of the Business and Professions Code to accept responsibility for the building design or system design identified on this Certificate of Compliance (responsible designer).
3. The energy features and performance specifications, materials, components, and manufactured devices for the building design or system design identified on this Certificate of Compliance conform to the requirements of Title 24, Part 1 and Part 6 of the California Code of Regulations.
4. The building design features or system design features identified on this Certificate of Compliance are consistent with the information provided on other applicable compliance documents, worksheets, calculations, plans and specifications submitted to the enforcement agency for approval with this building permit application.
5. I will ensure that a completed signed copy of this Certificate of Compliance shall be made available with the building permit(s) issued for the building, and made available to the enforcement agency for all applicable inspections. I understand that a completed signed copy of this Certificate of Compliance is required to be included with the documentation the building owner provides to the building owner at occupancy.
Responsible Designer Name: Frank Cantelmi
Signature Date: 2025-01-16
Address: 1300 F STREET BAKERSFIELD, CA 93301
City/State/Zip: TEL: (661) 324-3532 FAX: (661) 324-8439 cantelmi@cantelmi.net
Generated Date/Time: Documentation Software: EnergyPro
CA Building Energy Efficiency Standards - 2022 Nonresidential Compliance Report Version: 2022.0.000 Compliance ID: EnergyPro-2545-0125-6681 Schema Version: rev 20220101 Report Generated: 2025-01-16 10:30:33

STATE OF CALIFORNIA
Indoor Lighting
CERTIFICATE OF COMPLIANCE
Project Name: Report Page: NRCC-LTI-E (Page 1 of 7)
Date Prepared: 1/16/2025

CALIFORNIA ENERGY COMMISSION

A. GENERAL INFORMATION
01 Project Location (city) 04 Total Conditioned Floor Area (ft²) 441
02 Climate Zone 13 05 Total Unconditioned Floor Area (ft²) 0
03 Occupancy Types Within Project (select all that apply): 06 # of Stories (Habitable Above Grade) 1
Healthcare Facility Office
B. PROJECT SCOPE
This table includes any lighting systems that are within the scope of the permit application and are demonstrating compliance using the prescriptive path outlined in 140.6 / 170.2(e) or 141.0(b)2 / 180.2(b)4 for alterations.
Scope of Work Conditioned Spaces Unconditioned Spaces
01 My Project Consists of (check all that apply): 02 Calculation Method 03 Area (ft²) 04 Calculation Method 05 Area (ft²)
New Lighting System Area Category Method 441 Area Category Method 0
New Lighting System - Parking Garage
Total Area of Work (ft²) 441 0
Generated Date/Time: Documentation Software: EnergyPro
CA Building Energy Efficiency Standards - 2022 Nonresidential Compliance Report Version: 2022.0.000 Compliance ID: EnergyPro-2545-0125-6682 Schema Version: rev 20220101 Report Generated: 2025-01-16 10:30:33

STATE OF CALIFORNIA
Indoor Lighting
CERTIFICATE OF COMPLIANCE
Project Name: Report Page: NRCC-LTI-E (Page 2 of 7)
Date Prepared: 1/16/2025

CALIFORNIA ENERGY COMMISSION

C. COMPLIANCE RESULTS
If any cell on this table says "DOES NOT COMPLY" or "COMPLIES with Exceptional Conditions" refer to Table D for guidance.
Lighting in conditioned and unconditioned spaces must not be combined for compliance per 140.6(b)1 / 170.2(e)
01 02 03 04 05 06 07 08 09
Complete Building 140.6(c)1 Area Category 140.6(c)2 / 170.2(e)4 Additional 140.6(c)3 / 170.2(e)4B Tailored 140.6(c)3 / 170.2(e)4B Total Allowed (Watts) Total Adjusted (Watts) Compliance Results
(See Table I) (See Table I) (See Table J) (See Table K) (See Table F) (See Table P)
Conditioned 413.1 0 = 413 ≥ 204 0 = 204 COMPLIES
Unconditioned = = = = = = = = = = COMPLIES
Controls Compliance (See Table H for Details) COMPLIES
Rated Power Reduction Compliance (See Table Q for Details)
D. EXCEPTIONAL CONDITIONS
This table is auto-filled with uneditable comments because of selections made or data entered in tables throughout the form.
E. ADDITIONAL REMARKS
This table includes remarks made by the permit applicant to the Authority Having Jurisdiction.
Generated Date/Time: Documentation Software: EnergyPro
CA Building Energy Efficiency Standards - 2022 Nonresidential Compliance Report Version: 2022.0.000 Compliance ID: EnergyPro-2545-0125-6682 Schema Version: rev 20220101 Report Generated: 2025-01-16 10:30:33

CANTELMI ENGINEERING
MECHANICAL/ELECTRICAL
LICENSE #21160
1300 F STREET BAKERSFIELD, CA 93301
TEL: (661) 324-3532 FAX: (661) 324-8439 cantelmi@cantelmi.net

WEST SIDE FAMILY HEALTH CARE
100 EAST NORTH STREET,
TAF, CA

DATE	ISSUED





















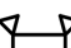


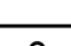


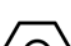







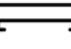








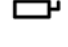

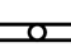

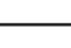
DATE	MARK	ISSUED

DWG. BY	
CHKD BY	
DATE	1/16/2025
JOB NO.	C24-189
FILE NO.	C24-000 T-24.DWG

SHEET
EC.2
SHEET

NOTHING IN THE DRAWINGS AND/OR SPECIFICATIONS SHALL BE CONSTRUED TO PERMIT AN INSTALLATION IN VIOLATION OF APPLICABLE CODES AND/OR RESTRICTIONS. SHOULD ANY CHANGE IN THE DRAWINGS AND/OR SPECIFICATIONS BE NECESSARY IN ORDER TO COMPLY WITH APPLICABLE CODES AND/OR REQUIREMENTS, THE CONTRACTOR SHALL NOTIFY ENGINEER OF RECORD. THE WORK PERFORMED UNDER THIS CONTRACT SHALL BE IN FULL ACCORDANCE WITH THE LATEST CODES, REGULATIONS, RESTRICTIONS AND REQUIREMENTS. CONTRACTOR TO OBTAIN CLARIFICATION FROM ENGINEER OF RECORD WHERE CONFLICTS IN DRAWING OR DIMENSIONS ARISE PRIOR TO PROCEEDING WITH CONSTRUCTION.

FILE: S:\VENDOR\BANKMYER\BANKMYER\WEST_BIKE_FAMILIY HEALTH CARE 224-189\224-189 ELECTRICAL.dwg DATE: 2/11/2025 TIME: 2:11 PM
FOR USE IN THESE CAD AND PLOTTER SETTINGS, THE USER MUST FIRST SET THE PLOTTER AND PLOTTER SETTINGS TO EXPRESSLY LIMITED TO SUCH USE. RE-USE, REPRODUCTION, OR PUBLICATION BY ANY METHOD, IN WHOLE OR IN PART, IS PROHIBITED. TITLE TO THE PLANS AND SPECIFICATIONS REMAINS WITH THE ENGINEER WITHOUT REGARDS. VISUAL CONTACT WITH THESE PLANS AND SPECIFICATIONS SHALL CONSTITUTE A FORMAL ACCEPTANCE OF THESE RESTRICTIONS. CANTELMI ENGINEERING

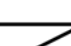SYMBOLS			
LIGHT FIXTURES		POWER/COMM	CONDUIT/WIRE
	CEILING SURFACEMOUNT		SINGLE RECEPT
	WALL SURFACEMOUNT		DUPLEX RECEPT
	PENDANT MOUNT		DUPLEX-HALF SWITCHED
	RECESSED DOWNLIGHT		DOUBLE DUPLEX
	RECESSED WALLWASH		SPECIAL CONFIGURATION
	RECESSED		FLOORMOUNT 208V, 1φ RECEPT
	SURFACE		DUPLEX-FLOOR OUTLET
	STRIP UON		GROUND FAULT CIRCUIT INTERRUPT
	TRACK LIGHT		JUNCTION BOX
	DIRECTIONAL FLOOD		SPECIAL SYSTEM JUNCTION BOX
	EMERGENCY FIXTURE		DATA - J-BOX w/ 3/4°C. TO ATTIC SPACE
	POLE LIGHT		PHONE - J-BOX w/ 3/4°C. TO ATTIC SPACE
	POLE LIGHT-DECORATIVE		PHONE & DATA - J-BOX w/ 3/4°C. TO ATTIC SPACE
	UPLIGHT-FLUSH IN GRADE		(1)RG-6/U CABLE (1)F-CONNECTOR
	BOLLARD		SAFETY DISCONNECT
	TANDEM-WIRED LAMPS		DROP CORD RECEPT
	UNDERCABINET LIGHT		ABOVE-CLGMOUNT J-BOX
	WALL SURFACEMOUNT LINEAR TYPE		TV OUTLET-FLOORMOUNT
	PENDANT LINEAR		TELEPHONE FLOOR OUTLET
	RECESSED WALLMOUNT		DATA FLOOR OUTLET
	WALLPACK		WIRELESS ACCESS POINT IN CEILING
	EMERGENCY WALLPACK		MOUNT DEVICE ABOVE COUNTER PER ARCHITECTURAL REQUIREMENTS
	EXIT LIGHT-WALL		
	EXIT LIGHT-CEILING (ARROW INDICATES DIRECTION)		
	LETTER ADJACENT INDICATES FIXTURE TYPE		
	"E" LETTER ADJACENT INDICATES EMERGENCY FIXTURE TYPE		

ELECTRICAL ABBREVIATIONS											
A	AMPERE	DIA	DIAMETER	GRS	GALVANIZED RIGID STEEL	N3R	NEMA 3R	SQ	SQUARE		
AB	AMP BREAKER	DISC	DISCONNECT	GWS	GANG WITH SWITCH	NC	NORMALLY CLOSED	STR'G	STORAGE		
ABAND	ABANDONED	DIST	DISTRIBUTION	H	HEIGHT, HIGH	NEC	NATIONAL ELECTRICAL CODE	SURF	SURFACE		
ABV	ABOVE	DPST	DOUBLE POLE SINGLE THROW	HACR	HEATING, AC & REFRIG	NEMA	NAT'L ELEC MANUFACTURER'S ASSOC	SVC	SERVICE		
AC	ALTERNATING CURRENT	DW	DISHWASHER	HID	HIGH INTENSITY DISCHARGE	NIC	NOT IN CONTRACT	SW	SWITCH		
AC-#	AIR CONDITIONER	EM	EMERGENCY	HO	HIGH OUTPUT	NL	NIGHT LIGHT	T	TRANSFORMER, TERMINAL		
ADJ	ADJACENT	(E)	EXISTING	HOA	HAND-OFF-AUTO	NO	NORMALLY OPEN	-T-	TELEPHONE CONDUIT		
AF	AMP FUSE, AMP FRAME	EA	EACH	hp	HORSEPOWER	NPF	NORMAL POWER FACTOR	TBR	TO BE REMOVED		
AFF	ABOVE FINISH FLOOR	EB	ELECTRONIC BALLAST	HPF	HIGH POWER FACTOR	NTS	NOT TO SCALE	TC	TIME CLOCK		
AFG	ABOVE FINISH GRADE	EC	ELECTRICAL CONTRACTOR	HPS	HIGH PRESSURE SODIUM	OC	ON CENTER	TEL	TELEPHONE		
AIC	AMPERES INTERRUPTING CAPACITY	EC-#	EVAPORATIVE COOLER	IC	INTERCOM	OCP	OVERCURRENT PROTECTION	TELCO	TELEPHONE COMPANY		
AI	ALUMINUM	EF-#	EXHAUST FAN	ID	IDENTIFICATION	OD	OUTSIDE DIAMETER	TS	TIME SWITCH		
AS	AMP SWITCH RATING	EL	EVENING LIGHT	IF	INSIDE FROST	OH	OVERHEAD	TSD	TIME SWITCH OVERRIDE		
ATS	AUTOMATIC TIME SWITCH	ELEC	ELECTRICAL	IG	ISOLATED GROUND	OSA	OFFICE OF THE STATE ARCHITECT	TSP	TWISTED SHIELDED PAIR		
ATS	AUTOMATIC TRANSFER SWITCH	EM	EMERG BATTERY BACKUP	J-BOX	JUNCTION BOX	OSHPD	OFFICE OF STATEWIDE HEALTH PLANNING & DEVELOPMENT	TTB	TELEPHONE TERMINAL BOARD		
AV	AUDIBLE/AUDIO VISUAL	EMB	EMERGENCY BALLAST	KVA	KILOVOLTAMPS	OVLD	OVERLOAD	TTT	TELEPHONE TERMINAL CABINET		
AWG	AMERICAN WIRE GAGE	EMERG	EMERGENCY	KW	KILOWATT	P	POLE	TX	TRANSFORMER		
BFG	BELOW FINISH GRADE	EOL	END OF LINE	LC	LIGHTING CONTACTOR	PA	PUBLIC ADDRESS	TYP	TYPICAL		
BIL	BASIC IMPULSE LEVEL	EQUIP'T	EQUIPMENT	LPS	LOW PRESSURE SODIUM	PB	PULLBOX	TYP SIM	TYPICAL SIMILAR		
BLDG	BUILDING	ES	ENERGY SAVING	LRA	LOCKED ROTOR AMPS	PC	PULL CHAIN	UC	UNDERCABINET, UNDERCOUNTER		
C	CONDUIT	(EXN)	(E) IN (N) LOCATION	LS	LIFE SAFETY BRANCH	PC	PULL CHAIN	UG	UNDERGROUND		
-C-	CATV CONDUIT	(EXR)	(E) TO BE (R)	LT	LIGHT	PC	PHOTOCELL	UGPS	UNDERGROUND PULL SECTION		
CABT	CABINET	EXT	EXTERIOR	LTG	LIGHTING	ph	PHASE	UL	UNDERWRITERS LABORATORIES		
CATV	CABLE TELEVISION	F	FUTURE	LV	LOW VOLTAGE	PNL	PANEL	UON	UNLESS OTHERWISE NOTED		
CB	CIRCUIT BREAKER, CODE BLUE	F-#	FURNACE	MC	MECHANICAL CONTRACTOR	POC	POINT OF CONNECTION	USA	UG SVC ALERT 800-642-2444		
CBC	CA. BUILDING CODE	FA	FIRE ALARM	MCA	MINIMUM CKT AMPS	-PP-	POWER PRIMARY	V	VOLT		
CEC	CA. ELECTRICAL CODE	FAC	FIRE ALARM CONTROL PANEL	MCB	MAIN CIRCUIT BREAKER	-PS-	POWER SECONDARY	VA	VOLT AMPERES		
CA	ENERGY COMMISSION	FAT	FIRE ALARM TERMINAL	MCTB	MAIN CATV TERMINAL BOARD	(R)	RELOCATE(D)	VAC	VOLT ALTERNATING CURRENT		
GF	COMPACT FLUORESCENT	FAU	FORCED AIR UNIT	MCTC	MAIN CATV TERMINAL CABINET	RECEPT	RECEPTACLE	VHO	VERY HIGH OUTPUT		
CFC	CALIFORNIA FIRE CODE	MFR	MANUFACTURER	MECH	MECHANICAL	REF	REFRIGERATOR	WP	WEATHER RESISTANT		
CLG	CEILING	FBO	FURNISHED BY OTHERS	MFS	MAIN FUSIBLE SWITCH	REQ'D	REQUIRED				
CL	CENTER LINE	FC-#	FAN COIL	MH	METAL HALIDE	RLA	RATED LOAD AMPS				
CKT	CIRCUIT	FLA	FULL LOAD AMPS	MLO	MAIN LUGS ONLY	RM	ROOM				
CNTR	CONTRACTOR	FLR	FLOOR	MOCB	MAXIMUM OCP	RMC	RIGID METAL CONDUIT				
C.O.	CONDUIT ONLY (W/PULLROPE)	FLUOR	FLUORESCENT	MSB	MAIN SWITCHBOARD	RMV	REMOVE				
COND	CONDUIT, CONDUCTOR	FS	FUSIBLE SWITCH	MT	MOUNT	RPLC	REPLACE				
CR	CRITICAL BRANCH	FVNR	FULL VOLTAGE NON-REVERSING	MT HT	MOUNTING HEIGHT	RS	RAPID START				
CSFM	CALIFORNIA SFM	G	GROUNDING CONDUCTOR	MTS	MANUAL TRANSFER SWITCH	SC	SIGNAL CABINET				
CT	CURRENT TRANSFORMER	GD	GENERAL CONTRACTOR	MTTB	MAIN TELEPHONE TERMINAL BOARD	SCC	SHORT CKT CURRENT				
CU	COPPER	GO	GARBAGE DISPOSAL	MTTC	MAIN TELEPHONE TERMINAL CABINET	SFM	STATE FIRE MARSHAL				
CU-#	CONDENSING UNIT	GFCI	GROUND FAULT CIRCUIT INTERRUPTER	MW	MICROWAVE	SHT	SHEET				
D	DEPTH	GFI	GROUND FAULT CIRCUIT INTERRUPTER	N	NEUTRAL (GROUNDED CONDUCTOR)	SL	SLJLINE, SWITCH LEG				
DC	DIRECT CURRENT	GND	GROUND	N	NEUTRAL (GROUNDED CONDUCTOR)	SPEC	SPECIFICATION				
DF	DRINKING FOUNTAIN			(N)	NEW	SPST	SINGLE POLE SINGLE THROW				

FC-# FAN COIL

FLR FLOOR

FLUOR FLUORESCENT

FS FUSIBLE SWITCH

FVNR FULL VOLTAGE NON-REVERSING

G GROUNDING CONDUCTOR

GC GENERAL CONTRACTOR

GD GARBAGE DISPOSAL

GFCI GROUND FAULT CIRCUIT INTERRUPTER

GFI GROUND FAULT CIRCUIT INTERRUPTER

GND GROUND

GRS GALVANIZED RIGID STEEL

GWS GANG WITH SWITCH

HAC HEATING, AC & REFRIG

HID HIGH INTENSITY DISCHARGE

HO HIGH OUTPUT

HOA HAND-OFF-AUTO

HP HORSEPOWER

HPF HIGH POWER FACTOR

HPS HIGH PRESSURE SODIUM

IC INTERCOM

ID IDENTIFICATION

IF INSIDE FROST

IG ISOLATED GROUND

J-BOX JUNCTION BOX

KVA KILOVOLTAMPS

KW KILOWATT

LC LIGHTING CONTACTOR

LPS LOW PRESSURE SODIUM

LRA LOCKED ROTOR AMPS

LS LIFE SAFETY BRANCH

LT LIGHT

LTG LIGHTING

LV LOW VOLTAGE

MFC MECHANICAL CONTRACTOR

MCA MINIMUM CKT AMPS

MCB MAIN CIRCUIT BREAKER

MCTB MAIN CATV TERMINAL BOARD

MCTC MAIN CATV TERMINAL CABINET

MFR MANUFACTURER

MFL MAIN FUSIBLE SWITCH

MH METAL HALIDE

MLO MAIN LUGS ONLY

MOCB MAXIMUM OCP

MSB MAIN SWITCHBOARD

MT MOUNT

MT HT MOUNTING HEIGHT

MTS MANUAL TRANSFER SWITCH

MTTB MAIN TELEPHONE TERMINAL BOARD

MTTC MAIN TELEPHONE TERMINAL CABINET

MW MICROWAVE

N NEUTRAL (GROUNDED CONDUCTOR)

N NEW

N3R NEMA 3R

NC NORMALLY CLOSED

NEC NATIONAL ELECTRICAL CODE

NEMA NAT'L ELEC MANUFACTURER'S ASSOC

NIC NOT IN CONTRACT

NL NIGHT LIGHT

NO NORMALLY OPEN

NPF NORMAL POWER FACTOR

NTS NOT TO SCALE

OC ON CENTER

OCP OVERCURRENT PROTECTION

OD OUTSIDE DIAMETER

OH OVERHEAD

OSA OFFICE OF THE STATE ARCHITECT

OSHPD OFFICE OF STATEWIDE HEALTH PLANNING & DEVELOPMENT

OVLd OVERLOAD

P POLE

PA PUBLIC ADDRESS

PB PULLBOX

PC PULL CHAIN

PC PHOTOCELL

ph PHASE

PNL PANEL

POC POINT OF CONNECTION

-PP- POWER PRIMARY

-PS- POWER SECONDARY

(R) RELOCATE(D)

RECEPT RECEPTACLE

REF REFRIGERATOR

REQ'D REQUIRED

RLA RATED LOAD AMPS

RM ROOM

RMC RIGID METAL CONDUIT

RMV REMOVE

RPLC REPLACE

RS RAPID START

SC SIGNAL CABINET

SCC SHORT CKT CURRENT

SFM STATE FIRE MARSHAL

SHT SHEET

SL SLUMLINE, SWITCH LEG

SPEC SPECIFICATION

SPST SINGLE POLE SINGLE THROW

SQ SQUARE

STR'G STORAGE

SURF SURFACE

SVC SERVICE

SW SWITCH

T TRANSFORMER, TERMINAL

-T- TELEPHONE CONDUIT

TBR TO BE REMOVED

TC TIME CLOCK

TEL TELEPHONE

TELCO TELEPHONE COMPANY

TS TIME SWITCH

TSO TIME SWITCH OVERRIDE

TSP TWISTED SHIELDED PAIR

TTB TELEPHONE TERMINAL BOARD

TTT TELEPHONE TERMINAL CABINET

TX TRANSFORMER

TYP TYPICAL

TYP SIM TYPICAL SIMILAR

UC UNDERCABINET, UNDERCOUNTER

UG UNDERGROUND

UGPS UNDERGROUND PULL SECTION

UL UNDERWRITERS LABORATORIES

UON UNLESS OTHERWISE NOTED

USA UG SVC ALERT 800-642-2444

V VOLT

VA VOLT AMPERES

VAC VOLT ALTERNATING CURRENT

VHO VERY HIGH OUTPUT

WP WEATHER RESISTANT

NOTHING IN THE DRAWINGS AND/OR SPECIFICATIONS SHALL BE CONSTRUED TO PERMIT AN INSTALLATION IN VIOLATION OF APPLICABLE CODES AND/OR RESTRICTIONS. SHOULD ANY CHANGE IN THE DRAWINGS AND/OR SPECIFICATIONS BE NECESSARY IN ORDER TO COMPLY WITH APPLICABLE CODES AND/OR REQUIREMENTS, THE CONTRACTOR SHALL NOTIFY ENGINEER OF RECORD. THE WORK PERFORMED UNDER THIS CONTRACT SHALL BE IN FULL ACCORDANCE WITH THE LATEST CODES, REGULATIONS, RESTRICTIONS AND REQUIREMENTS. CONTRACTOR TO OBTAIN CLARIFICATION FROM ENGINEER OF RECORD WHERE CONFLICTS IN DRAWING OR DIMENSIONS ARISE PRIOR TO PROCEEDING WITH CONSTRUCTION.

GENERAL ELECTRICAL NOTES	
<div>GENERAL LIGHTING PLAN NOTES</div> <div>GENERAL POWER PLAN NOTES</div> <div>GENERAL COMMUNICATION PLAN NOTES</div>	
<div>GENERAL NOTES</div> <div>CODES</div>	

CANTELMI ENGINEERING
MECHANICAL/ELECTRICAL
LICENSE #21180
7130 F STREET BAKERSFIELD, CA 93301
TEL: (661) 324-5252 FAX: (661) 324-8439
cantelmi@cantelmi.net

WEST SIDE FAMILY HEALTH CARE
100 EAST NORTH STREET,
TAFT, CA

DATE: ISSUED:
DATE: MARK: ISSUED:
DWG. BY: A.F.
CHKD BY: K.M.
DATE: 2/11/2025
JOB NO. C24-189
FILE NO. C24-189 ELECTRICAL DWG


SHEET
E1.01
SHEET

GENERAL ELECTRICAL NOTES CONTINUED

1.01 SCOPE OF WORK

FURNISH AND INSTALL ALL MATERIALS AND EQUIPMENT AND PROVIDE ALL LABOR, TOOLS, TRANSPORTATION, SUPERINTENDENCE AND SERVICES REQUIRED AND NECESSARY TO COMPLETE THE WORK SHOWN PM THE DRAWINGS AND/OR SPECIFIED HEREIN. ALSO INCLUDE ALL OTHER WORK AND MISCELLANEOUS TASKS NOT SPECIFICALLY IDENTIFIED FOR A COMPLETE INSTALLATION INCLUDING ALL ACCESSORIES AND APPURTENANCES REQUIRED FOR TESTING THE SYSTEM. IT IS THE INTENT OF THE DRAWINGS AND SPECIFICATIONS THAT ALL SYSTEMS BE COMPLETE, AND READY FOR OPERATION.

1.02 REGULATORY REQUIREMENT

- A. CODE COMPLIANCE IS MANDATORY. NOTHING IN THESE DRAWINGS AND SPECIFICATIONS PERMITS WORK NOT CONFORMING TO THESE CODES. WHERE WORK IS SHOWN TO EXCEED MINIMUM CODE REQUIREMENTS, COMPLY WITH DRAWINGS AND SPECIFICATIONS. ALL WORK AND MATERIALS SHALL COMPLY WITH THE LATEST RULES, CODES AND STANDARDS, INCLUDING, BUT NOT LIMITED TO THE FOLLOWING:
1. OCCUPATIONAL SAFETY AND HEALTH ACT REGULATIONS (OSHA)
 2. NFPA #70: NATIONAL ELECTRICAL CODE (NEC)
 3. NFPA #101: LIFE SAFETY CODE
 4. STATE FIRE MARSHAL
 5. LOCAL UTILITY COMPANIES

B. LANDLORD REQUIREMENTS

1.03 LICENSE, FEES, AND PERMITS

ELECTRICAL CONTRACTOR SHALL PAY FOR ALL LICENSES, PERMITS AND INSPECTION FEES REQUIRED BY THE AUTHORITY HAVING JURISDICTION AND SHALL MAINTAIN FOR ALL REQUIRED INSPECTIONS.

1.04 SAFETY AND INDEMNITY

THE CONTRACTOR SHALL BE SOLELY AND COMPLETELY RESPONSIBLE FOR CONDITIONS OF THE JOB SITE, INCLUDING SAFETY OF ALL PERSONS AND PROPERTY DURING PERFORMANCE OF WORK. THIS REQUIREMENT WILL APPLY CONTINUOUSLY AND NOT BE LIMITED TO NORMAL WORKING HOURS. NO ACT, SERVICE, DRAWING REVIEW OR CONSTRUCTION REVIEW BY THE OWNER, ENGINEERS OR THEIR CONSULTANTS, IS INTENDED TO INCLUDE REVIEW OF THE ADEQUACY OF THE CONTRACTOR'S SAFETY MEASURES, IN, ON, OR NEAR THE CONSTRUCTION SITE.

1.05 DRAWINGS AND SPECIFICATIONS

A. ALL DRAWINGS AND ALL DIVISIONS OF THESE SPECIFICATIONS SHALL BE CONSIDERED AS A WHOLE AND WORK OF THIS DIVISION SHOWN ANYWHERE THEREIN SHALL BE FURNISHED UNDER THIS DIVISION. DRAWINGS ARE DIAGRAMMATIC AND INDICATE THE GENERAL ARRANGEMENT OF EQUIPMENT AND WIRING. MOST DIRECT ROUTING OF CONDUITS AND WIRING IS NOT ASSURED. EXACT REQUIREMENTS SHALL BE GOVERNED BY CONDITIONS OF THE WORK. CONSULT ALL OTHER DRAWINGS IN PREPARATION OF THE BID. EXTEND LENGTHS OF WIRING OR ADDITION OF FULL OR JUNCTION BOXES, ETC., NECESSARY BY SUCH CONDITIONS SHALL BE INCLUDED IN THE BID.

1.06 CONDITIONS AT SITE

A. VISIT SITE OF THE WORK, COMPARE IT WITH THE DRAWINGS AND SPECIFICATIONS AS TO THE CONDITIONS UNDER WHICH WORK IS TO BE PERFORMED, ASCERTAIN AND CHECK ALL CONDITIONS AND ELIMINATIONS AND TAKE ALL MEASUREMENTS WHICH MAY AFFECT THE WORK. NO ALLOWANCE SHALL BE SUBSEQUENTLY MADE FOR ANY EXTRA EXPENSE OR CLAIMS DUE TO FAILURE OR NEGLIGENCE UNDER THIS REQUIREMENT TO MAKE SUCH EXAMINATION, INCLUDING EXAMINATION OF RESTRICTED WORKING CONDITIONS OR SUCH OTHER DIFFICULTIES VISUALLY OBSERVED DURING SITE VISIT. CONTRACTOR IS RESPONSIBLE FOR BECOMING COMPLETELY FAMILIAR WITH THE ARCHITECTURAL AND STRUCTURAL CONDITIONS AND LIMITATIONS WHICH WILL EXIST IN THE BUILDING AND TO PROVIDE ALL LABOR, TOOLS, AND MATERIALS REQUIRED TO PRODUCE A COMPLETELY CONCEALED INSTALLATION AS INDICATED ON THE PLANS, SPECIFICATIONS, AND REQUIRED BY THE CODE.

1.07 WORKMANSHIP AND CONTRACTOR'S QUALIFICATIONS

A. ONLY QUALITY WORKMANSHIP WILL BE ACCEPTED. HAZARDOUS OR POOR INSTALLATION WILL BE CAUSE FOR REJECTION OF WORK.

1.08 SUBMITTALS

A. CONTRACTOR SHALL BE RESPONSIBLE FOR PROVIDING EQUIPMENT WITH SUBMITTAL PACKAGES FOR REVIEW FOR ALL EQUIPMENT SPECIFIED ON THESE DRAWINGS. CONTRACTOR IS ONLY PERMITTED TO PURCHASE SPECIFIED EQUIPMENT FOLLOWING RECEIPT OF REVIEWED SUBMITTALS IN COMPLIANCE WITH ALL OF ENGINEER'S COMMENTS. IF CONTRACTOR PURCHASES ANY SPECIFIED EQUIPMENT WITHOUT SUBMITTING A SUBMITTAL AND RECEIVING ENGINEER COMMENTS, CONTRACTOR SHALL BE RESPONSIBLE FOR THE ACCURACY OF PURCHASED EQUIPMENT AND IS SOLELY RESPONSIBLE FOR REPLACING EQUIPMENT IF IMPROPERLY FURNISHED.

B. SUBMITTALS, UNLESS OTHERWISE NOTED, SHALL BE A SINGLE PACKAGE OF SIX (6) COPIES SUBMITTED TO OWNER FOR REVIEW. WORK SHALL NOT BE PROCEED UNLESS SUBMITTALS HAVE BEEN APPROVED.

C. SUBMIT CUTSHEETS, MATERIAL DATA, AND SHOP DRAWINGS, AS NOTED BELOW, FOR REVIEW WITHIN FIFTEEN (15) DAYS AFTER AWARD OF CONTRACT. SUBMITTALS REQUIRED AS FOLLOWS:

- C.A. BASIC ELECTRICAL MATERIALS INCLUDING BUT NOT LIMITED TO:
- C.A.1. WIRING DEVICES: RECEPTACLES, SWITCHES, FAPTES
 - C.A.2. WIRES, CONDUCTIONS, TAPES, SPLICES, TERMINATIONS, AND ACCESSORIES
 - C.A.3. BACKINGS AND ACCESSORIES
 - C.A.4. DEVICE IDENTIFICATION
- C.B. ELECTRICAL EQUIPMENT – PANELBOARDS, SWITCHBOARDS, DISCONNECT SWITCHES, CIRCUIT BREAKERS, TRANSFORMERS, GENERATORS, INVERTERS, UPS, POWER DISTRIBUTION UNITS, ETC.
- C.B.1. SERVICE ENTRANCE EQUIPMENT – BUS DUCT, TERMINATION CANS, METERED SWITCHBOARDS, ETC.
- C.C. LIGHTING
- C.C.1. LIGHT FIXTURES AND SUPPORT DEVICES
 - C.C.2. LUMENS AND BALLASTS – INCLUDE BALLASTS CERTIFICATION. BALLAST SHALL HAVE LOCAL DISCONNECTS.
 - C.C.3. POLES
 - C.C.4. CONTROLS – OCCUPANCY SENSORS, PHOTOCELL, LIGHTING CONTROLS, LIGHTING CONTROL PANELS, DIMMERS, ETC.
- C.C.5. FUTURE AND ASSEMBLY MATERIALS
- C.C.6. FOR PROJECTS THAT ARE SUBJECT TO CALIFORNIA ENERGY CODES, PROVIDE SUBMITTALS CONFIRMING THAT PRODUCTS SUBMITTED MEET THE REQUIRED MANUFACTURE MEASURES AS WELL AS MEETS MAXIMUM STATED ENERGY CONSUMPTION SHOWN IN TITLE 24 CALCULATIONS
- C.C.7. SUBMIT COMPLETE TEST REPORTS AND ANALYSIS FOR REVIEW WITHIN FIFTEEN (15) DAYS AFTER TESTING
- C.D. FOR LEED PROJECTS, SUBMIT LEED COMPLIANCE FORMS AT VARIOUS STAGES OF THE PROJECTS, OR AS REQUESTED
- C.E. SUBMIT TITLE 24 COMPLIANCE FORMS AT VARIOUS STAGES OF THE PROJECTS, OR AS REQUESTED
- C.F. SUBMIT VERIFIED PUNCHLIST TWO (2) WEEKS AFTER ISSUANCE DATE. INDICATE PUNCHLIST ITEMS THAT HAVE BEEN COMPLETED BY CONTRACTOR. INCLUDE DATE FOR REPUNCH

1.09 SUBSTITUTIONS

A. ONE OR MORE MAKES OF MATERIALS OR METHODS MAY HAVE BEEN SPECIFIED TO ESTABLISH THE STANDARD OF QUALITY, WORKMANSHIP, FINISH, AND QUALITY REQUIRED. OTHER MATERIALS OR METHODS EQUAL OR BETTER IN QUALITY, WORKMANSHIP, FINISH, DESIGN, AND GUARANTEED PERFORMANCE, MAY BE SUBMITTED FOR REVIEW AND APPROVAL AS SUBSTITUTION. ALL SUBSTITUTIONS ARE SUBJECT TO GUARANTEED PERFORMANCE, MAY BE SUBMITTED FOR REVIEW AND APPROVAL AS SUBSTITUTION. ALL SUBSTITUTIONS ARE SUBJECT TO REVIEW AND APPROVAL BY ARCHITECT, ENGINEER, OR OWNER.

B. SUBSTITUTIONS SHALL BE REQUESTED IN A WRITTEN FORM AND SHALL BE ACCOMPANIED WITH A SIGNED STATEMENT THAT PROPOSED SUBSTITUTION EQUIPMENT IS BETTER THAN SPECIFIED EQUIPMENT AND THAT THE PROPOSED SUBSTITUTION WILL BE SUPERIOR TO THE SPECIFIED EQUIPMENT IN ARCHITECT, ARCHITECT, AND ENGINEER. CONTRACTOR SHALL SUBMIT AS DIRECTED.

C. CONTRACTOR SHALL ACCOMPANY REQUEST FOR SUBSTITUTION LETTER WITH A COMPLETED CSI SUBSTITUTION FORM INCLUDING THE COMPARISON FOR FOLLOWING:

1. ELECTRICAL RATING
2. FINISHES
3. SPARE PARTS
4. PERFORMANCE DATA
5. COSTS AND SCHEDULE

D. A WRITTEN SIGNED STATEMENT FROM THE GENERAL CONTRACTOR SHALL ACCOMPANY SUBSTITUTION REQUEST FORM ASSUMING THAT THE OWNER HAS VERIFIED DIMENSIONS WITH PROJECT CONDITIONS AND HAS COORDINATED WITH OTHER TRADES. SUBSTITUTION MUST NOT AFFECT DIMENSIONS SHOWN ON DRAWINGS.

D.B. HE SHALL PAY AND BUREN THE COSTS FOR CHANGES TO THE PROJECT INCLUDING RE-DESIGN, RE-ENGINEERING AND REVIEW OF SUBSTITUTION. ONLY ONE (1) ENGINEERING REVIEW TIME IS ALLOWED FOR EACH PRODUCT SUBSTITUTION. CONTRACTOR SHALL BE RESPONSIBLE FOR ADDITIONAL REVIEW AND SHALL PAY ARCHITECT AND ENGINEER'S TIME AT THEIR PROFESSIONAL RATE SCHEDULE.

D.C. HE HAS CONFIRMED THAT THE PROPOSED SUBSTITUTION WILL HAVE NO ADVERSE AFFECT ON OTHER TRADES, THE CONSTRUCTION SCHEDULE, OR SPECIFIED WARRANTY REQUIREMENTS

D.E. HE HAS CONFIRMED THAT MAINTENANCE AND SERVICE PARTS WILL BE LOCALLY AVAILABLE FOR THE PROPOSED SUBSTITUTION

E. COST SAVINGS RESULTING FROM SUBSTITUTION SHALL BE RETURNED TO THE CONTRACTOR OR THE OWNER IF THE SUBSTITUTION IS PERMITTED.

F. NO WORK INVOLVING MATERIALS SUBMITTED FOR SUBSTITUTION SHALL PROCEED UNTIL WRITTEN ACCEPTANCE IS RECEIVED FROM THE OWNER. THE OWNER IS THE FINAL JUDGE OF ACCEPTABILITY OF PREFERRED SUBSTITUTIONS.

1.10 COORDINATION

A. COORDINATE WORK WITH OTHER TRADES TO AVOID CONFLICT AND TO PROVIDE CORRECT ROUGH-IN AND CONNECTION FOR EQUIPMENT FURNISHED UNDER OTHER TRADES THAT REQUIRE ELECTRICAL CONNECTIONS. INFORM CONTRACTORS OF OTHER TRADES OF THE REQUIRED ACCESS TO AND CLEARANCES AROUND ELECTRICAL EQUIPMENT TO MAINTAIN SERVICEABILITY AND CODE COMPLIANCE.

B. VERIFY EQUIPMENT DIMENSIONS AND REQUIREMENTS WITH PROVISIONS SPECIFIED UNDER THIS SECTION. CHECK ACTUAL JOB CONDITIONS BEFORE FABRICATING WORK. REPORT NECESSARY CHANGES IN THIS TO PREVENT NEEDLESS WORK, CHANGES OR ADDITIONS, SUBJECT TO ADDITIONAL CONFIRMATION, WHICH ARE MADE WITHOUT WRITTEN AUTHORIZATION AND AN AGREED PRICE, SHALL BE AT THE CONTRACTOR'S RISK AND EXPENSE

1.11 CUTTING AND PATCHING

A. ALL CUTTING AND PATCHING REQUIRED FOR WORK OF THIS DECISION IS INCLUDED HEREIN. COORDINATION WITH GENERAL CONTRACTOR AND OTHER TRADES IS IMPERATIVE. CONTRACTOR SHALL BEAR THE RESPONSIBILITY FOR AND THE ADDED EXPENSE OF ADJUSTING FOR IMPROPER HOLES, SUPERFICIAL DAMAGE, ETC.

1.12 ACCEPTANCE OF DEMONSTRATION

A. UPON COMPLETION OF THE WORK, AT A TIME TO BE DESIGNATED BY THE OWNER, THE CONTRACTOR SHALL DEMONSTRATE FOR THE OWNER THE OPERATION OF THE ELECTRICAL INSTALLATION, INCLUDING ANY AND ALL SPECIAL ITEMS INSTALLED BY HIM OR INSTALLED UNDER HIS SUPERVISION

B. PROPERLY SET LIGHTING CONTROL PANELS, AUTOMATIC TIME SWITCHES, ETC., TO PERFORM SWITCHING OPERATIONS IN ACCORDANCE WITH SCHEDULES PROVIDED BY THE OWNER'S REPRESENTATIVE, AND DEMONSTRATE (USING THE MANUFACTURER'S OPERATING INSTRUCTIONS) HOW TO OVERRIDE AND/OR TEST TIME SWITCHES PROGRAMMING

1.13 RECORD DRAWINGS AND EQUIPMENT DATA

- A. MAINTAIN ONE SET OF CLEAN WORKING DRAWINGS AT THE JOB SITE AND ENTER ONLY SUCH "AS-BUILT" INFORMATION AS FEEDER AND SERVICE ROUTES, FULL BOX LOCATIONS AND CHANGES IN LAYOUT OR ARRANGEMENT WHICH OCCUR DURING CONSTRUCTION. DELIVER COMPLETED "TRUE LINE AS-BUILT" DRAWINGS TO THE OWNER
- B. SUBMIT TO THE OWNER'S REPRESENTATIVE A SET OF "AS-BUILT" DRAWINGS IN VELLUM AND CAD FILE. AS BUILT COMPLEMENTS SHALL BE WRITTEN IN A LEGIBLE MANNER IN THE SAME STYLE AS THE CONTRACT DOCUMENTS. ALSO SUBMIT THREE COPIES OF DATA SHEETS OR OTHER CURRENT MANUFACTURERS' PUBLICATIONS FOR EACH ITEM OF ELECTRICAL EQUIPMENT FURNISHED FOR THE PROJECT INCLUDING AT LEAST THIS DATA:
- B.A. TECHNICAL DESCRIPTION AND REPLACEMENT PARTS LIST
 - B.B. PHYSICAL DESCRIPTION AND INSTALLATION INSTRUCTIONS
 - B.C. USER MANUAL AND OPERATING INSTRUCTIONS
 - B.D. MANUFACTURER'S WARRANTY

1.14 CLEAN-UP

A. RID THE PREMISES OF SCRAP MATERIALS, TRASH AND DEBRIS BOTH DURING CONSTRUCTION AND AT COMPLETION OF THE PROJECT. LEAVE THE BUILDING AND SURROUNDING AREA IN A CLEAN AND ORDERLY CONDITION.

1.15 GUARANTEE

A. GUARANTEE THE INSTALLATION FREE FROM DEFECTS OF WORKMANSHIP AND MATERIALS FOR A PERIOD OF ONE YEAR AFTER DATE OF CERTIFICATION OF FINAL PAYMENT AND PROMPTLY REMEDY ANY DEFECTS DEVELOPING DURING THIS PERIOD, WITHOUT CHARGE

1.16 TEMPORARY SERVICES

- A. PROVIDE ADEQUATE AND SAFE TEMPORARY ELECTRICAL POWER AND LIGHTING THROUGHOUT THE CONSTRUCTION AND FINISHING OF THE PREMISES. IN ADDITION TO SPECIAL OR UNUSUAL REQUIREMENTS, PROVIDE AT LEAST THESE ITEMS:
- A.A. THREE (3) 20-AMP CIRCUITS FOR CONSTRUCTION POWER TOOLS. PROVIDE GFI TEMPORARY CIRCUITS WITH COVERPLATES TO MEET OSHA REQUIREMENTS
 - A.B. THREE OR MORE LIGHT STRINGS SUSPENDED APPROXIMATELY ONE FOOT BELOW THE HEIGHT OF THE FINISH CEILING WITH LAMPS SPACED NOT MORE THAN TWELVE FEET ON CENTER. STRINGS SHALL BE RUN THE LENGTH OF THE STROKE SPACE PARALLEL TO THE DEMISING WALLS, WITH ONE STRING WITHIN EIGHT FEET OF EACH WALL AND ONE (OR MORE) INTERMEDIATE STRINGS ARRANGED TO LIMIT THE SPACING BETWEEN ROWS TO SIXTEEN FEET OR LESS
 - A.C. FLOOD LIGHTING AND TASK LIGHTING FOR PAINTING AND OTHER FINISH WORK
- B. WHERE SCOPE INCLUDES THE REMOVAL OF EXISTING LIGHTING, CONTRACTOR SHALL PROVIDE TEMPORARY EXTERIOR LIGHTING UNTIL THE NEW EXTERIOR LIGHTING HAS BEEN ACCEPTED BY THE OWNER. TEMPORARY EXTERIOR LIGHTING SHALL COMPLY WITH IESNA STANDARDS FOR SECURITY LIGHTING
- C. WHERE SCOPE INCLUDES THE DISABLING OF A FIRE ALARM SYSTEM, CONTRACTOR SHALL PROVIDE A FIRE WATCH. FIRE WATCH SHALL COMPLY WITH NFPA AND LOCAL FIRE MARSHAL REQUIREMENTS
- D. WHEN PERMANENT ELECTRICAL SERVICE IS OPERABLE, DISCONNECT AND REMOVE FROM THE PREMISES THE MATERIALS AND EQUIPMENT USED FOR TEMPORARY POWER AND LIGHTING. RESTORE AND REPAIR DAMAGE CAUSED BY THE INSTALLATION, USE OR REMOVAL OF TEMPORARY SERVICE PROVISIONS

END OF SECTION

2.01 MATERIAL APPROVAL

A. ALL MATERIALS MUST BE NEW AND BEAR UNDERWRITER'S LABORATORIES LABEL. MATERIALS THAT ARE NOT COVERED BY UL LISTING STANDARDS SHALL BE TESTED AND APPROVED BY AN INDEPENDENT TESTING LABORATORY OR A GOVERNMENTAL AGENCY. MATERIAL NOT IN ACCORDANCE WITH THESE SPECIFICATIONS SHALL BE REJECTED. THESE SPECIFICATIONS SHALL BE BASED ON THE LATEST EDITIONS FROM ARCHITECTURAL DRAWINGS. FOR LEED QUALIFIED BUILDINGS, PRODUCTS SHALL BE MANUFACTURED WITHIN 100 MILES OF PROJECT SITE.

2.02 BASIC ELECTRICAL MATERIALS

- A. CONDUITS AND RACEWAYS
- A.A. RIGID STEEL: HOT-DIPPED GALVANIZED
 - A.B. INTERMEDIATE METAL CONDUIT (IMC): HOT-DIPPED GALVANIZED
 - A.C. ELECTRICAL METALLIC TUBING (EMT): ECTHRO-GALVANIZED
 - A.D. RIGID NON METALLIC CONDUIT (PVC SCHEDULE 40)
 - A.E. WIREMAY: 2000 SERIES STEEL WITH INDOORS AND OUTDOORS CORROSION RESISTANT GRAY BAKED ENAMEL FINISH
 - A.F. PROVIDE FITTINGS AND ACCESSORIES APPROVED FOR THE PURPOSE EQUAL, IN ALL RESPECTS TO THE CONDUIT OR RACEWAY. EMT CONNECTORS AND COUPLINGS SHALL BE STEEL SETSCREW TYPE INDOORS AND STEEL COMPRESSION TYPE IN WET LOCATIONS AND OUTDOORS
- B. WIRES AND CABLES
- B.A. FOR POWER AND LIGHTING SYSTEM 600V OR LESS
 - B.A.A. CONDUCTOR
 - * MINIMUM SIZE #12 AWG
 - * #12 AND #10 AWG SOLID COPPER
 - * #8 AWG AND LARGER SHALL BE STRANDED COPPER
 - B.A.B. INSULATION TYPE
 - * #12 TO #16 AWG THIN FOR WET OR UNDERGROUND AND THIN FOR DRY LOCATIONS
 - * #16 THROUGH #6 AWG: XHHW (55 MILS)
 - * #2/0 MCW AND LARGER: XHHW (65 MILS)
 - * GROUNDING WIRE: THW
 - B.A.C. METAL CLAD (MC) CABLES:
 - * CONDUCTORS ARE MADE FROM CLASS B COPPER. SIZES 14 AWG, 12AWG, AND 10 AWG MAY BE EITHER SOLID OR STRANDED, 8 AWG AND LARGER ARE STRANDED. THE CONDUCTORS ARE CONSTRUCTED WITH THIN PLAIN OR XHHW-2 INSULATION RATED FOR 900C DRY OR WET AT 600 VOLTS MAX. A CIRCUIT GROUNDING CONDUIT IS CABLED WITH THE PHASE CONDUCTORS. THE GROUND CONDUCTOR HAS A GREEN INSULATION. AN INTERLOCKED ALUMINUM ARMOR IS HELICALLY FORMED AROUND THE CONDUCTOR.
- B.B. FOR SIGNAL AND COMMUNICATIONS CIRCUIT
- B.B.A. SIGNAL CABLES SHALL BE SPECIFIED ON DRAWINGS
 - B.B.B. CONDUCTORS FOR GENERAL USE SHALL BE STRANDED COPPER, #16 AWG MINIMUM, WITH THIN INSULATION FOR UNDERGROUND OR WET LOCATIONS AND THIN INSULATION FOR DRY LOCATIONS
- B.C. ADJACENT CIRCuits: GENERAL ELECTRIC, ANSONIA, OKWITE, PANAVIT OR TRIANGLE PRODUCTS CONFORMING OR EXCEEDING APPLICABLE IPCO STANDARDS
- C. OUTLET BOXES, JUNCTION AND PULLBOXES
- C.A. OUTLET BOXES SHALL BE 1-1/2" DEEP (OR LARGER), GALVANIZED STEEL, K0-TYPE WITH PLASTER RING AND COVER FOR GENERAL INTERIOR USE. USE CAST METAL TYPE FS OR FD WITH MATCHING SCREW COVERS FOR EXTERIOR AND EXPOSED INTERIOR LOCATIONS (GASKETED IN DAMP OR WET LOCATIONS)
- C.B. JUNCTION BOXES (FLOOR BOX NOT INCLUDED) SHALL BE SAME AS OUTLET BOXES TO 42 CU. IN. AND CODE-GRADE STEEL IN LARGER SIZES WITH SUBMERGIBLE OR FLUSH-TYPE SCREW-MOUNTED TRIMCOVERS. BOTH BOXES AND COVERS INHIBITOR-PRIMED AND PAINTED INSIDE OUT. C.C. FULL BOXES SHALL BE SAME AS JUNCTION BOXES UNLESS INDICATED OTHERWISE ON THE DRAWINGS, WITH COVERS
- C.D. OUTLET BOXES SHALL NOT BE USED FOR THE TYPICAL USE REQUIRED BY THE SERVING TELEPHONE COMPANY BUT NOT SMALLER THAN 1-1/4" X 1-1/4" X 1-1/4" DEEP WITH 1/2" JUNCTION BOXES, HANDHOLES, AND MANHOLES SHALL BE MADE UP OF PRECAST CONCRETE WITH TRAFFIC RATED STEEL COVERS. EXTENSIONS SHALL BE PROVIDED AS NECESSARY TO MAINTAIN COVERAGE FOR DUCT BANKS. PROVIDE 10" X 17" (MIN) FOR PULLBOXES, 36" X 60" (MIN) FOR MANHOLES, AND 48" X 8" X 3" (MIN) FOR MANHOLES
- D. WIRING DEVICES AND PLATES
- D.A. WIRING DEVICES AND PLATES SHALL BE LISTED FOR SPECIFIC USE
- D.B. ALL POWER RATING DEVICES AND THERMAL PROTECTIVE CIRCUITS SHALL BE NEMA SPECIFICATION GRADE, RATED AS FOLLOWS:
- D.B.A. GENERAL PURPOSE RECEPTACLES: NEMA 5-15R OR 5-20R
 - D.B.B. LAMPS: NEMA 175R OR 175R-2
 - D.B.C. DEDICATED RECEPTACLES: NEMA 5-20R
 - D.C. SWITCHES: TWENTY (20) AMPERES
 - D.C.A. IN MECHANICAL ROOMS, EQUIPMENT ROOMS, ILLUMINATED LIGHT SWITCHES SHALL BE PROVIDED.
 - D.C.B. ALL GENERAL PURPOSE TWENTY (20) A, 125/250 V RECEPTACLES AND 120/277 V SWITCHES SHALL CONFORM TO NEMA W-1 SPECIFICATIONS
 - D.E. UNLESS OTHERWISE INDICATED, WIRING DEVICES AND COVER PLATES SHALL BE FURNISHED AND INSTALLED IN COLOR TO MATCH FINISH SURFACE
 - D.E.A. WHERE IT IS UNACCEPTABLE, USE BLACK, WHITE, OR GREY
 - D.E.B. OUTLETS SERVED FROM AN EMERGENCY POWER SYSTEM SHALL BE RED
 - D.E.C. OUTLETS SERVED FROM A NORMAL POWER SYSTEM SHALL BE WHITE OR WHITE TO MATCH ADJACENT FINISH
 - D.E.D. OUTLETS SERVED FROM AN ISOLATED GROUND SHALL BE ORANGE WITH ISOLATED GROUND (TRIANGULAR) MARKING
- E. CONDUIT HANGERS
- FOR INDIVIDUAL CONDUIT RUNS NOT DIRECTLY FASTENED TO THE STRUCTURE, USE ROD HANGERS MANUFACTURED BY CADDY, UNISTRUT OR POWERSTRUT. FOR MULTIPLE CONDUIT RUNS, USE UNISTRUT OR POWERSTRUT TRAPEZOID TYPE CONDUIT SUPPORT DESIGNED FOR MAXIMUM DEFLECTION NOT GREATER THAN 1"


- 2.03 PANELBOARDS
- A. UNLESS OTHERWISE NOTED, ACCEPTABLE MANUFACTURERS ARE CUTLER HAMMER, SQUARE D, SIEMENS, GENERAL ELECTRIC, OR APPROVED EQUAL. ELECTRICAL EQUIPMENT ARE BASED ON THE FOLLOWING:
- A.A. LIGHTING AND APPLIANCE CIRCUITS: MAGNETIC TRIP OR APPROVED EQUAL WITH 40 AMPERES, 100 AND 1500
 - A.B. POWER PANELBOARDS – SQUARE D, LINE
 - A.B.A. CONSTRUCTION: CABINETS SHALL BE OF CODE GAUGE, GALVANIZED STEEL, SURFACE OR FLUSH MOUNTED AS INDICATED. DOORS SHALL BE OF 1/2" THICK GALVANIZED STEEL WITH FLUSH FINISH, WITH FINISH TO BE AS SELECTED BY ARCHITECT. WHEN USED, EXTERIOR TYPE 36 EMERGENCY EXIT DOORS SHALL HAVE A HSP TO THE OUTLET. A DIRECTORY LABEL SHALL BE PROVIDED WITH CIRCUITS IDENTIFIED AS INDICATED ON THE SCHEDULE
 - A.B.2. BUS BAR CONNECTIONS TO THE BRANCH CIRCUIT BREAKERS SHALL BE THE DISTRIBUTED PHASE TYPE AND SHALL ACCEPT PULL-ON CIRCUIT BREAKERS. 300-400 A LOAD CENTERS SHALL ACCEPT A 150A MAXIMUM BOLT-ON BREAKER IN ADDITION TO PULL-ON TYPES. C. SHORT CIRCUIT CURRENT RATINGS AMPERE RISE SYMMETRICAL SHORT CIRCUIT RATINGS SHALL BE COORDINATED WITH PEAK
 - A.B.3. CIRCUIT BREAKERS SHALL BE SQUARE D TYPE. EACH CIRCUIT BREAKER SHALL BE PROVIDED WITH CIRCUITS IDENTIFIED AS INDICATED ON THE SCHEDULE
 - A.B.4. BUS BAR CONNECTIONS TO THE BRANCH CIRCUIT BREAKERS SHALL BE THE DISTRIBUTED PHASE TYPE AND SHALL ACCEPT PULL-ON CIRCUIT BREAKERS. 300-400 A LOAD CENTERS SHALL ACCEPT A 150A MAXIMUM BOLT-ON BREAKER IN ADDITION TO PULL-ON TYPES. C. SHORT CIRCUIT CURRENT RATINGS AMPERE RISE SYMMETRICAL SHORT CIRCUIT RATINGS SHALL BE COORDINATED WITH PEAK
 - A.B.5. CIRCUIT BREAKERS SHALL BE SQUARE D TYPE. EACH CIRCUIT BREAKER SHALL BE PROVIDED WITH CIRCUITS IDENTIFIED AS INDICATED ON THE SCHEDULE
 - A.B.70. BUS BAR CONNECTIONS TO THE BRANCH CIRCUIT BREAKERS SHALL BE THE DISTRIBUTED PHASE TYPE AND SHALL ACCEPT PULL-ON CIRCUIT BREAKERS. 300-400 A LOAD CENTERS SHALL ACCEPT A 150A MAXIMUM BOLT-ON BREAKER IN ADDITION TO PULL-ON TYPES. C. SHORT CIRCUIT CURRENT RATINGS AMPERE RISE SYMMETRICAL SHORT CIRCUIT

FILE: S:\PROJECTS\WEST SIDE FAMILY HEALTH CARE\24-189\24-189 ELECTRICAL.dwg DATE: 2/11/2025 2:02 PM
REVISIONS: 1.0. THESE PLANS AND SPECIFICATIONS SHALL BE CONSIDERED TO BE THE FINAL SET FOR WHICH THE ENGINEER HAS ASSUMED RESPONSIBILITY. NO OTHER REVISIONS SHALL BE MADE WITHOUT THE WRITTEN CONSENT OF THE ENGINEER. ANY CHANGES TO THESE PLANS AND SPECIFICATIONS SHALL BE MADE BY THE ENGINEER WITHOUT THE WRITTEN CONSENT OF THE ENGINEER. ANY CHANGES TO THESE PLANS AND SPECIFICATIONS SHALL BE MADE BY THE ENGINEER WITHOUT THE WRITTEN CONSENT OF THE ENGINEER. ANY CHANGES TO THESE PLANS AND SPECIFICATIONS SHALL BE MADE BY THE ENGINEER WITHOUT THE WRITTEN CONSENT OF THE ENGINEER.



OVERALL FLOOR PLAN

SCALE: 1/8" = 1'-0"

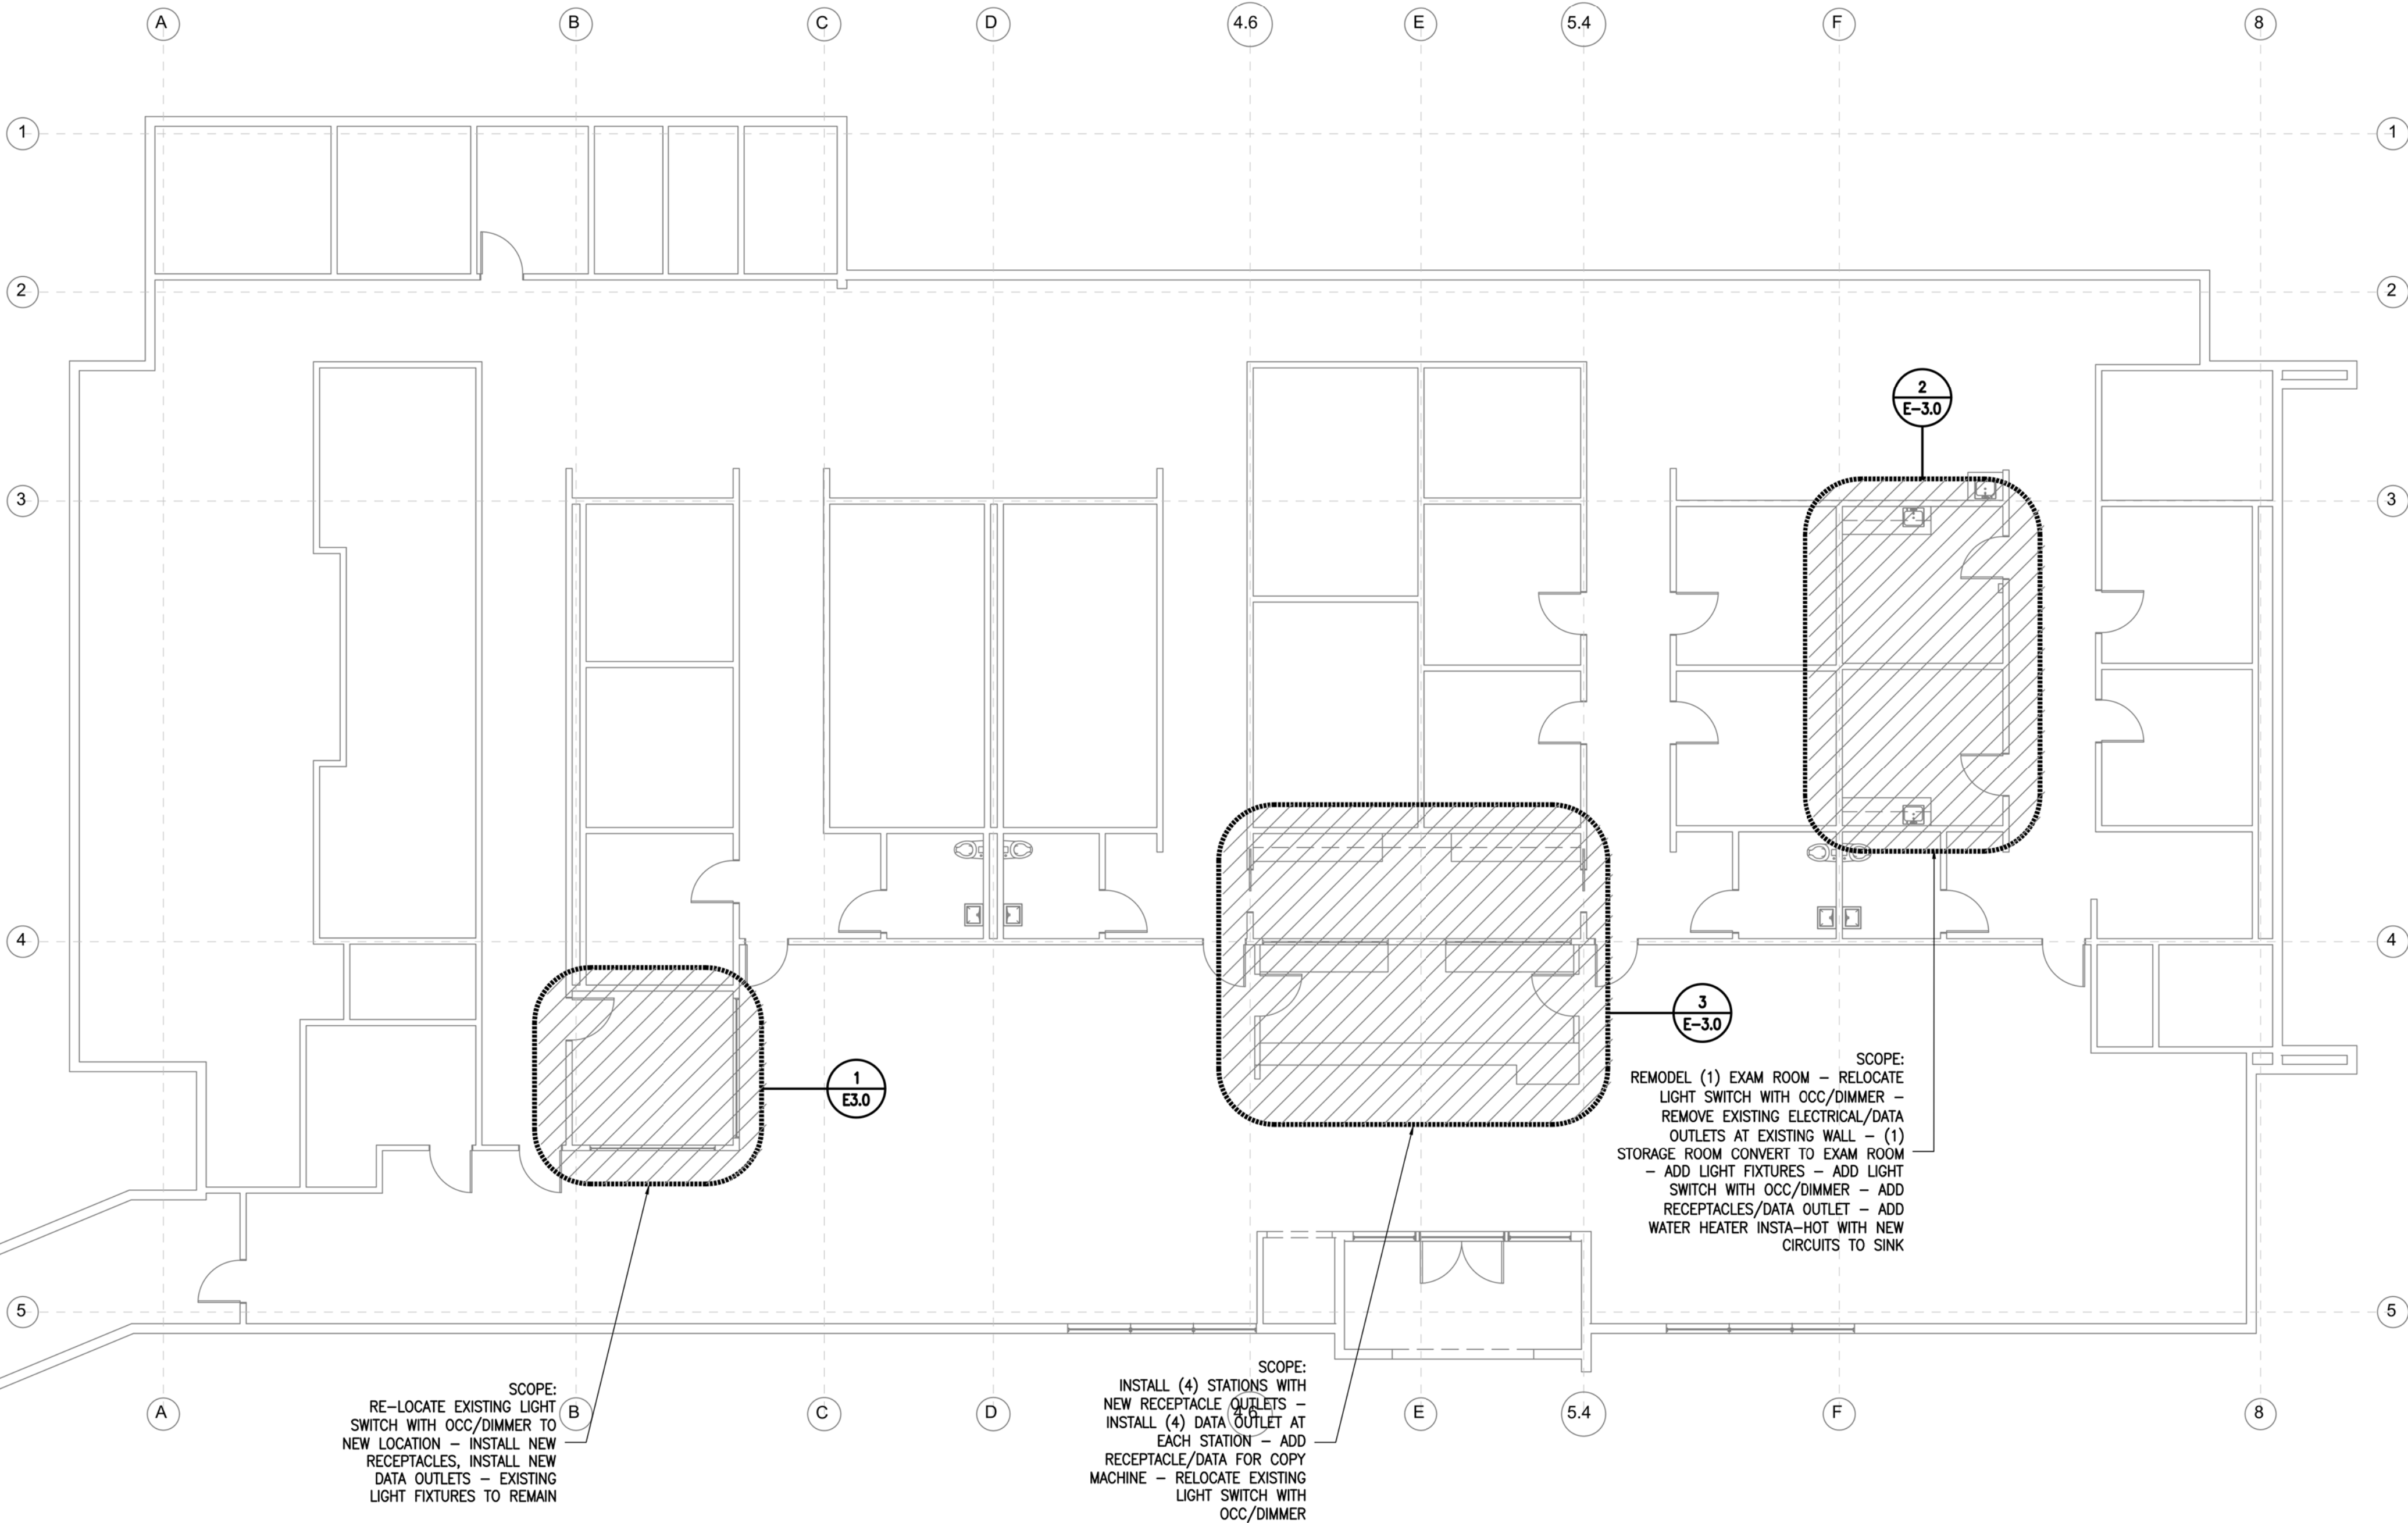

CANTELM ENGINEERING
MECHANICAL/ELECTRICAL
LICENSE #21180
2130 F STREET BAKERSFIELD, CA 93301
TEL: (805) 324-5252 FAX: (805) 324-8439 cantelemi@cantelmi.net

WEST SIDE FAMILY HEALTH CARE
100 EAST NORTH STREET,
TAFT, CA

DATE	ISSUED

DATE	MARK	ISSUED

DWG. BY	A.F.
CHKD BY	K.M.
DATE	2/11/2025
JOB NO.	C24-189
FILE NO.	C24-189 ELECT.DWG




SHEET
E2.0
SHEET

FILE: S:\PROJECTS\WEST SIDE FAMILY HEALTH CARE\24-189\24-189 ELECTRICAL.dwg DATE: 2/11/2025 2:05 PM
PLT: C:\Users\ADMIN\OneDrive\Documents\24-189\24-189 ELECTRICAL.dwg
NOTE: THESE PLANS AND SPECIFICATIONS SHALL BE SUBMITTED TO THE ORIGINAL OWNER FOR REVIEW. THE USER AGREES TO HOLD THE ENGINEER HARMLESS FROM ANY AND ALL CLAIMS, DAMAGES, LOSSES, AND EXPENSES, INCLUDING REASONABLE ATTORNEY'S FEES, THAT MAY BE INCURRED BY THE ORIGINAL OWNER AS A RESULT OF THE USER'S USE OF THESE PLANS AND SPECIFICATIONS. THE USER'S USE OF THESE PLANS AND SPECIFICATIONS SHALL BE LIMITED TO SUCH USE. RE-USE, REPRODUCTION, OR PUBLICATION BY ANY METHOD, IN WHOLE OR IN PART, IS PROHIBITED. TITLE TO THE PLANS AND SPECIFICATIONS REMAINS WITH THE ENGINEER WITHOUT RESERVE. USUAL CONTACT WITH THESE PLANS AND SPECIFICATIONS SHALL CONSTITUTE FROM FURTHER EVIDENCE OF THE ACCEPTANCE OF THESE RESTRICTIONS. CANTELM ENGINEERING

KEYNOTES


KEYNOTES LISTED BELOW PERTAIN TO PLAN ON THIS SHEET ONLY. KEYNOTES FROM THIS LIST THAT ARE NOT KEYED SHALL BE DISREGARDED. ITEMS NOT IDENTIFIED WITH A KEYNOTE BUT DRAWN SIMILAR TO THOSE ITEMS KEYNOTED SHALL BE CONSIDERED AS THOUGH THEY ARE KEYNOTED, CONSISTANT WITH LIKE KEYNOTED ITEMS.

- 1 REMOVE AND RELOCATE EXISTING LIGHT SWITCH
- 2 REMOVE AND RELOCATE EXISTING RECEPTACLE
- 3 REMOVE AND RELOCATE EXISTING CAT5 DATA WIRE
- 4 INSTALL NEW RECEPTACLE - RUN NEW 1" C AND NEW CIRCUIT TO EXISTING ELECTRICAL PANEL
- 5 INSTALL NEW DATA - RUN 1" C AND NEW CAT5 WIRE TO DATA PANEL
- 6 RELOCATE LIGHT SWITCH AND THERMOSTAT TO THIS WALL - 1" C USE EXISTING CIRCUIT FIELD VERIFY
- 7 INSTALL NEW 2X4 LIGHT FIXTURE
- 8 REMOVE AND REPLACE EXISTING 2X4 LIGHT FIXTURE
- 9 INSTALL NEW RECEPTACLE FOR COPY MACHINE - RUN 1" C AND NEW CIRCUIT TO EXISTING PANEL
- 10 EXISTING RECEPTACLE TO REMAIN
- 11 EXISTING FLOOR MOUNT RECEPTACLE TO BE REMOVED - CAP AND FILL W/CONCRETE TO MATCH EXISTING FLOOR
- 12 EXISTING 2X2 LIGHT FIXTURE TO REMAIN
- 13 EXISTING WATER HEATER CIRCUIT TO REMAIN
- 14 INSTALL NEW WATER HEATER CIRCUIT - RUN 1" C TO EXISTING PANEL - REFER TO PLUMBING SHEET FOR SCHEDULE
- 15 ADJUST HEIGHT AS REQUIRED FIELD VERIFY - SEE ARCH. ELEVATION PLANS FOR EXACT LOCATIONS
- 16 ADJUST HEIGHT TO EXISTING LIGHT SWITCHES AS REQUIRED FIELD VERIFY - SEE ARCH. ELEVATION PLANS FOR EXACT LOCATIONS
- 17 EXISTING RECEPTACLE TO REMAIN - FIELD VERIFY LOCATION
- 18 REMOVE EXISTING SMOKE DETECTOR - REINSTALL AT NEW LOCATION
- 19 RELOCATE FIRE ALARM PULL STATION CONTROL PANEL TO NEW LOCATION - SEE ARCH PLANS FOR EXACT LOCATION

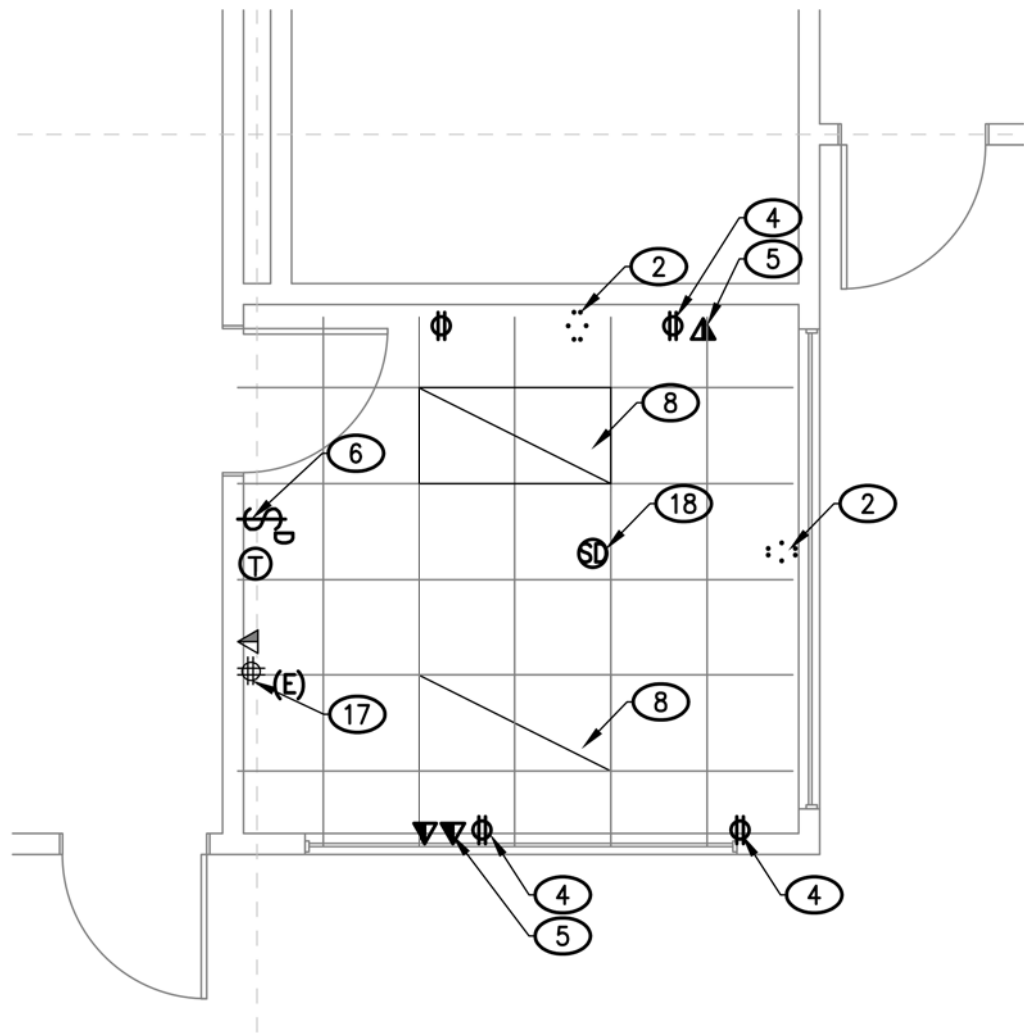


1 - PARTIAL ELECTRICAL PLAN
ROOM 1 - ADMINISTRATION

SCALE: 1/4" = 1'-0"

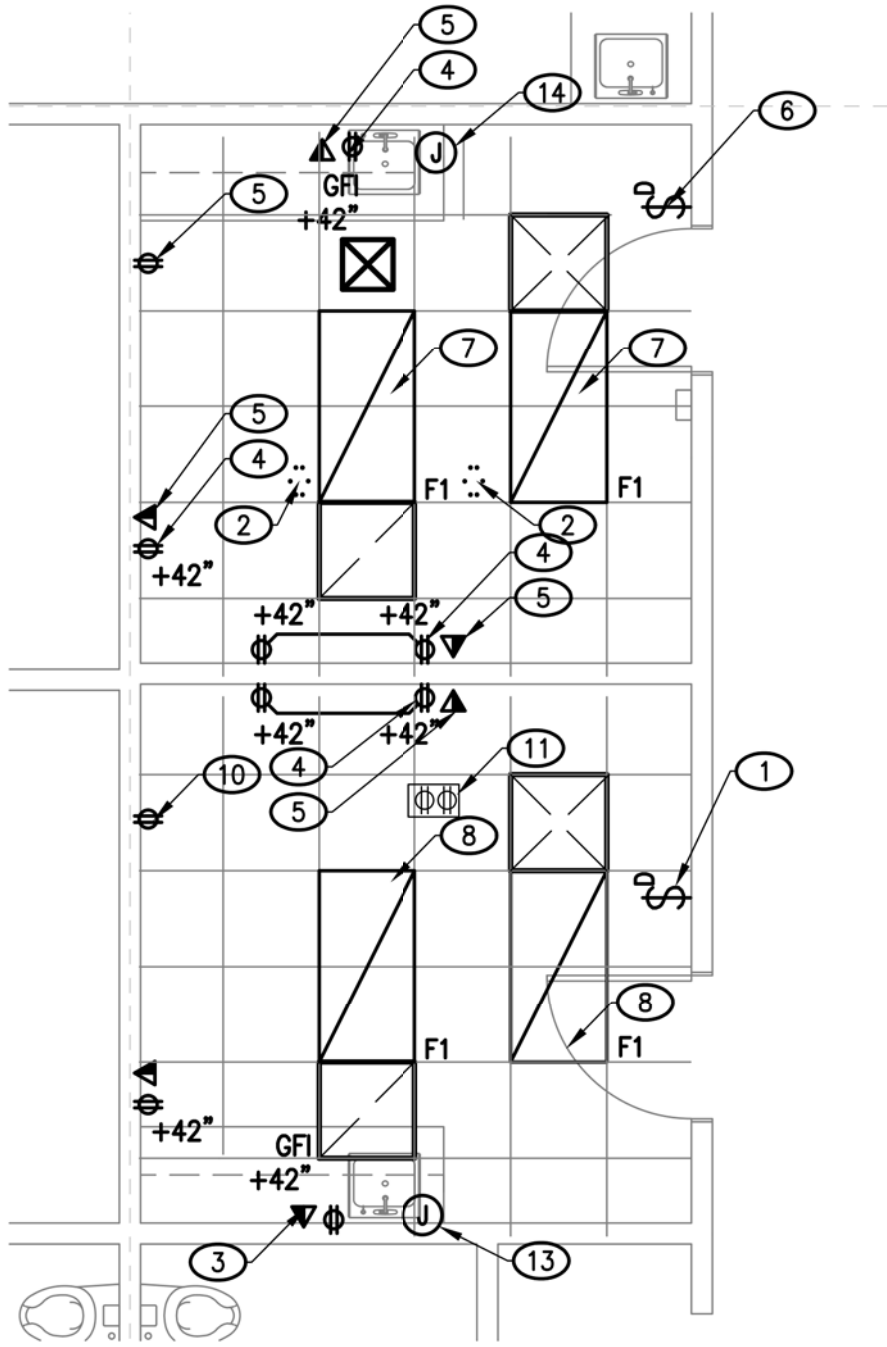

2 - PARTIAL ELECTRICAL PLAN
ROOM 2 & 3 - EXAM ROOMS

SCALE: 1/4" = 1'-0"

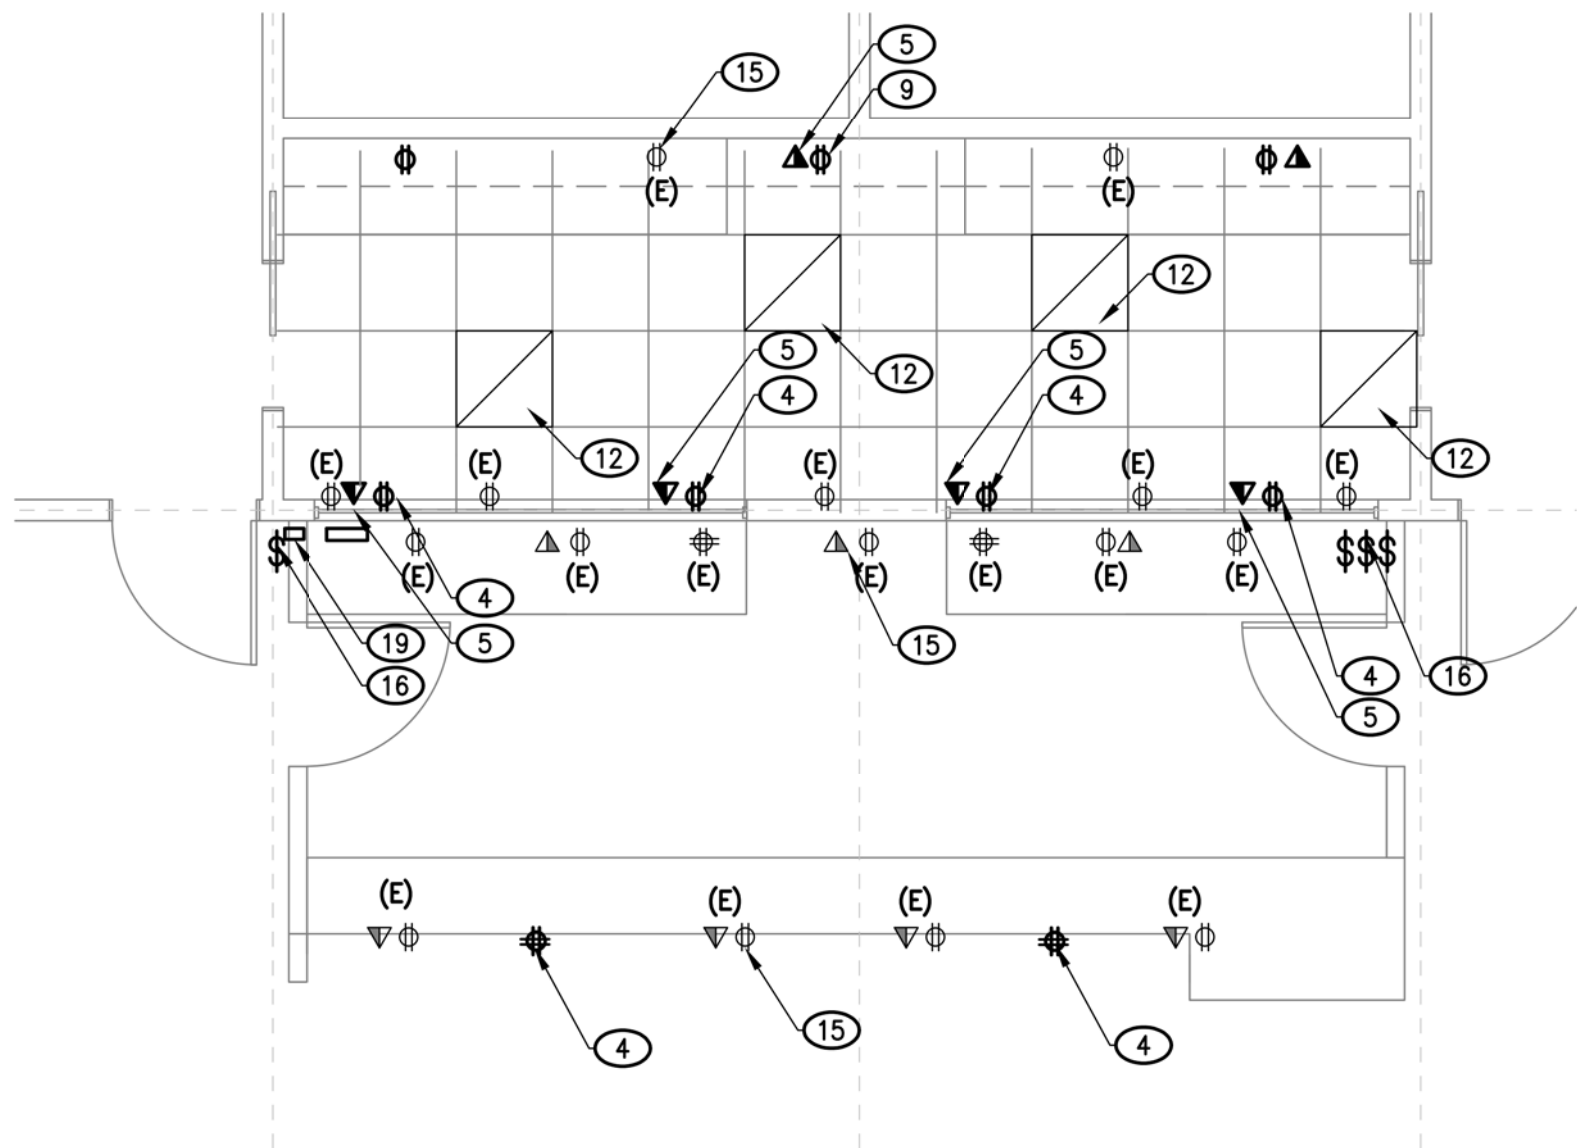

3 - PARTIAL ELECTRICAL PLAN
ROOMS 4 & 5 - RECEPTION/OFFICE

SCALE: 1/4" = 1'-0"

CANTELM ENGINEERING
MECHANICAL/ELECTRICAL
LICENSE #21180
2130 F STREET BAKERSFIELD, CA 93301
TEL: (661) 324-3232 FAX: (661) 324-8439 cantelemi@cantelemi.net

WEST SIDE FAMILY HEALTH CARE
100 EAST NORTH STREET,
TAFT, CA

DATE	ISSUED

DATE	MARK	ISSUED

DWG. BY	A.F.
CHKD BY	K.M.
DATE	2/11/2025
JOB NO.	C24-189
FILE NO.	C24-189 ELECT DWG



SHEET
E3.0
SHEET

MECHANICAL ABBREVIATIONS			
& /	AND	HB	HOSE BIBB
⊙	ANGLE	HC	HANDICAPPED
⊙	AT	HD	HEAD
⊙	CENTER LINE	HDWE	HARDWARE
⊙	PROPERTY LINE	HL	HIGH
⊙	DIAMETER OR ROUND	HORIZ	HORIZONTAL
(E)	EXISTING	HP	HORSEPOWER
(N)	NEW	HW	HOT WATER
⊕	PERPENDICULAR	HWR	HOT WATER RETURN
⊕	POUND OR NUMBER	HWS	HOT WATER SUPPLY
⊕	THERMOSTAT	HVAC	HEATING, VENTILATING, AIR CONDITIONING
A/C	AIR CONDITIONING	ID	INSIDE DIAMETER (DIM.)
AP	ACCESS PANEL	INSUL	INSULATION
ABV	ABOVE	INT	INTERIOR
ADJ	ADJUSTABLE	LAV	LAVATORY
AFF	ABOVE FINISH FLOOR	LBS	POUNDS
AE	ADJUSTABLE EXTRACTOR	LPG	LIQUID PETROLEUM GAS
AGGR	AGGREGATE		
ALUM	ALUMINUM	MACH	MACHINE
APPROX	APPROXIMATE	MATL	MATERIAL
APPT	APPOINTMENTS	MAX	MAXIMUM
ARCH.	ARCHITECTURAL	MBH	BTU PER HOUR (THOUSANDS)
ARI	AMERICAN REFRIGERATION INSTITUTE	MCB	MINIMUM CIRCUIT AMPS
ASPH	ASPHALT	MECH	MECHANICAL
ASST	ASSISTANT	MTL	META
AUTO.	AUTOMATIC	MFR	MANUFACTURER
		MH	MANHOLE
		MIN	MINIMUM
		MISC	MISCELLANEOUS
		MUA	MAKE UP AIR
BD	BALANCING DAMPER		
BDD	BACKDRAFT DAMPER	(N)	NEW
(BF)	BELOW FINISH FLOOR	NIC	NOT IN CONTRACT
(BG)	BELOW FINISH GRADE	NO, or #	NUMBER
BLDG	BUILDING	NOM	NOMINAL
BLKG	BLOCKING	NTS	NOT TO SCALE
BM	BEAM		
BTUH	BRITISH THERMAL UNIT/ HOUR		
BTM	BOTTOM		
BV	BALL VALVE		
CA	COMBUSTION AIR		
CAP	CAPACITY		
CD	CONDENSATE DRAIN	OA	OVERALL
CFD	CEILING FIRE DAMPER	OB	OPPOSED BLADE DAMPER
CFM	CUBIC FEET PER MINUTE	OC	ON CENTER
CHW	CHILLED WATER	OSA	OUTSIDE AIR
CHWR	CHILLED WATER RETURN	OVHD	OVERHEAD
CHWS	CHILLED WATER SUPPLY		
CJ	CONTROL JOINT		
CLG	CEILING	PTN	PARTITION
CLKG	CAULKING	PHYS	PHYSICAL
CLR	CLEAR	PR	PRESSURE RELIEF
CO	CLEANOUT	PVC	POLY VINYL CHLORIDE PIPE
COL	COLUMN	PLAS	PLASTER
COMP	COMPRESSED	PLYWD	PLYWOOD
CONC	CONCRETE	POC	POINT-OF CONNECTION
CONF	CONFERENCE	PREFAB	PREFABRICATED
CONN	CONNECTION	PREP	PREPARATION
CONST	CONSTRUCTION	PSI	POUNDS PER SQUARE INCH
CONT	CONTINUOUS	PW	PROCESSED WATER
CORR	CORRIDOR		
CSE	CALIFORNIA SEASONAL EFFICIENCY	R	RISER
CKS	COUNTERSUNK	RA	RETURN AIR
CTR	CENTER	RAD.	RADIUS
CV	CHECK VALVE	REF	RETURN AIR GRILLE
		REIN	REINFORCED
		REQD	REQUIRED
		RM	ROOM
		RND	ROUND
DBL	DOUBLE	S	SOUTH
DB	DRY BULD (TEMPERATURE)	SA	SUPPLY AIR
DEPT	DEPARTMENT	SAD	SUPPLY AIR DIFFUSER
DET	DETAIL	SAG	SUPPLY AIR GRILLE
DF	DRINKING FOUNTAIN	SAR	SUPPLY AIR REGISTER
DHW	DOMESTIC HOT WATER	SCHD	SCHEDULE
DHWR	DOMESTIC HOT WATER RETURN	SD	SMOKE DETECTOR
DIA or ⌀	DIAMETER	SEER	SEASONAL ENERGY EFFICIENCY
DIR	DIRECTOR	SECT.	SECTION
DN	DOWN	SHT	SHEET
DR	DOOR	SIM	SIMILAR
DS	DOWNSPOUT	SQ	SQUARE
DSP	DRY STAMPIPE	SPEC	SPECIFICATION
DTR	DUCT THRU ROOF	SP	STATIC PRESSURE
DTW	DUCT THRU WALL	SOV	SHUT-OFF VALVE
DWG	DRAWING	SS	SERVICE
		SS	STAINLESS STEEL
		STD	STANDARD
		STL	STEEL
		STOR	STORAGE
E	EAST	STRUCT	STRUCTURAL
E	EXHAUST AIR	SUPV	SUPERVISOR
EAG	EXHAUST AIR GRILLE	SUSP	SUSPENDED
EDB	ENTERING DRY BULB	S&W	SOIL & WASTE
EER	ENERGY EFFICIENCY RATIO		
ELEC	ELECTRIC	TC	TOP OF CURB
ELEV	ELEVATION	TEL	TELEPHONE
EMER	EMERGENCY	TER	TERRAZZO
ENCL	ENCLOSURE	TG	TRANSFER GRILLE
EP	ELECTRICAL PANEL	THK	THICK
EQ	EQUAL	TOC	TOP OF CONCRETE
EQUIP	EQUIPMENT	TP	TRAP PRIMER
(E)	EXISTING	TRANS	TRANSCRIPTION
ESP	EXTERNAL STATIC PRESSURE	TREAT.	TREATMENT
EXT	ENTERING WET BULB	TYP	TYPICAL
EXPO.	EXPOSED	TV	TEMPERING VALVE
EWB	EXTERIOR		
		UL	UNDERWRITERS LABORATORIES
		UN OR	UNLESS OTHERWISE NOTED
		URINAL	URINAL
FA	FIRE ALARM	V	VENT
FC	FLEXIBLE CONNECTION	VD	VOLUME DAMPER
FD	FIRE DAMPER	VSAD	VENT THRU ROOF
FDN	FOUNDATION		VARIABLE SUPPLY AIR DIFFUSER
FE	FIRE EXTINGUISHER		
FEC	FIRE EXTINGUISHER CABINET		
FHC	FIRE HOSE CAB.		
FHMS	FLAT HEAD METAL SCREW		
FIN.	FINISH		
FLA	FULL LOAD AMPS		
FLASH.	FLASHING		
FLM	FIRE MAIN		
FOC	FACE OF CONCRETE		
FOF	FACE OF FINISH		
FOF	FEET PER MINUTE		
FRPF	FIREPROOFING		
FSC	FAN SPEED CONTROL		
FSD	FIRE/SMOKE DAMPER		
FSL	FIRE SPRINKLER LINE		
FTR	FLUE THRU ROOF		
FUNC	FUNCTION		

DUCT SIZING REQUIREMENTS

0-90 CFM	600 FPM	.08 LOSS	PER 100FT	6" DIAMETER
90-200 CFM	600 FPM	.08 LOSS	PER 100FT	8" DIAMETER
200-375 CFM	700 FPM	.08 LOSS	PER 100FT	10" DIAMETER
375-600 CFM	800 FPM	.08 LOSS	PER 100FT	12" DIAMETER
600-900 CFM	875 FPM	.08 LOSS	PER 100FT	14" DIAMETER
900-1200 CFM	900 FPM	.08 LOSS	PER 100FT	16" DIAMETER
1200-1600 CFM	900 FPM	.08 LOSS	PER 100FT	18" DIAMETER
1600-2000 CFM	900 FPM	.08 LOSS	PER 100FT	20" DIAMETER
2000-2400 CFM	900 FPM	.08 LOSS	PER 100FT	22" DIAMETER

NOTES:

1. ALL ELBOWS TO BE SMOOTH RADIUS
2. ALL FITTINGS TO BE OF INDUSTRY STANDARD TYPE WITH COEFFICIENTS PUBLISHED IN MANUAL Q

SYMBOL	DESCRIPTION
	AIR CONDITION UNIT
	SUPPLY AIR CEILING DIFFUSER
SIZE CFM	SUPPLY AIR CEILING DIFFUSER
SIZE CFM	SUPPLY VARIABLE AIR CEILING DIFFUSER HEAT & COOL
SIZE CFM	RETURN AIR CEILING REGISTER
SIZE CFM	EXHAUST AIR CEILING REGISTER
SIZE CFM	SUPPLY AIR WALL DIFFUSER
SIZE CFM	RETURN AIR WALL REGISTER
SIZE CFM	EXHAUST AIR WALL REGISTER
SIZE	TRANSFER GRILLE
	DUCTWORK (RECTANGULAR)
	DUCTWORK (ROUND)
	LINED DUCTWORK
	TURNIG VANE
	FLEXIBLE DUCTWORK
	FLEXIBLE CONNECTION
	MANUAL AIR VOLUME DAMPER
	FIRE DAMPER
	SMOKE FIRE DAMPER
	<u>OUTSIDE AIR INTAKE</u> MIN. CFM
	ROOM THERMOSTAT - SUBSCRIPT INDICATES UNIT CONTROL
	BYPASS TIMER
	TIME CLOCK
	ON/OFF SWITCH
	FAN SPEED CONTROL
	DUCT SMOKE DETECTOR
	POINT OF CONNECTION
	CEILING EXHAUST FAN
	FURNACE (VERTICAL)

FURNACE (HORIZONTAL)

CONDENSING UNIT

SECTION 1

BASIC MECHANICAL MATERIALS AND METHODS

PART 1 - GENERAL

1.1 SUMMARY

A. LABOR, MATERIALS, TOOLS, AND SERVICES FOR A COMPLETE INSTALLATION OF EQUIPMENT AND SYSTEM CONTAINED IN THE CONTRACT DOCUMENTS.

B. PRINCIPAL FEATURES OF THE WORK INCLUDED ARE:

1. HEATING, VENTILATING, AIR CONDITIONING SYSTEMS, CONTROLS, AND MECHANICAL SYSTEM INSULATION.
2. ROOF CURBS FOR HVAC SYSTEMS, INTAKE HOODS, LOUVERS, SUPPLY FANS, AND RELIEF VENTS FURNISHED AND SET UNDER THIS DIVISION.
3. REFRIGERANT PIPING, CONNECTIONS, REFRIGERANT AND REFRIGERANT CHARGES.
4. EXCAVATING AND BACKFILLING FOR MECHANICAL WORK; COORDINATE WITH APPROPRIATE TRADE.
5. ANCHOR BOLTS, SLEEVES, SUPPORTS AND SIMILAR ITEMS TO BE BUILT INTO CONCRETE OR MASONRY.
6. PREPARATION FOR TESTING AND BALANCE OF MECHANICAL SYSTEMS AND CORRECTING DEFICIENCIES.
7. PREPARATION AND SUBMITTAL OF SHOP DRAWING AND PRODUCT DATA.
8. MAINTAINING A RECORD SET OF BLUE LINE PRINTS AND MAKING THEM TO INDICATE LOCATIONS OF CONCEALED ITEMS, AND DEVIATIONS MADE TO SUIT CONDITIONS AND PRODUCTION OF MECHANICAL AS-BUILT (RECORD) DRAWINGS.

1.2 JOB CONDITIONS

A. SUBMITTAL OF BID IMPLIES BIDDER HAS READ APPLICABLE PARAGRAPHS OF THE SPECIFICATIONS AND WILL BE BOUND BY THEIR CONDITIONS.

1.3 LOCAL CONDITIONS

A. CONFORM WITH LOCAL CONDITIONS. COORDINATE WITH LOCAL UTILITIES ON SIZE OF UTILITY SERVICE. 1.4 INTENT

A. THE CONTRACT DOCUMENTS (DRAWINGS AND SPECIFICATIONS) DESCRIBE THE MECHANICAL WORK OF THIS PROJECT ANY ITEMS MENTIONED IN ONE PART SHALL BE AS BINDING AS THOUGH MENTIONED IN BOTH.

B. THE CONTRACT DOCUMENTS FORM A GUIDE FOR A COMPLETE MECHANICAL INSTALLATION. WHERE AN ITEM IS REASONABLY NECESSARY BUT NOT SPECIFICALLY MENTIONED, SUCH AS DUCT HANGERS OR TRANSITIONS, PIPING OFFSETS, DRAINS, ETC., FOR A COMPLETE SYSTEM, PROVIDE SAME.

C. MECHANICAL LAYOUTS INDICATED ON DRAWINGS ARE DIAGRAMMATIC ONLY. EXACT LOCATIONS OF DUCTS, AND EQUIPMENT SHALL BE GOVERNED BY THE DRAWINGS OF RELATED TRADES.

1.5 DEVIATIONS

A. NO DEVIATIONS FROM SPECIFICATIONS AND DRAWINGS SHALL BE MADE WITHOUT FULL KNOWLEDGE AND WRITTEN CONSENT OF CONSTRUCTION MANAGER.

B. SHOULD CONTRACTOR FIND, DURING PROGRESS OF WORK, CONDITIONS WHICH DICTATE A MODIFICATION OF ANY PARTICULAR REQUIREMENTS, REPORT SUCH ITEM PROMPTLY FOR DECISION OF INSPECTORS.

1.6 QUALITY ASSURANCE

A. COMPLY WITH APPLICABLE LOCAL, STATE AND FEDERAL CODES.

B. COMPLY WITH APPLICABLE REQUIREMENTS OF RECOGNIZED INDUSTRY ASSOCIATIONS WITH PROMULGATE STANDARDS FOR THE VARIOUS TRADES. (SEE INDIVIDUAL SECTIONS OF DIVISION 15.)

C. EMPLOY ONLY QUALIFIED JOURNEMENTRY FOR THIS WORK. EMPLOY COMPETENT, QUALIFIED MECHANICS TO SUPERVISE THE WORK.

1.7 CODES AND STANDARDS

A. PERFORM WORK SPECIFIED IN DIVISION 15 IN ACCORDANCE WITH THE APPLICABLE CODES AND STANDARDS LISTED BELOW, AND SUCH STANDARDS THAT MAY BE SPECIFIED IN OTHER SECTIONS. WHEN THESE SPECIFICATIONS ARE MORE STRINGENT, THEY TAKE PRECEDENCE. IN CASE OF CONFLICT, OBTAIN A DECISION FROM THE MECHANICAL ENGINEER.

1. NFPA 54: NATIONAL FUEL AND GAS CODE.
2. NFPA 90A: AIR CONDITIONING AND VENTILATION SYSTEMS.
3. NFPA 101: LIFE SAFETY CODE.
4. APPLICABLE STATE BUILDING CODE.
5. APPLICABLE STATE MECHANICAL CODE.
6. HANDICAPPED CODE ANSI A117.1 AND ADA
7. APPLICABLE STATE ENERGY CODE.
8. AGA: AMERICAN GAS ASSOCIATION.
9. ANSI: AMERICAN NATIONAL STANDARDS INSTITUTE.
10. ASH: AMERICAN REFRIGERATION INSTITUTE.
11. ASHRAE: AMERICAN SOCIETY OF HEATING, REFRIGERATION AND AIR CONDITIONING ENGINEERS.
12. ASME: AMERICAN SOCIETY FOR MECHANICAL ENGINEERS.
13. ASTM: AMERICAN SOCIETY FOR TESTING AND MATERIALS.
14. MSS: MANUFACTURER'S STANDARDIZATION SOCIETY OF THE VALVE AND FITTING INDUSTRY.
15. NFPA: NATIONAL FIRE PROTECTION ASSOCIATION.
16. SMACNA: SHEET METAL AND AIR CONDITIONING CONTRACTOR'S NATIONAL ASSOCIATION.
17. UL: UNDERWRITERS' LABORATORIES, INC.

1.8 COORDINATION

A. CAREFULLY EXAMINE SPECIFICATIONS AND DRAWINGS TO BE THOROUGHLY FAMILIAR WITH ITEMS WHICH REQUIRE HVAC CONNECTIONS AND COORDINATION.

B. COORDINATE WITH OTHER DIVISIONS TO LEAVE PROPER CHASES AND OPENINGS. PLACE OUTLETS, ANCHORS, SLEEVES, AND SUPPORTS PRIOR TO POURING CONCRETE OF INSTALLATION OF MASONRY WORK.

1.9 SUBMITTALS

A. SUBMITTALS ARE ONLY REQUIRED FOR SPECIFIC ITEMS OF EQUIPMENT OR MATERIAL LISTED IN INDIVIDUAL SECTIONS OF THESE SPECIFICATIONS.

B. WITHIN 15 DAYS AFTER AWARD OF CONTRACT FOR THIS WORK, SUBMIT A LIST OF PROPOSED MANUFACTURERS (OF EQUIPMENT OR MATERIAL TO BE USED) FOR APPROVAL. SUBMIT THIS LIST BEFORE SUBMITTAL OF SHOP DRAWINGS AND PRODUCT DATA, AND OBTAIN APPROVAL BEFORE SUBMITTING REQUIRED ITEMS.

C. SHOP DRAWINGS (NOT REQUIRED FOR OWNER FURNISHED EQUIPMENT).

1.10 DELIVERY AND STORAGE

A. INsofar AS POSSIBLE, DELIVER ITEMS IN MANUFACTURER'S ORIGINAL UNOPENED PACKAGING. WHERE THAT IS NOT PRACTICAL, COVER ITEMS WITH PROTECTIVE MATERIALS TO KEEP THEM FROM BEING DAMAGED. USE CARE IN LOADING, TRANSPORT, UNLOADING, AND STORAGE TO KEEP ITEMS FROM BEING DAMAGED.

1.11 FIRE RATINGS

A. MATERIALS USED ANYWHERE IN THE WORK MUST HAVE NFPA RATINGS AS FOLLOWING:

1. FLAME SPREAD - NOT OVER 25
2. SMOKE DEVELOPED - NOT OVER 50
3. FUEL CONTRIBUTED - NOT OVER 25

B. MATERIALS SHALL BE "SELF EXTINGUISHING".

1.12 PERMITS AND FEES

A. OBTAIN, PAY FOR, AND DELIVER PERMITS, CERTIFICATION OF INSPECTION, AND OTHER SUCH ITEMS REQUIRED BY THE AUTHORITIES HAVING JURISDICTION. DELIVER CERTIFICATION TO THE CONSTRUCTION MANAGER PRIOR TO FINAL ACCEPTANCE OF THE WORK. AN INSPECTION CERTIFICATE FOR EACH CLASS OF WORK REQUIRING INSPECTION MUST BE SUBMITTED PRIOR TO OR WITH THE FINAL PAYMENT INVOICE. THE RESPONSIBLE TRADE CONTRACTOR MUST MAKE APPLICATION FOR THE INSPECTION, COORDINATE SAME AND PAY THE REQUIRED INSPECTION FEE.

1.13 EXTENDED WARRANTIES

A. WORK FURNISHED UNDER THE CONTRACT SHALL BE WARRANTED AGAINST DEFECTS IN WORKMANSHIP AND (CONTRACTOR FURNISHED) MATERIALS FOR A PERIOD OF NOT LESS THAN ONE (1) YEAR, OR AS OTHERWISE SPECIFIED, FROM THE DATE OF FINAL ACCEPTANCE OF THE INSTALLATION, DEFECTS OF WORKMANSHIP DEVELOPING DURING THIS PERIOD SHALL BE REMEDIED, AND DEFECTIVE MATERIAL REPLACED, WITHOUT ADDITIONAL COST. WHEN DEFECTS IN A TRADE CONTRACTOR'S WORK CAUSES DAMAGE TO THE WORK OF THE OTHER TRADE CONTRACTORS, SUCH DAMAGE SHALL BE REPAIRED BY THE TRADE CONTRACTOR CAUSING DAMAGE AND WORK RESTORED TO ITS ORIGINAL CONDITION, AT THE EXPENSE OF THE TRADE CONTRACTOR THAT CAUSED THE DAMAGE.

GENERAL MECHANICAL NOTES

PART 2 --PRODUCTS 2.1
MATERIALS AND EQUIPMENT

A. WITHIN THE CONTRACT DOCUMENTS RELATING TO MECHANICAL WORK, MANUFACTURER'S NAMES, CATALOG NUMBERS, AND OTHER PROPRIETARY REFERENCES TO MATERIALS AND EQUIPMENT ARE MADE. SUCH REFERENCES ARE MADE TO ESTABLISH THE STANDARDS OF QUALITY AND TYPE REQUIRED, AND NOT TO LIMIT COMPETITION. ACCEPTABLE MANUFACTURER'S OF COMPETITIVE PRODUCTS ARE LISTED IN APPLICABLE SECTIONS AS "APPROVED EQUALS". REASONABLE REQUESTS FOR SUBSTITUTION OR ADDITIONS TO "APPROVED EQUALS" WILL BE CONSIDERED, BUT THE MECHANICAL ENGINEER WILL BE THE SOLE JUDGE OF ACCEPTABILITY OF ITEMS PROPOSED AS SUBSTITUTES.

B. MATERIALS AND EQUIPMENT USED IN CARRYING OUT THESE SPECIFICATIONS SHALL BEAR UL OR OTHER RECOGNIZED TESTING LABORATORY LABEL WHEN SUCH LABELS ARE AVAILABLE.

PART 3 -- EXECUTION

3.1 LOCATIONS

A. MECHANICAL LAYOUTS INDICATED ON DRAWINGS ARE DIAGRAMMATIC. EXACT LOCATIONS OF DUCT, AND EQUIPMENT MAY VARY BECAUSE OF CONFLICTS WITH WORK OF OTHER TRADES. WORK OUT CONFLICTS WHERE RELOCATION'S WILL NOT AFFECT OPERATION OR APPEARANCE OF SYSTEMS.

B. LOCATE EQUIPMENT REQUIRING PERIODIC SERVICING SO THAT IT IS READILY ACCESSIBLE. DO NOT BACK UP SERVICE SIDES TO WALLS, NOR PLACE IT TOO CLOSE TO OTHER EQUIPMENT TO MAKE SERVICE IMPRACTICAL. EQUIPMENT SERVICE CLEARANCE SHALL MEET MINIMUM ACCEPTABLE DISTANCE AS RECOMMENDED BY EQUIPMENT MANUFACTURER.

3.2 UTILITIES EXCAVATING AND BACKFILLING

A. PERFORM TRENCHING, EXCAVATING, BACKFILLING FOR MECHANICAL WORK IN ACCORDANCE WITH THE APPROPRIATE SECTIONS AND AS SET FORTH BELOW

1. PERFORM WORK NECESSARY FOR INSTALLATION OF MECHANICAL UTILITIES.

2. DEPTH OF EXCAVATION TO PROVIDE A MINIMUM OF 3' ABOVE TOP OF PIPE. EXCAVATION TO BE CARRIED TO A DEPTH OF AT LEAST 6" BELOW BOTTOM OF PIPE ELEVATION. FILL BELOW PIPE (6"), AROUND PIPE, AND A MINIMUM OF 12" ABOVE PIPE WITH SAND OR CLASS "B" CRUSHED STONE TAMPED FIRM AND EVEN. SEPARATE TOPSOIL DURING EXCAVATION. FINAL LAYER OR DIRT (12" MINIMUM) TO BE TOPSOIL. TRENCHES TO BE AT LEAST 18" WIDER THAN PIPE WITH BATTER BOARDS PLACED EVERY 25'. BACKFILLING SHALL BE DONE TO EXCLUDE USE OF ROCK OR STONE ABOVE SAND OR CRUSHED STONE.

3.3 CUTTING AND PATCHING

A. REPAIR OR REPLACE ROUTINE DAMAGE CAUSED BY CUTTING IN PERFORMANCE OF CONTRACT.

B. CORRECT UNNECESSARY DAMAGE CAUSED DUE TO INSTALLATION OF MECHANICAL WORK.

C. PERFORM TRENCHING WITH MATERIALS WHICH MATCH EXISTING AND INSTALL IN ACCORDANCE WITH THE APPROPRIATE SECTION OF THESE SPECIFICATIONS OR THE BEST STANDARDS OF THE INDUSTRY.

3.4 CONNECTION TO EQUIPMENT

A. CONNECT OR INSTALL EQUIPMENT SHOWN ON MECHANICAL DRAWINGS THAT REQUIRE MECHANICAL HOOKUPS.

3.5 SERVICE OF SYSTEM

A. IF EQUIPMENT IS PLACED IN SERVICE PRIOR TO ACCEPTANCE OF THE PROJECT, OPERATE EQUIPMENT STRICTLY IN ACCORDANCE WITH MANUFACTURER'S INSTRUCTIONS. INSTALL NEW FILTERS IN EQUIPMENT PRIOR TO OWNER OCCUPANCY BUILDING

B. EMPLOY COMPETENT, QUALIFIED PERSONNEL IN OPERATION OF THE EQUIPMENT.

C. PROVIDE FOR PROPER OPERATION AND CLEANLINESS.

D. OPEN UP EQUIPMENT FOR INSPECTION AS DIRECTED BY THE SUPERINTENDENT.

E. LUBRICATE EQUIPMENT AND PERFORM SUCH OTHER MAINTENANCE AS REQUIRED TO PLACE IT IN FIRST CLASS OPERATING CONDITION.

END OF SECTION

SECTION 2

HEATING, VENTILATION AND AIR CONDITIONING PART 1 -- GENERAL 1.1 RELATED DOCUMENTS

A. REFER TO DRAWINGS AND CONTRACT FOR MATERIALS FURNISHED BY OWNER, INSTALLED BY CONTRACTOR OR FURNISHED AND INSTALLED BY OWNER.

1.2 SCOPE OF WORK

A. FURNISH ALL LABOR, SUPERVISION, AND EQUIPMENT (UNLESS EQUIPMENT IS SPECIFICALLY NOTED AS 'OWNER FURNISHED') FOR THE COMPLETE INSTALLATION OF HEATING, VENTILATION, AND AIR CONDITIONING SYSTEM TOGETHER WITH ALL NECESSARY AUXILIARIES AND APPURTENANCES.

1.3 QUALITY ASSURANCE

A. MANUFACTURER'S QUALIFICATIONS -- INSTALL PACKAGED UNITS, AS INDICATED IN THE DRAWINGS, IN ACCORDANCE WITH MANUFACTURER'S INSTRUCTIONS AND REQUIREMENTS. PROVIDE RELATED PRODUCTS AND ACCESSORIES FROM ONE MANUFACTURER. STORE MATERIALS IN ACCORDANCE WITH MANUFACTURER'S RECOMMENDATION PROTECTING FROM DIRT, MOISTURE, CONTAMINANTS, AND WEATHER.

B. CODES AND STANDARDS -- PERFORM ALL INSTALLATION IN ACCORDANCE WITH THE LATEST STANDARDS AS RECOGNIZED BY ASHRAE, SMACNA AND ALL APPLICABLE STATE AND LOCAL CODES AND ORDINANCES.

C. WORKMANSHIP -- EXPERIENCED, WELL -- TRAINED WORKERS, COMPETENT TO COMPLETE THE WORK AS SPECIFIED, SHALL PERFORM LABOR IN CONFORMANCE WITH GENERALLY ACCEPTED TRADE STANDARDS. INSTALL ALL EQUIPMENT SQUARE AND PLUMB ALLOWING ACCESS FOR PROPER OPERATION, ADJUSTMENT AND SERVICE.

1.4 STRUCTURAL AND SPACE CONDITIONS

A. ALL WORK SHALL AVOID OBSTRUCTIONS AND INTERFERENCE WITH OTHER TRADES, PRESERVE HEADROOM AND KEEP OPENINGS AND PASSAGeways CLEAR AND FREE.

1.5 VIBRATION AND NOISE

A. INSTALL EACH OF THE VARIOUS PIECES OF EQUIPMENT TO OPERATE WITHOUT OBJECTIONABLE VIBRATION OR NOISE.

1.7 CUTTING AND PATCHING

A. CUTTING OR PATCHING NECESSARY TO PERMIT THE INSTALLATION OF ANY WORK UNDER THIS CONTRACT SHALL BE THE RESPONSIBILITY OF THIS TRADE. CUTTING AND PATCHING SHALL BE COORDINATED WITH OTHER TRADES SO AS NOT TO IMPACT OTHER WORK

1.8 BALANCE AND TESTING

A. TEST AND BALANCE SHALL BE PERFORMED BY A NATIONALLY QUALIFIED TEST AND BALANCE COMPANY. BALANCE COMPANY SHALL BE AN NEBB COMPANY.

B. CONTRACTOR SHALL COORDINATE TESTING WITH THE TESTING AND BALANCE COMPANY. ALL SYSTEMS SHALL BE FULLY OPERATIONAL PRIOR TO COMMENCEMENT OF TESTING. CORRECT ALL DEFICIENCIES NOTED IN THE TEST AND BALANCE REPORT WITHIN THREE DAYS OR PRIOR TO ACCEPTANCE OF THE PROJECT.

C. ASSUME RESPONSIBILITY FOR CORRECTING ALL ITEMS DETERMINED TO BE THE RESULT OF IMPROPER OR INCOMPLETE INSTALLATION. EXTRA TESTING REQUIRED DUE TO SUCH DEFICIENCIES WILL BE AT CONTRACTOR'S EXPENSE.

D. CONTRACTOR SHALL BE RESPONSIBLE FOR PROVIDING TEST REPORTS TO THE LOCAL BUILDING AND HEALTH DEPARTMENTS AS REQUIRED FOR CERTIFICATE OF OCCUPANCY.

PART 2 - PRODUCTS

2.1 AIR CONDITIONING UNITS, FANS AND AIR DEVICES

A. SHALL BE AS INDICATED ON THE DRAWINGS.

2.2 DUCTWORK

A. RECTANGULAR AND ROUND DUCT FABRICATION, GENERAL - EXCEPT AS OTHERWISE INDICATED, FABRICATE RECTANGULAR AND ROUND DUCTS WITH GALVANIZED SHEET STEEL, IN ACCORDANCE WITH SMACNA - HVAC DUCT CONSTRUCTION STANDARDS AND TABLES INCLUDING THEIR ASSOCIATED DETAILS. CONFORM TO THE REQUIREMENTS IN THE REFERENCED STANDARD FOR METAL THICKNESS, REINFORCING TYPES AND INTERVALS, TIE ROD APPLICATIONS, AND JOINT TYPES AND INTERVALS. AN APPROVED FLEXIBLE DUCT MAY BE USED FOR THE LAST 5 FT. CONNECTION TO REGISTERS.

2.3 DUCT ACCESS PANELS AND DOORS

A. IN SHEET METAL WORK, HOLLOW CORE DOUBLE CONSTRUCTION OF SAME OR HEAVIER GAGE MATERIAL AS DUCT IN WHICH INSTALLED, PRODUCTS BY CESCO, VENT PRODUCTS, AIR BALANCE, OR EQUIVALENT.

1. PROVIDE VENTLOK OR APPROVED HINGES AND LATCHES ON ALL DOORS; 100 SERIES HINGES AND LATCHES ON LOW PRESSURE SYSTEM DOORS UP TO 18" MAXIMUM DIMENSION, 200 SERIES ON LARGER LOW PRESSURE SYSTEM DOORS AND 333 SERIES ON HIGH PRESSURE SYSTEMS.

2. CONSTRUCT DOORS UP TO 18" MAXIMUM DIMENSION WITH ONE INCH OVERLAP FIT AND GASKET WITH 3/4" BY 1/8" SPONGE RUBBER, FIT LARGER DOORS AGAIN 1-1/2" BY 1/8" FLAT STOCK OR ANGLE FRAME AND GASKET WITH 3/4" BY 1/8" SPONGE RUBBER OR FELT

3. DOOR SWING TO BE OPPOSITE OF AIRFLOW.

2.4 DUCTWORK SPECIALTIES

A. VOLUME AND SPLITTER DAMPERS

1. GALVANIZED SHEET METAL BLADE AND FRAME WITH VENTFABRICS INC. VENTLOK OPERATING HARDWARE.

2. FOR ACCESSIBLE DAMPERS, PROVIDE #641 SELF - LOCKING DIAL REGULATORS AND #644 SELF - LOCKING DIAL REGULATORS FOR INSULATED DUCTWORK, #637 SQUARE END BEARING, AND #635 SPRING END BEARING, AS APPLICABLE

3. FOR INACCESSIBLE DAMPERS, PROVIDE #666 OR #667 CONCEALED LOCKING DAMPER REGULATOR WITH BEARING AS ABOVE. FOR STATIC PRESSURES ABOVE 3" W.G., PROVIDE #640 HVEL DIAL REGULATOR AND #609 HVEL END BEARING FOR ACCESSIBLE DAMPERS.

B. MULTI - LOUVER VOLUME DAMPERS

1. 16 - GAUGE GALVANIZED STEEL FRAME. OPPOSED, 6" WIDE, 16 - GAUGE GALVANIZED STEEL BLADES. CONCEALED LINKAGE IN FRAME.

2. TITUS #A2 - 35 - B, RUSKIN #CD35/ OBD OR EQUAL

C. FLEXIBLE CONNECTIONS

1. PROVIDE FLEXIBLE CONNECTORS AT THE DISCHARGE AND INLET OF FANS, AIR HANDLERS, ROTATING MECHANICAL EQUIPMENT, AND WHERE SHOWN IN THE DRAWINGS FOR PROPER VIBRATION ISOLATION.

2. NEOPRENE IMPREGNATED GLASS CLOTH WITH 24 - GAUGE GALVANIZED METAL FRAME. MINIMUM DIMENSIONS - 3" METAL, 3" FABRIC, 3" METAL.

3. DURO DYNE #4M4, VENT FABRICS #VENTGLAS, Q INDUSTRIES, CONSOLIDATED KINETICS, ELGEN, OR EQUAL

D. BUCKRAFT DAMPERS

1. PROVIDE COUNTERWEIGHT TYPE COMPLETE WITH FRAME, END BEARING, COUNTERBALANCE ASSEMBLY, BLADES, AND LINKAGE.

2. INSTALL AT OUTSIDE AIR INTAKE, EXHAUST OUTLETS, AND WHERE SHOWN ON DRAWINGS.

3. PACIFIC AIR PRODUCTS #PRD - 100AL, RUSKIN #CBS - 7 OR EQUAL BY AMERICAN WARMING. OR VENT PRODUCTS.

E. TURNING VANES 1.PROVIDE TURNING VANES AT ALL 90° AND 45° SQUARE ELBOWS. TURNING VANES SHALL BE DOUBLE WALL AIR FOIL TYPE CONSTRUCTED AND INSTALLED AS PER SMACNA.

2.5 DUCT INSULATION

A. ACCEPTABLE MANUFACTURERS: PROVIDE PRODUCTS OF THE FOLLOWING MANUFACTURES, COMPLYING WITH SPECIFIED REQUIREMENTS. EQUIVALENT PRODUCTS OF OTHER MANUFACTURERS WILL BE CONSIDERED.

1. OWENS - CORNING FIBERGLAS CORP.

2. MANVILLE PRODUCTS CORP.

3. CERTAINTED CORP.

B. ALL INSULATION MATERIAL SHALL COMPLY WITH APPLICABLE ENERGY CONSERVATION REGULATION FOR PROJECT LOCATION.

C. PROVIDE COMPOSITE MECHANICAL INSULATION (INSULATION, JACKET, COVERINGS, SEALERS, MASTICS, AND ADHESIVES) WITH FLAME - SPEED INDEX OF 25 OR LESS, AND SMOKE - DEVELOPED INDEX OF 50 OR LESS, AS TESTED BY ASTM E84 (NFA 255) METHOD.

D. PROVIDE STAPLES, BANDS, WIRES, TAPE, ANCHORS, CORNER ANGLES AND SIMILAR ACCESSORIES AS RECOMMENDED BY INSULATION MANUFACTURER FOR APPLICATIONS INDICATED.

E. PROVIDE CEMENTS, ADHESIVES, COATINGS, SEALERS, PROTECTIVE FINISHES, AND SIMILAR COMPOUNDS AS RECOMMENDED BY INSULATION MANUFACTURER FOR APPLICATIONS INDICATED.

2.6 REFRIGERANT PIPING

A. REFRIGERANT PIPING TO BE COPPER SEAMLESS, VACUUM PACKED TUBING.

B. ALL SUCTION LINES TO SLOPE BACK TOWARDS CONDENSING UNIT.

C. ALL SUCTION LINES HEADING UP TOWARDS CONDENSING UNIT SHALL HAVE A "P" TRAP.

D. PROVIDE SIGHT GLASS AND FILTER DRIER ON LIQUID LINES AT CONDENSING UNITS.

E. ALL REFRIGERANT PIPING UNDERGROUND TO BE CONTAINED IN A PVC SLEEVE.

F. REFRIGERANT PIPING TO BE SIZED AND INSTALLED AS PER EQUIPMENT MANUFACTURERS RECOMMENDATIONS.

G. REFRIGERANT PIPING TO BE INSULATED WITH ARMAFLEX INSULATION.

H. INSTALL AIREX PRO-SYSTEM KIT AIR-TIGHT SEALING WITH A WALL-MOUNTED PIPING OUTLET AND A UV/VAPOR RETARDER PIPING INSULATION PROTECTOR FOR EXTERIOR APPLICATIONS OF HVAC REFRIGERANT PIPING WALL PENETRATIONS AND OUTDOOR INSULATION. NO ARMAFLEX ALLOWED

2.7 HVAC CONTROLS

A. SHALL BE AS INDICATED ON THE DRAWINGS.

B. ELECTRIC AND ELECTRONIC HVAC CONTROLS - COMPONENTS AND OPERATING FEATURES AS INDICATED ON THE DRAWINGS.

PART 3 - EXECUTION

3.1 HVAC SYSTEM INSTALLATION, GENERAL SEQUENCE, COORDINATE, AND INTEGRATE THE VARIOUS ELEMENTS OF MECHANICAL SYSTEMS, MATERIALS, AND EQUIPMENT. COMPLY WITH THE FOLLOWING REQUIREMENTS

1. COORDINATE MECHANICAL SYSTEMS, EQUIPMENT, AND MATERIALS WITH OTHER BUILDING COMPONENTS.

2. VERIFY ALL DIMENSIONS BY FIELD MEASUREMENTS.

3. ARRANGE FOR CHASES, SLOTS, AND OPENINGS IN OTHER BUILDING COMPONENTS DURING PROGRESS OF CONSTRUCTION, TO ALLOW FOR MECHANICAL INSTALLATIONS.

4. COORDINATE THE INSTALLATION OF REQUIRED SUPPORTING DEVICES AND SLEEVES TO BE SET IN POURED IN PLACE CONCRETE AND OTHER STRUCTURAL COMPONENTS, AS THEY ARE CONSTRUCTED.

5. SEQUENCE, COORDINATE, AND INTEGRATE INSTALLATIONS OF MECHANICAL MATERIALS AND EQUIPMENT FOR EFFICIENT FLOW OF THE WORK. GIVE PARTICULAR ATTENTION TO LARGE EQUIPMENT REQUIRING POSITIONING PRIOR TO CLOSING IN THE BUILDING.

6. WHERE MOUNTING HEIGHTS ARE NOT DETAILED OR DIMENSIONED, INSTALL SYSTEMS, MATERIALS, AND EQUIPMENT TO PROVIDE THE MAXIMUM HEADROOM POSSIBLE.

7. COORDINATE CONNECTION OF MECHANICAL SYSTEMS WITH EXTERIOR UNDERGROUND AND OVERHEAD UTILITIES AND SERVICES. COMPLY WITH REQUIREMENTS OF GOVERNING REGULATIONS, FRANCHISED SERVICE COMPANIES, AND CONTROLLING AGENCIES. PROVIDE REQUIRED CONNECTION FOR EACH SERVICE.

8. INSTALL SYSTEMS, MATERIALS, AND EQUIPMENT TO CONFORM WITH DRAWINGS AND SPECS, TO GREATEST EXTENT POSSIBLE. CONFORM TO ARRANGEMENTS INDICATED BY THE CONTRACT DOCUMENTS, RECOGNIZING THAT PORTIONS OF THE WORK ARE SHOWN ONLY IN DIAGRAMMATIC FORM. WHERE COORDINATION REQUIREMENTS CONFLICT WITH INDIVIDUAL SYSTEM REQUIREMENTS, REFER CONFLICT TO THE CONTRACTOR FOR RESOLUTION PRIOR TO INSTALLATION.

9. INSTALL SYSTEMS, MATERIALS, AND EQUIPMENT LEVEL AND PLUMB, PARALLEL AND PERPENDICULAR TO OTHER BUILDING SYSTEMS AND COMPONENTS, WHERE INSTALLED EXPOSED IN FINISHED SPACES


10. INSTALL MECHANICAL EQUIPMENT TO FACILITATE SERVICING, MAINTENANCE, AND REPAIR OR REPLACEMENT OF EQUIPMENT COMPONENTS. AS MUCH AS PRACTICAL.

THE ENGINEER'S RESPONSIBILITY IS TO PREPARE AND SUBMIT TO THE OWNER, FOR REVIEW AND APPROVAL, A SET OF DRAWINGS THAT COMPLY WITH THE PROJECT REQUIREMENTS AND THE LATEST EDITIONS OF THE CALIFORNIA BUILDING CODES AND REGULATIONS. THE ENGINEER'S RESPONSIBILITY IS NOT TO GUARANTEE THE ACCURACY OF THE INFORMATION PROVIDED BY THE OWNER OR TO GUARANTEE THE ACCURACY OF THE INFORMATION PROVIDED BY THE OWNER'S ARCHITECT. THE ENGINEER'S RESPONSIBILITY IS NOT TO GUARANTEE THE ACCURACY OF THE INFORMATION PROVIDED BY THE OWNER'S ARCHITECT. THE ENGINEER'S RESPONSIBILITY IS NOT TO GUARANTEE THE ACCURACY OF THE INFORMATION PROVIDED BY THE OWNER'S ARCHITECT.



OVERALL FLOOR PLAN

SCALE: 1/8" = 1'-0"

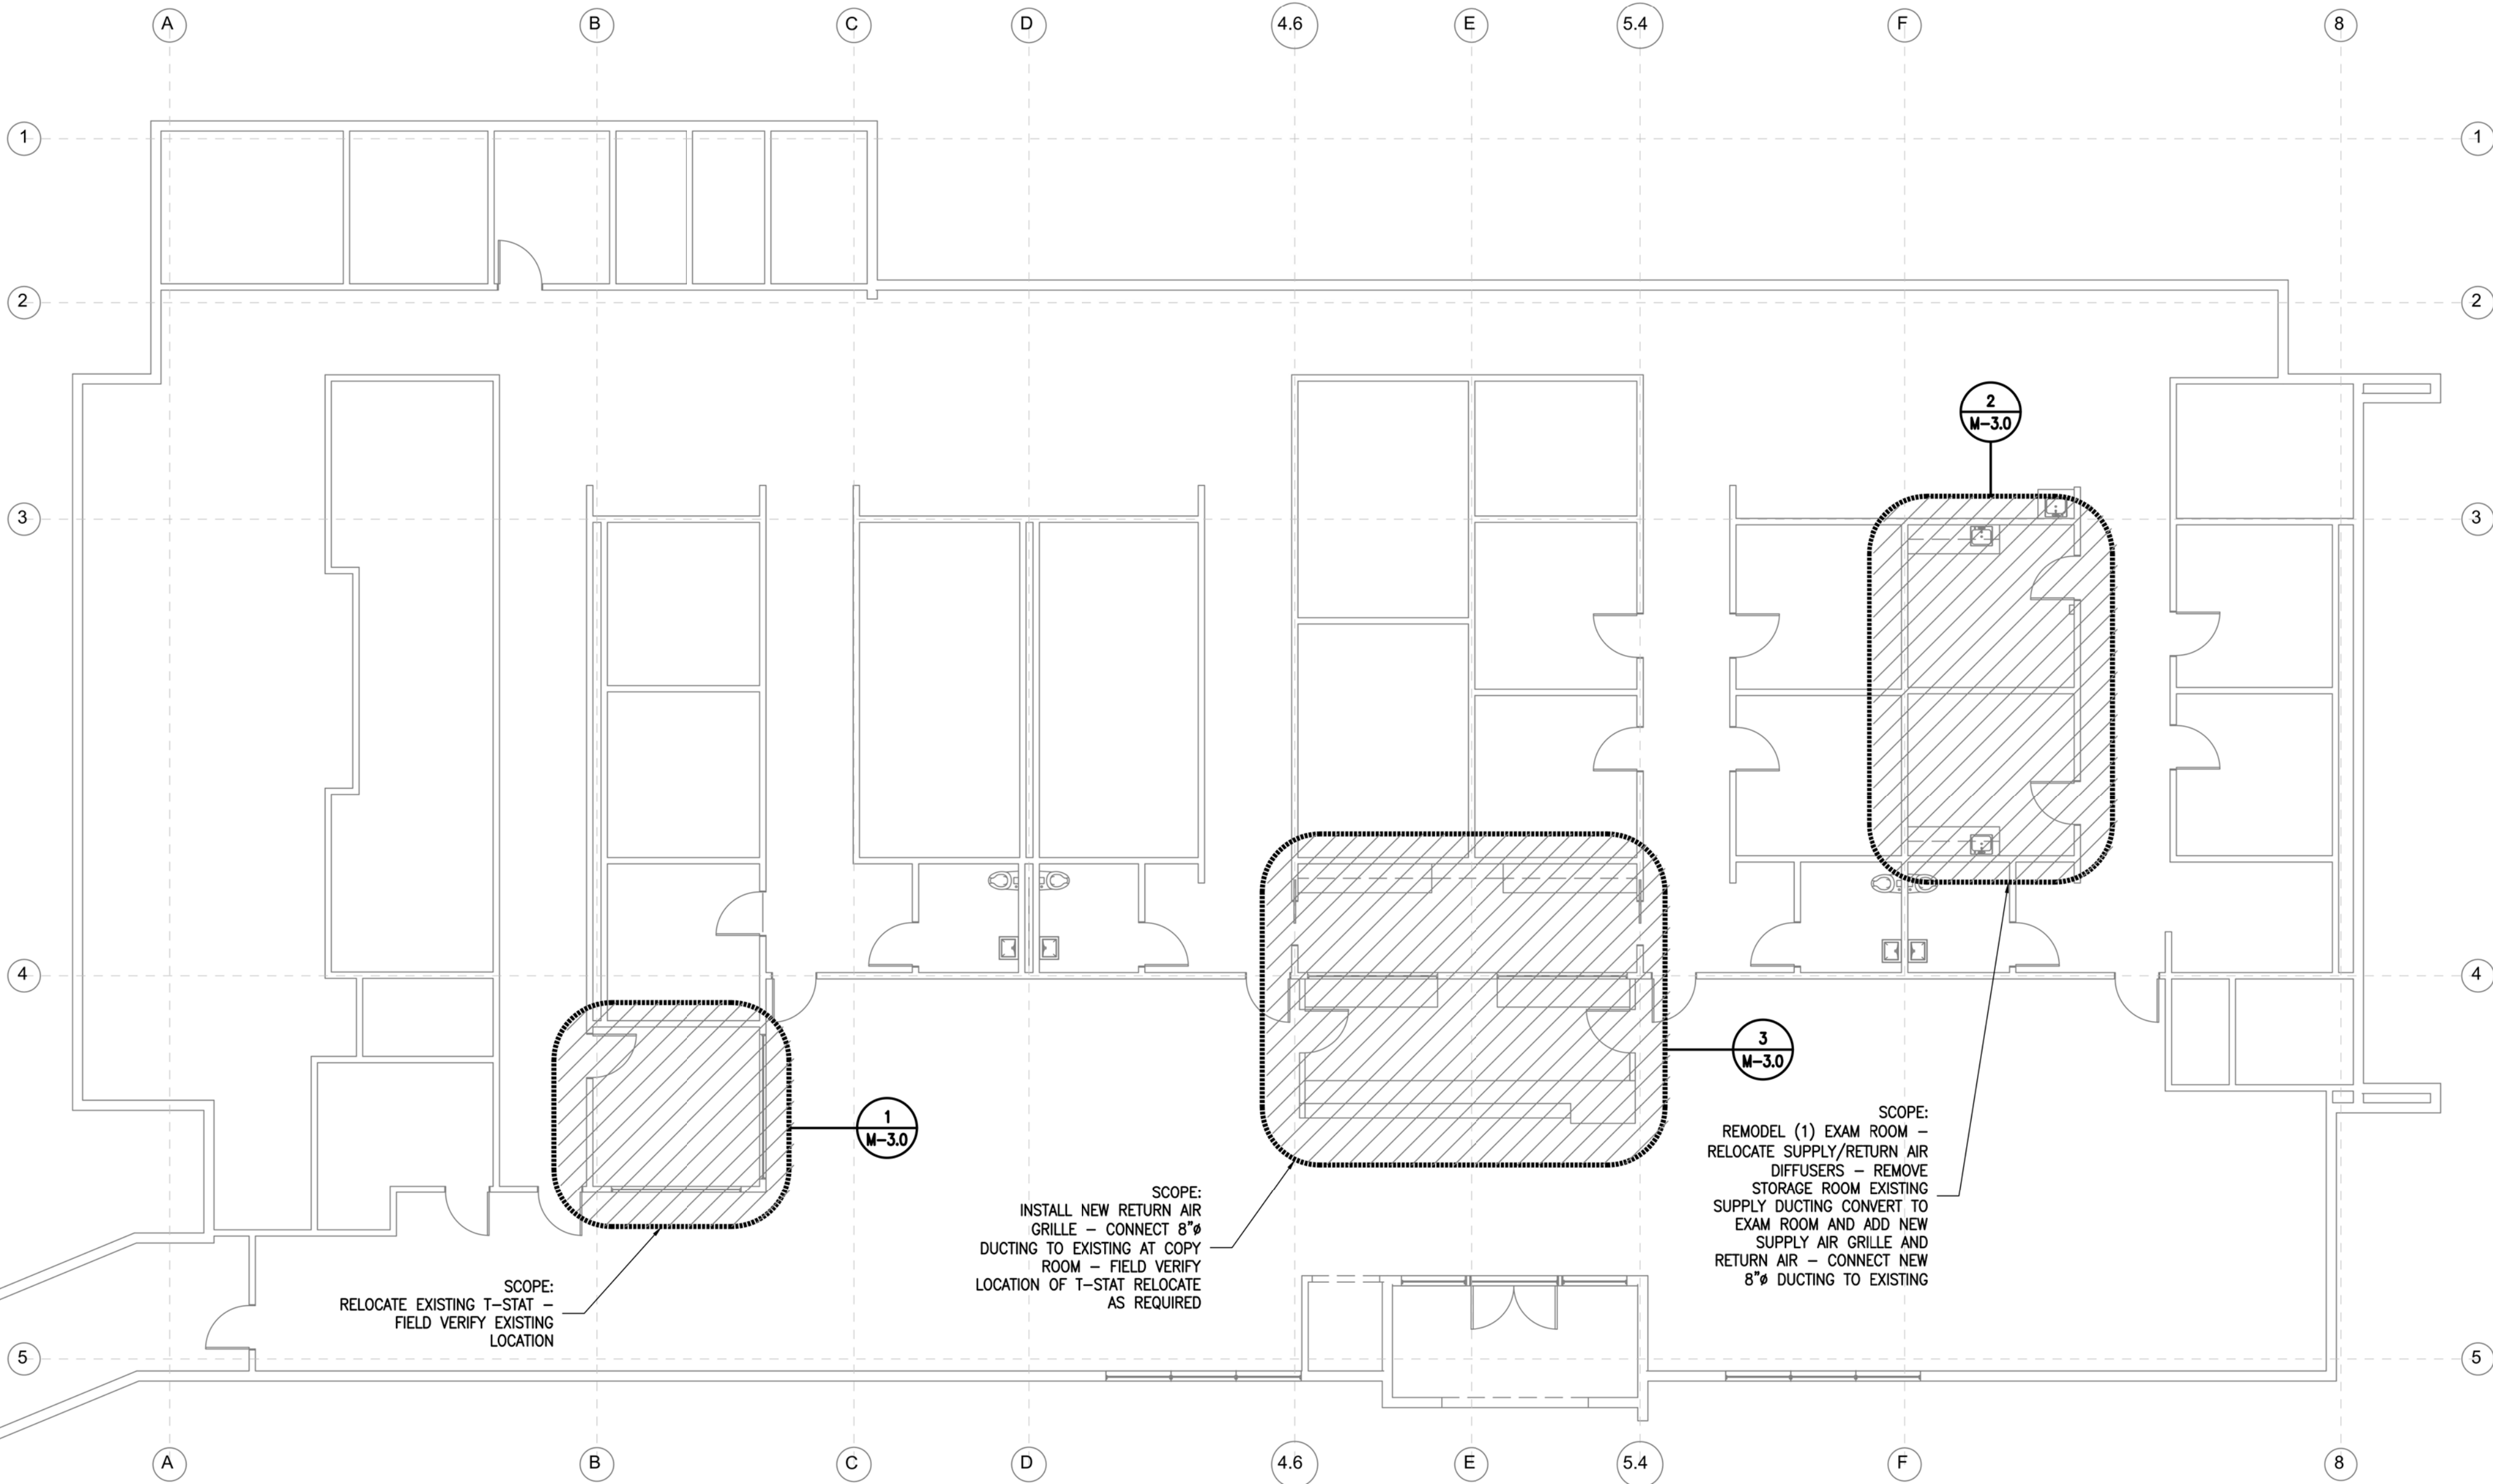

CANTELM ENGINEERING
MECHANICAL/ELECTRICAL
LICENSE #21180
2130 F STREET BAKERSFIELD, CA 93301
TEL: (661) 324-5252 FAX: (661) 324-8439 canteim@cantelmi.net

WEST SIDE FAMILY HEALTH CARE
100 EAST NORTH STREET,
TFT, CA


DATE	ISSUED

DATE	MARK	ISSUED

DWG. BY	
CHKD BY	F.C.
DATE	2/11/2025
JOB NO.	C24-189
FILE NO.	C24-189 MECH.DWG



SHEET
M2.0
SHEET

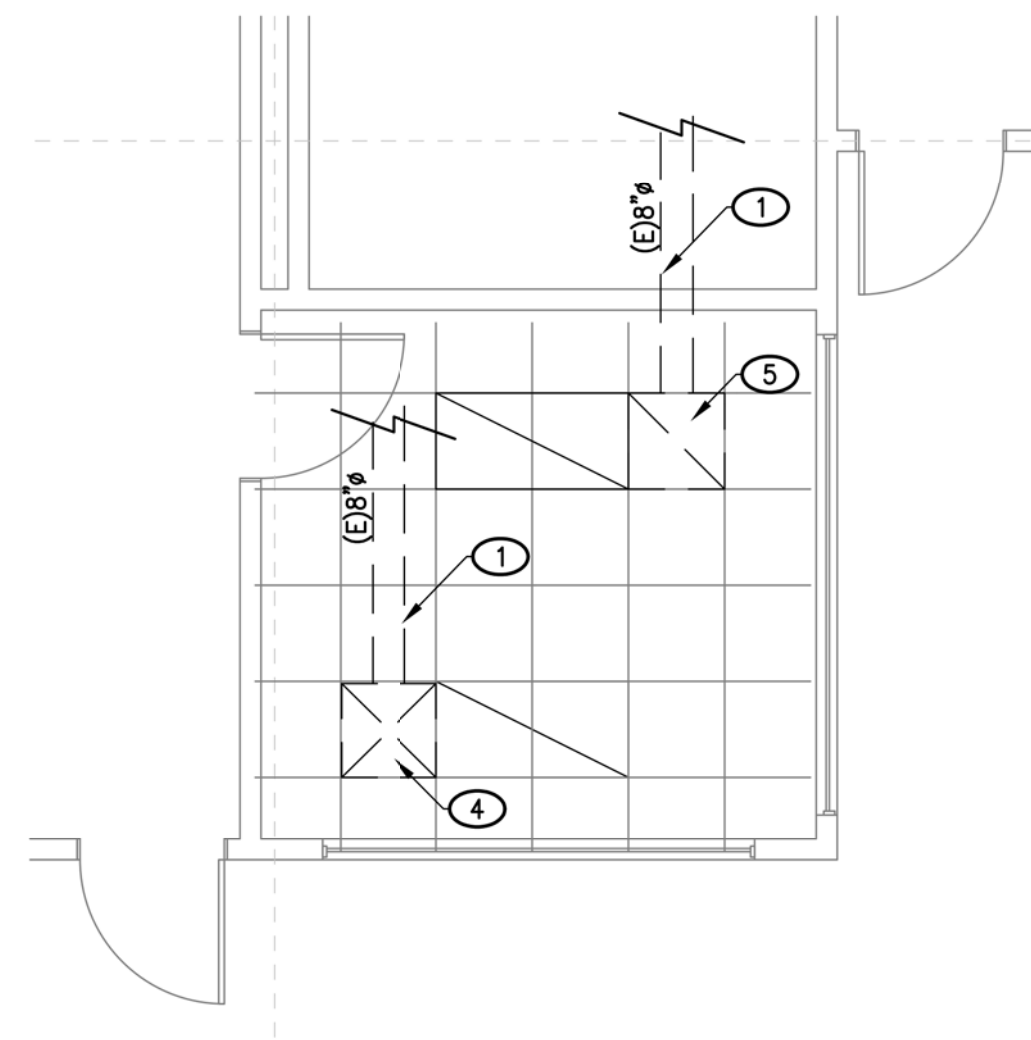[illegible]


1 - PARTIAL MECHANICAL PLAN SCALE: 1/4" = 1'-0"

ROOM 1 - ADMINISTRATION

- ## KEYNOTES


KEYNOTES LISTED BELOW PERTAIN TO PLAN ON THIS SHEET ONLY. KEYNOTES FROM THIS LIST THAT ARE NOT KEYED SHALL BE DISREGARDED. ITEMS NOT IDENTIFIED WITH A KEYNOTE BUT DRAWN SIMILAR TO THOSE ITEMS KEYNOTED SHALL BE CONSIDERED AS THOUGH THEY ARE KEYNOTED, CONSISTANT WITH LIKE KEYNOTED ITEMS.

- ① EXISTING DUCTING TO REMAIN
- ② INSTALL NEW 22"x22" RETURN AIR DIFFUSER W/8"DUCT - CONNECT TO EXISTING AC UNIT
- ③ INSTALL NEW 22"x22" SUPPLY AIR GRILL W/8"DUCT - CONNECT TO EXISTING AC UNIT
- ④ EXISTING SUPPLY AIR DIFFUSER TO REMAIN
- ⑤ EXISTING RETURN AIR GRILLE TO REMAIN
- ⑥ EXISTING SUPPLY AIR GRILLE AND DUCTING TO BE REMOVED AND CAPPED AT BRANCH LINE
- ⑦ POINT OF CONNECTION TO EXISTING DUCTING - FIELD VERIFY LOCATION

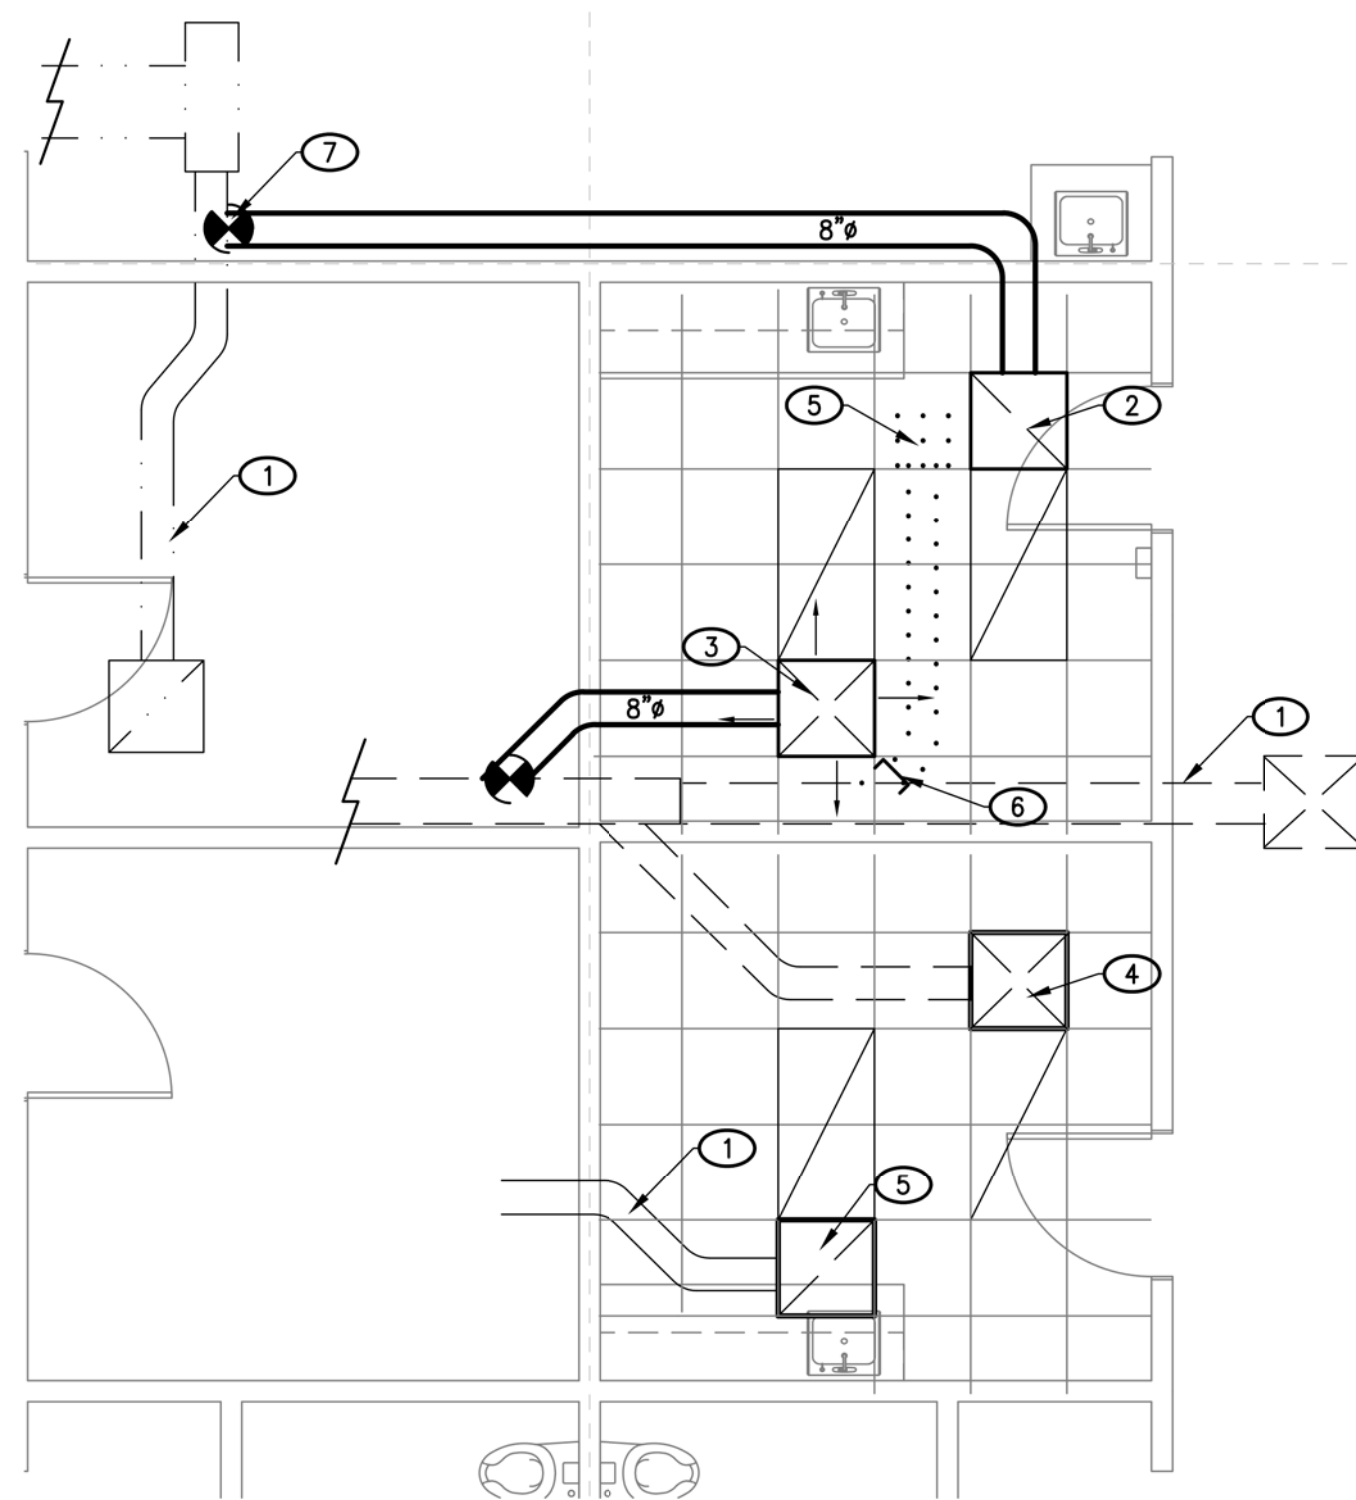

2 - PARTIAL MECHANICAL PLAN SCALE: 1/4" = 1'-0"

ROOM 2 & 3 - EXAM ROOMS

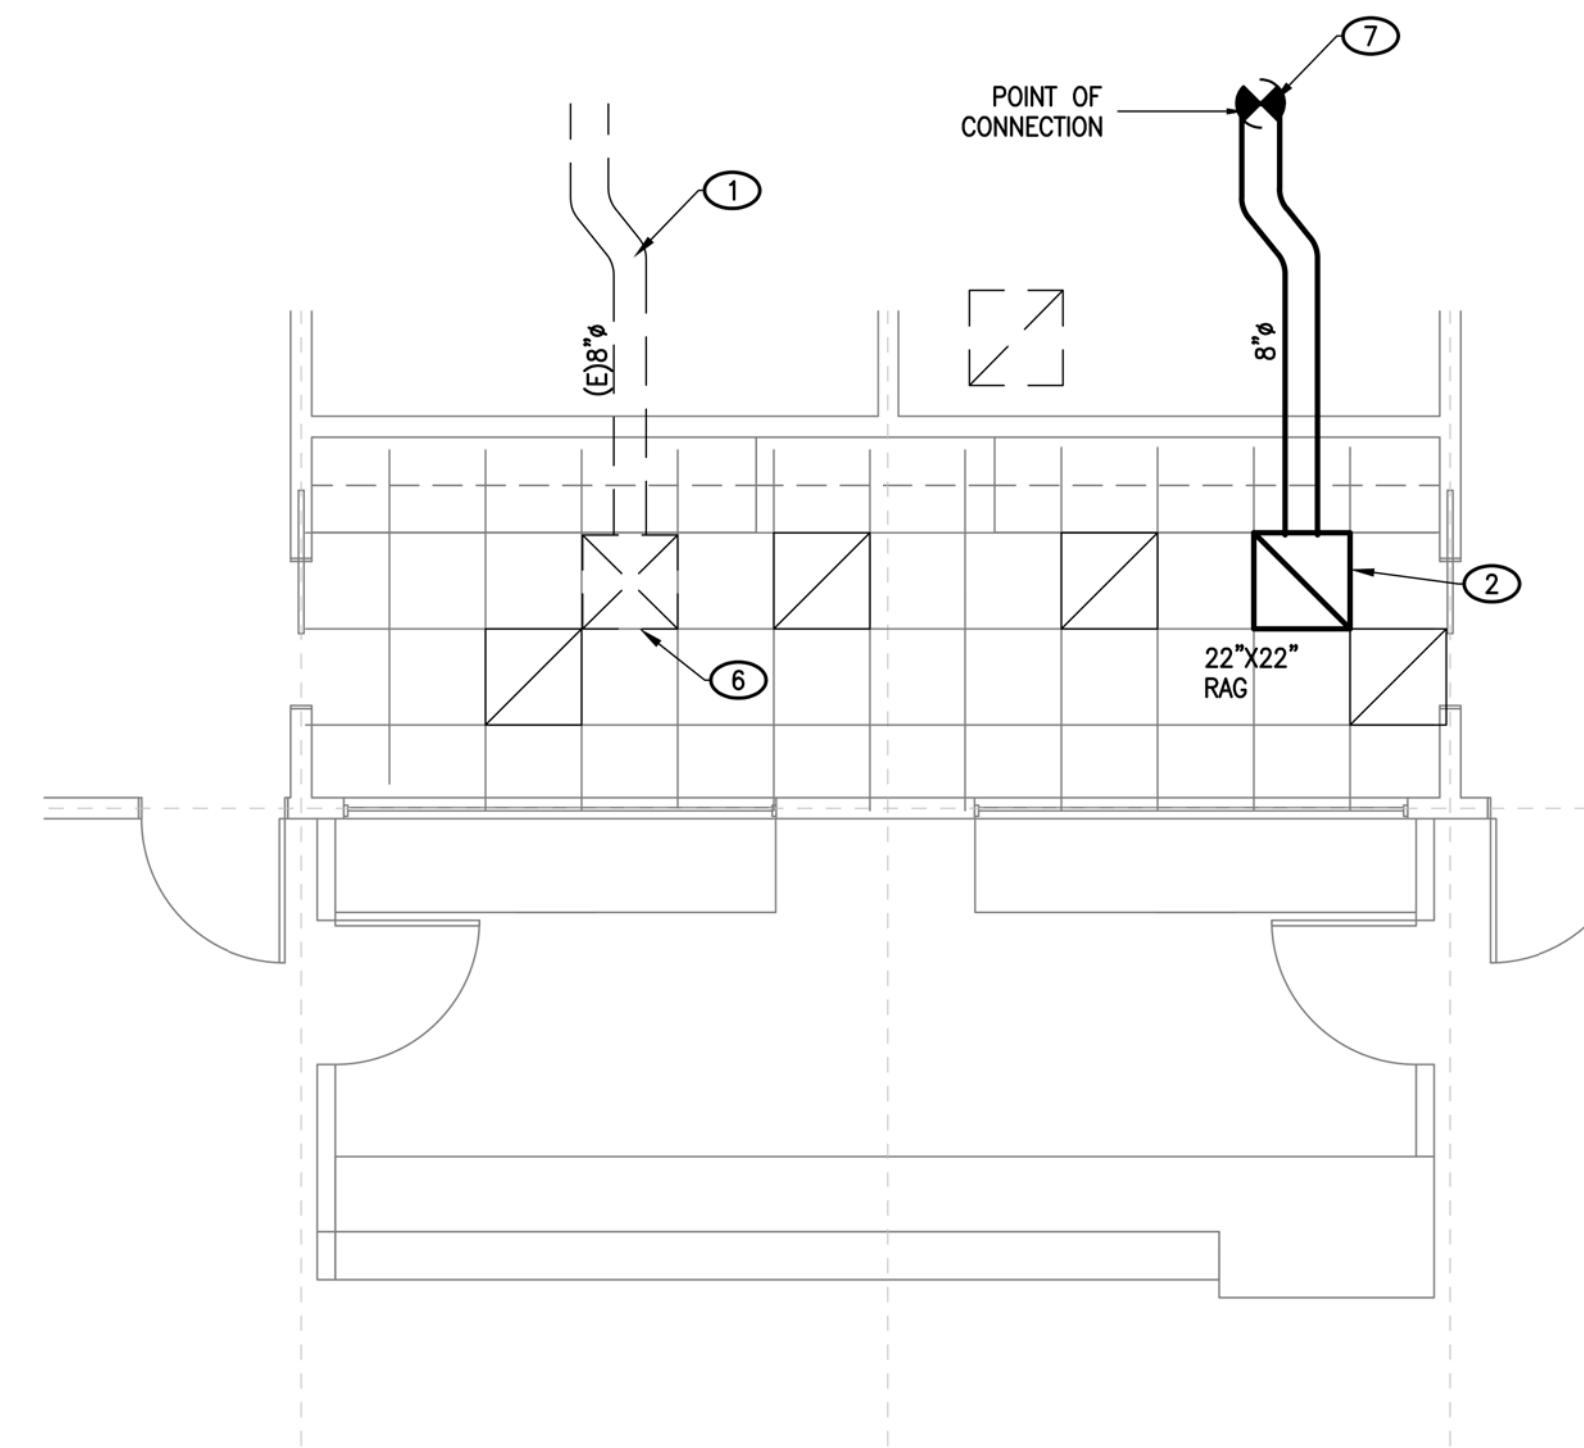

3 - PARTIAL MECHANICAL PLAN

SCALE: 1/4" = 1'-0"

ROOMS 4 & 5 - RECEPTION/OFFICE

CANTELM ENGINEERING
MECHANICAL/ELECTRICAL
2130 F STREET BAKERSFIELD, CA 93301 LICENSE #21190
TEL: (661) 524-3252 FAX: (661) 324-8439 Cantelm@Cantelm.NET

WEST SIDE FAMILY HEALTH CARE
100 EAST NORTH STREET,
TAFT, CA

DATE	ISSUED

DATE	MARK	ISSUED

DWG. BY	
CHK'D BY	F.C.
DATE	2/11/2025
JOB NO.	C24-189
FILE NO.	C24-189 MECH.DWG



EET

M3.0


SHEET

FILE: S:\PROJECTS\WEST SIDE FAMILY HEALTH CARE\24-189 PLUMB.DWG DATE: 2/11/2025 2:07 PM
REUSE OF THESE PLANS AND SPECIFICATIONS SHALL BE RESTRICTED TO THE ORIGINAL SCOPE AND PURPOSE. ANY REUSE OR MODIFICATION WITHOUT THE WRITTEN CONSENT OF THE ENGINEER SHALL BE PROHIBITED. VISUAL CONTACT WITH THESE PLANS AND SPECIFICATIONS SHALL CONSTITUTE FORMAL EVIDENCE OF THE ACCEPTANCE OF THESE RESTRICTIONS. CANTelmi ENGINEERING



OVERALL FLOOR PLAN

SCALE: 1/8" = 1'-0"

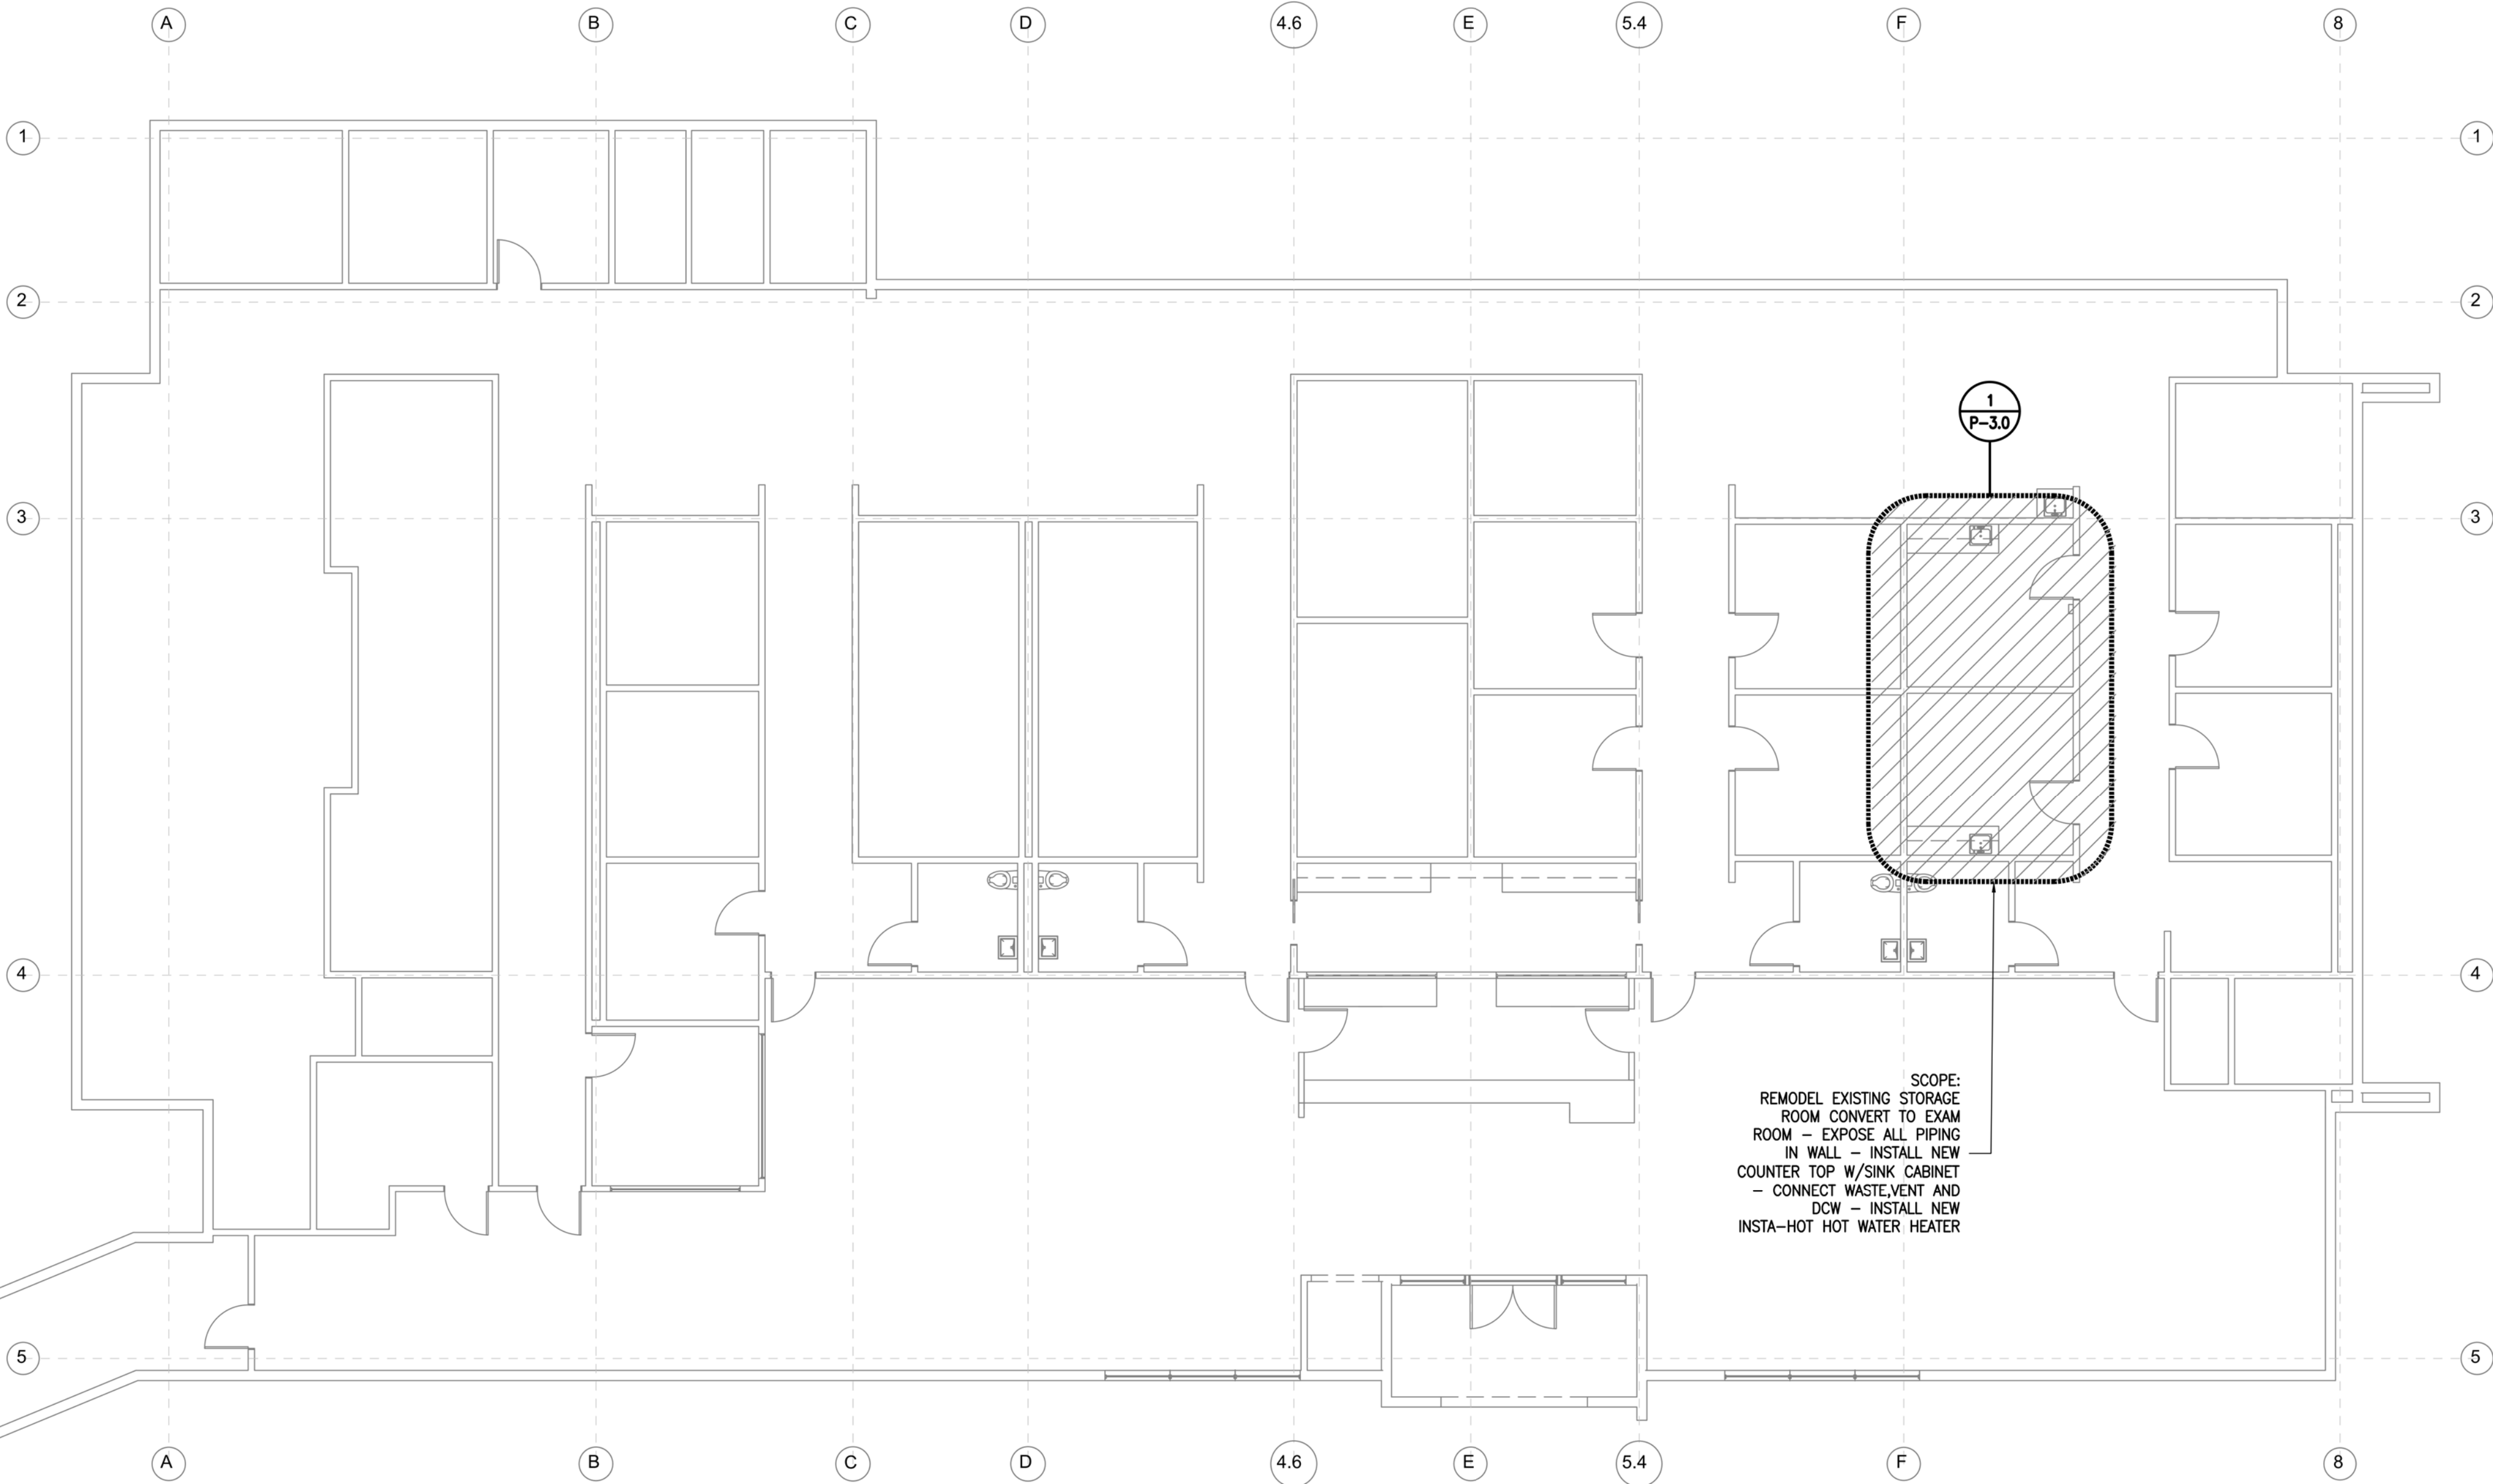

CANTELMI ENGINEERING
MECHANICAL/ELECTRICAL
LICENSE #21180
2130 F STREET BAKERSFIELD, CA 93301
TEL: (661) 324-3252 FAX: (661) 324-8439 cantelmi@cantelmi.net

WEST SIDE FAMILY HEALTH CARE
100 EAST NORTH STREET,
TAKT, CA

DATE	ISSUED

DATE	MARK	ISSUED

DWG. BY	
CHKD BY	F.C.
DATE	2/11/2025
JOB NO.	C24-189
FILE NO.	C24-189 PLUMB.DWG



SHEET
P2.0
SHEET

NOTHING IN THE DRAWINGS AND/OR SPECIFICATIONS SHALL BE CONSTRUED TO PERMIT AN INSTALLATION IN VIOLATION OF APPLICABLE CODES AND/OR RESTRICTIONS. SHOULD ANY CHANGE IN THE DRAWINGS AND/OR SPECIFICATIONS BE NECESSARY IN ORDER TO COMPLY WITH APPLICABLE CODES AND/OR REQUIREMENTS, THE CONTRACTOR SHALL NOTIFY ENGINEER OF RECORD. THE WORK PERFORMED UNDER THIS CONTRACT SHALL BE IN FULL ACCORDANCE WITH THE LATEST CODES, REGULATIONS, RESTRICTIONS AND REQUIREMENTS. CONTRACTOR TO OBTAIN CLARIFICATION FROM ENGINEER OF RECORD WHERE CONFLICTS IN DRAWING OR DIMENSIONS ARISE PRIOR TO PROCEEDING WITH CONSTRUCTION.


THESE DRAWINGS AND ANY INFORMATION CONTAINED HEREIN ARE THE PROPERTY OF CANTELMI ENGINEERING. NO PART OF THESE DRAWINGS OR ANY INFORMATION CONTAINED HEREIN MAY BE REPRODUCED OR TRANSMITTED IN ANY FORM OR BY ANY MEANS, ELECTRONIC OR MECHANICAL, WITHOUT PERMISSION IN WRITING FROM CANTELMI ENGINEERING. CANTELMI ENGINEERING SHALL BE RESPONSIBLE FOR THE ACCURACY OF THE INFORMATION CONTAINED HEREIN. THE USER OF THESE DRAWINGS SHALL BE RESPONSIBLE FOR THE ACCURACY OF THE INFORMATION CONTAINED HEREIN. THE USER OF THESE DRAWINGS SHALL BE RESPONSIBLE FOR THE ACCURACY OF THE INFORMATION CONTAINED HEREIN. THE USER OF THESE DRAWINGS SHALL BE RESPONSIBLE FOR THE ACCURACY OF THE INFORMATION CONTAINED HEREIN.

PLUMBING FIXTURE SCHEDULE							
MARK	FIXTURE	DCW	DHW	S&W	TRAP	VENT	DESCRIPTION
<div>H 1</div>	INSTANT ELECTRIC HEATER	1/2"	1/2"	-	-	-	EEMAX #SP3277 SINGLE POINT ELECTRIC TANKLESS WATER HEATER - .5 GPM - OUTLET TEMPERATURE 105°-110° - BRAIDED STAINLESS STEEL FLEX CONNECTORS - 3kw - 10.8 AMPS @277v/1ø

KEYNOTES

KEYNOTES LISTED BELOW PERTAIN TO PLAN ON THIS SHEET ONLY. KEYNOTES FROM THIS LIST THAT ARE NOT KEYED SHALL BE DISREGARDED. ITEMS NOT IDENTIFIED WITH A KEYNOTE BUT DRAWN SIMILAR TO THOSE ITEMS KEYNOTED SHALL BE CONSIDERED AS THOUGH THEY ARE KEYNOTED, CONSISTANT WITH LIKE KEYNOTED ITEMS.

- 1
- EXISTING COUNTER TOP AND SINK TO REMAIN
- 2
- INSTALL NEW COUNTER TOP WITH SINK - REFER TO ARCH. PLANS FOR SCHEDULE
- 3
- INSTALL NEW WATER HEATER - INSTA-HOT 3KW
- 4
- EXPOSE ALL UTILITIES TO WALL BEHIND EXISTING SINK
- 5
- CONNECT 2"WASTE, 2"VENT OFFSET TO NEW SINK
- 6
- CONNECT 1/2"DCW TO NEW SINK

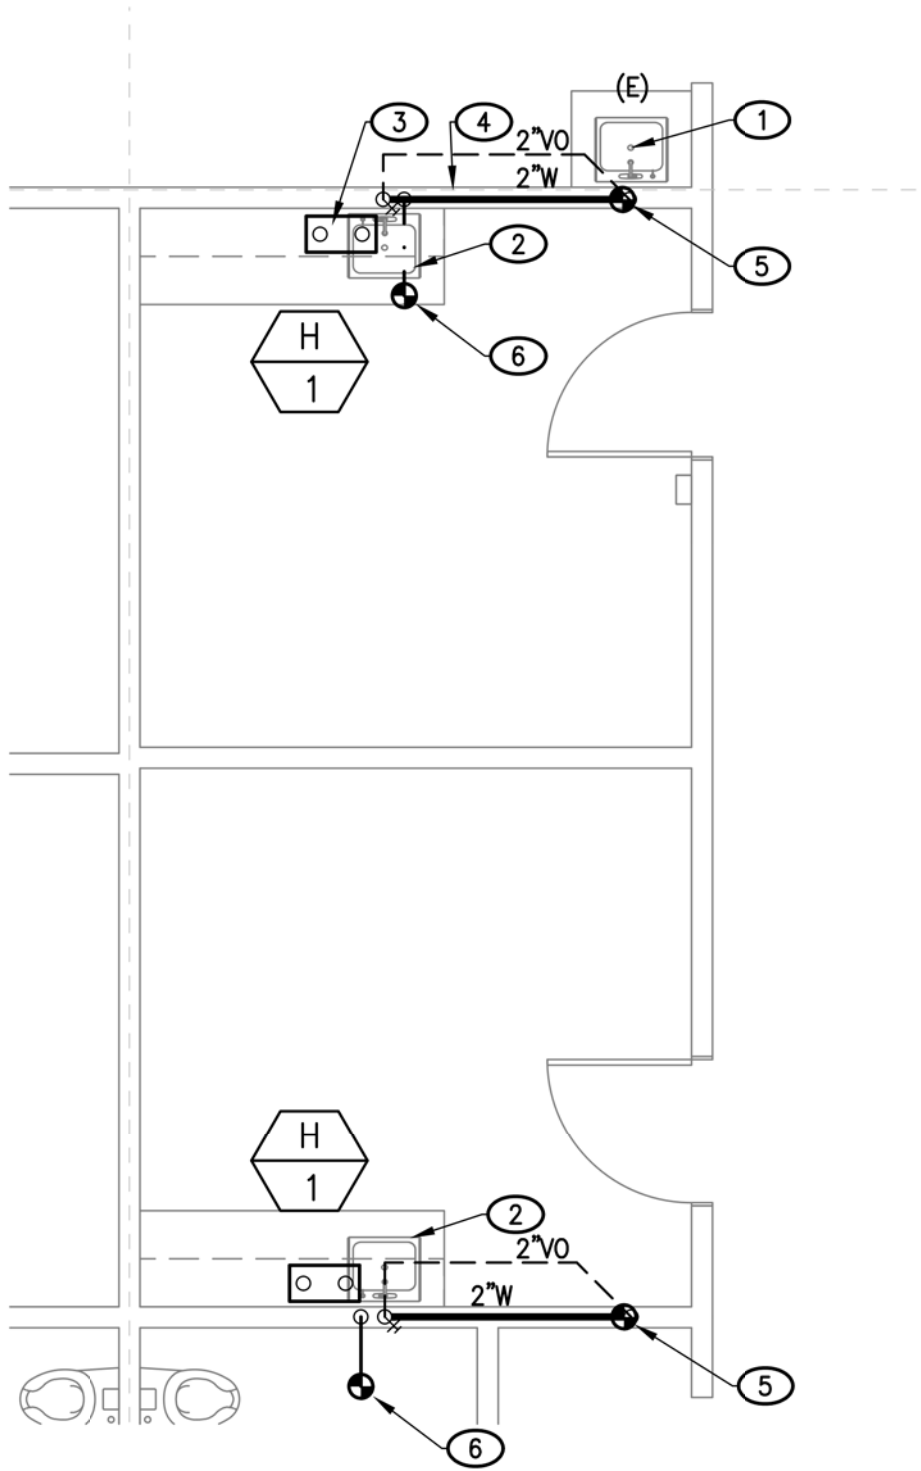

1 - PARTIAL PLUMBING PLAN
ROOM 2 & 3 - EXAM ROOMS

SCALE: 1/4" = 1'-0"

CANTELMI ENGINEERING
MECHANICAL/ELECTRICAL
2130 F STREET BAKERSFIELD, CA 93301
TEL: (661) 324-3252 FAX: (661) 324-8439 cantelmi@cantelmi.net

WEST SIDE FAMILY HEALTH CARE
100 EAST NORTH STREET,
TAMPA, FL 33602


DATE	ISSUED


DATE	MARK	ISSUED

DWG. BY	
CHKD BY	F.C.
DATE	2/11/2025
JOB NO.	C24-189
FILE NO.	C24-189 PLUMB.DWG



SHEET
P3.0
SHEET

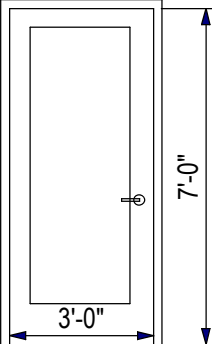DOOR SCHEDULE - ADDENDUM 1							
ELEVATION	NUMBER	QTY	SIZE	MATERIAL	FINISH	DESCRIPTION	FRAME
	DA1	2	3070	Wood	Stain	(N) S.C. Hinged Door, Temp. Glass	Hollow Metal, Enamel Finish

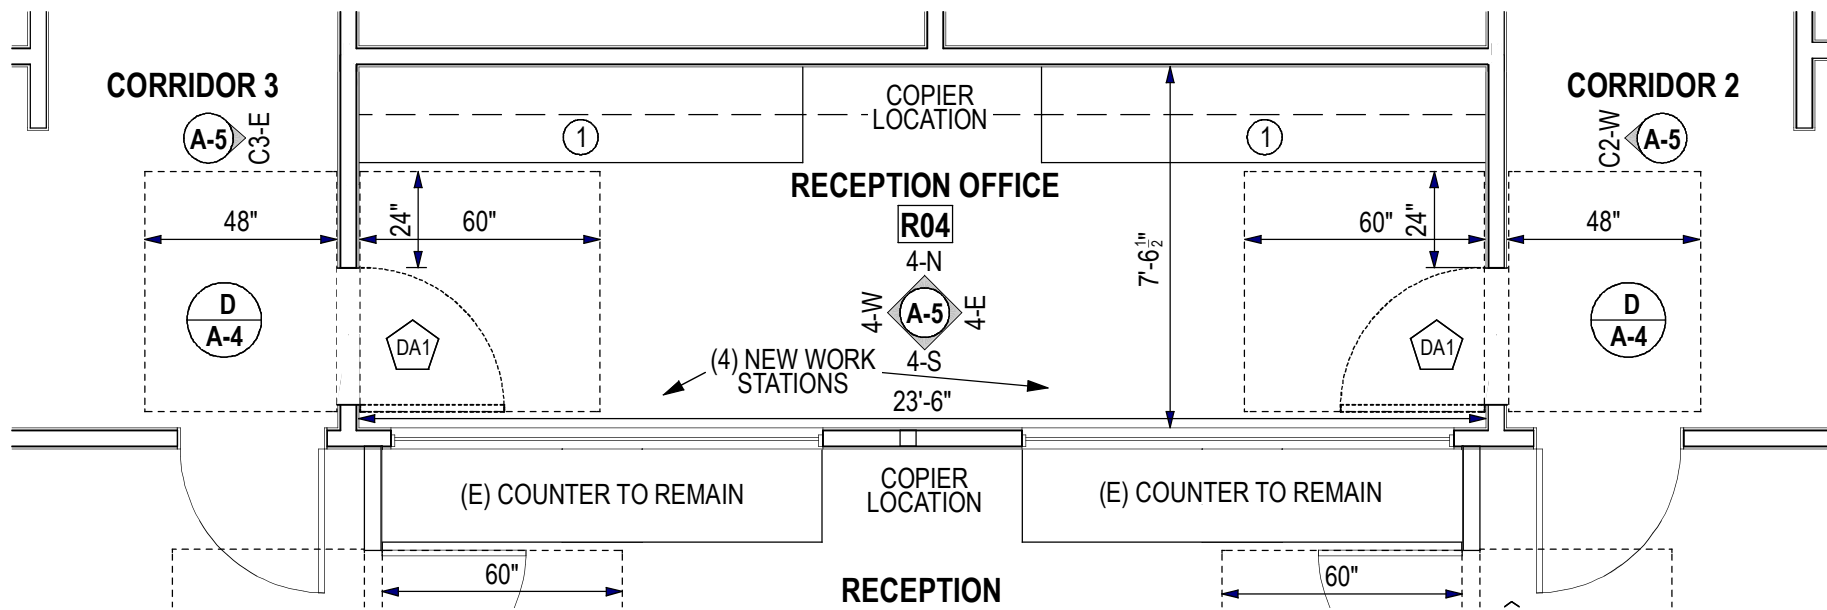

ADDENDUM 1 - RECEPTION OFFICE DOOR OPTION


PROJECT ADDRESS:

Westside Health Care District
100 E. North Street
Taft, CA. 93268

PROJECT CONTACT:

Ryan Shultz, MSHCA
Executive Director

(661) 765-7234 Office
(661) 203-5757 Cell
rshultz@wshcd.org

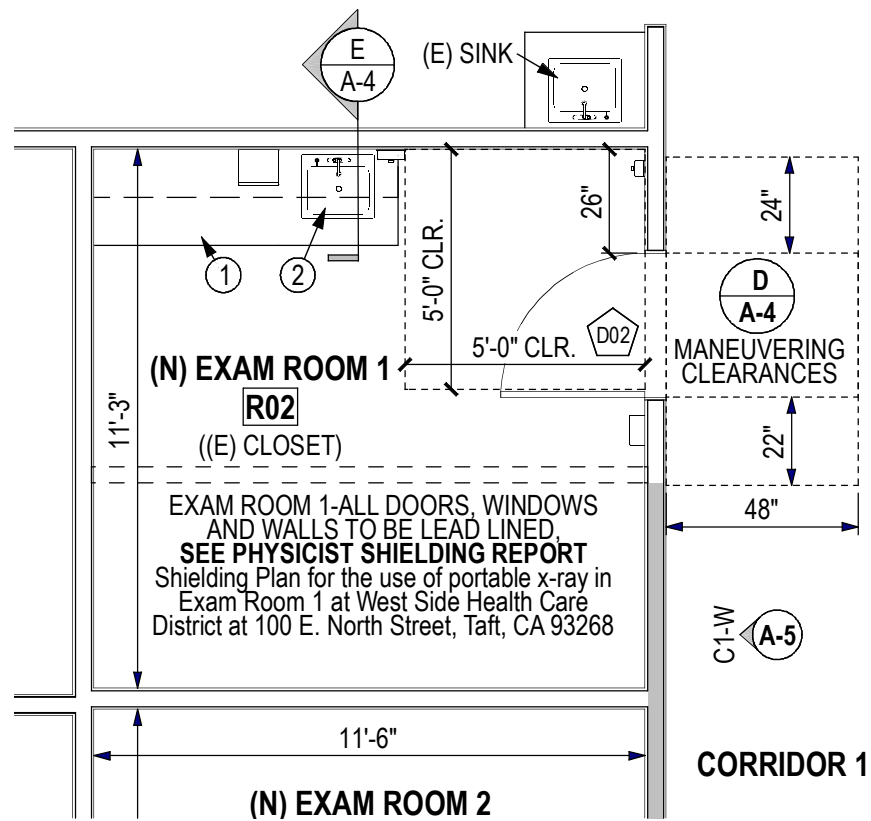

ADDENDUM 2 - EXAM ROOM 1 TO BE LEAD LINED

PROJECT ADDRESS:

Westside Health Care District
 100 E. North Street
 Taft, CA. 93268

PROJECT CONTACT:

Ryan Shultz, MSHCA
Executive Director

(661) 765-7234 Office
 (661) 203-5757 Cell
 rshultz@wshcd.org



Quality Assurance Services, Inc.

"Quality Is Never An Accident"

May 15, 2025

Attention: Mr. Ryan Shultz

RE: Shielding Plan for the use of portable x-ray in Exam Room 1 at West Side Health Care District at 100 E. North Street, Taft, CA 93268

The recommendations for radiation shielding contained in this Shielding Plan have been made in accordance with the guidance provided in NCRP Reports #49 and #147 and all State requirements.

Recommendations for the facility were made from information supplied by your offices and/or those of your architects or construction contractors.

DESIGN INFORMATION, DEFINITIONS, AND ASSUMPTIONS:

1. Workload (W): The Workload (W) factor is supplied by the customer, is commercial data, or is assumed to be a common value for the specified use such as may be obtained from Dosimetry Impact 2004 data for CT or from tables of typical radiographic and fluoroscopic procedure rooms in NCRP-147, and is used in conjunction with shielding factors and equations provided in NCRP-147.
2. Occupancy (T): The occupancy (T) factor indicates the fraction of time of exposure at a specific location. Controlled areas are assigned the Occupancy factor of one (1). NCRP Report No. 49, Appendix C, Table 1, and NCRP Report No. 147, Table 4.1 are generally followed to determine appropriate occupancy factors.

1500 Via Hacienda
D&B 845992374
glenn.qas@gmail.com

Chula Vista, CA 91913

(619) 482-1003
(619) 421-7670 Fax
www.qaservices.net

3. Weekly Exposure Limit (P): The Weekly Exposure Limit (P) is 2 mrem per week for non-radiation workers and is 10 mrem per week for occupational radiation workers.
4. KiloVoltage Potential (kVp): The KiloVoltage Potential (kVp) is assumed to be an average of 120 kVp for scattered X-rays.
5. Distance (d): The Distance (d) used in shielding calculations is the distance from the scattering object or from the source of the primary beam to the position of occupancy.
6. Walls: The walls of the rooms, unless otherwise noted, are assumed to consist of two 5/8" layers of sheetrock with 3" between the layers which provide insignificant attenuation and do not enter into the calculations.
7. Doors: The standard doors of the rooms are assumed to be solid core doors which provide insignificant attenuation and do not enter into the calculations.
8. Windows: The standard windows of the rooms are assumed to provide insignificant attenuation and do not enter into the calculations.
9. Floor/Ceiling: The Floor and Ceiling occupancies must be specified. When not specified otherwise, a floor-to-floor height of 14 feet is assumed.
10. Height of Shielding for Xray: The height of shielding for xray attenuation must be 84 inches (or more if specified) pursuant to California Code of Regulations, Title 17.
11. Primary Barrier: The primary barrier has a design safety margin of 12 inches (approximately 0.5 meter).
12. Half-Value-Layer (HVL): Values for xray attenuation are taken from NCRP Report No. 49, Appendix C, Table 27, page 88, for specified values of kVp. This report assumes 120 kVp is a typical value resulting in a HVL of 0.286 mm of lead or 1.95 cm of standard concrete.

13. Shielding Value Minimum: The attached excel spreadsheet provides the minimum values of shielding for lead and are given in millimeters thickness or pounds per square foot area or in thickness of concrete. Larger thicknesses of shielding can be used if it is cost effective to do so.
14. Unless stated otherwise, all portions of a designated radiation barrier (i.e., doors, windows, and so forth) are to have the same attenuation characteristics as is stipulated for that given barrier. For example, where a radiation barrier is specified to contain 4-pound lead shielding, unless specified otherwise any door or window contained in that barrier must also provide an equivalent attenuation of 4-pound lead.
15. All penetrations in lead lined walls must be lined with an equivalent thickness of lead with overlapping lead edges. (No gaps in lead lining.)
16. Where existing lead barriers are to be re-used, any penetrations made in an existing lead barrier must be repaired to provide at least as much radiation protection as was afforded prior to the penetration being made.
17. Door and window frames must conform to the requirements of NCRP-49 and NCRP-147.

All “notes” provided in this report and also all “notes” on the calculation spreadsheet(s) must be taken into consideration.

The assumptions indicated on the calculation spreadsheet(s) are important as they directly impact the calculated lead shielding. If you disagree with or wish to modify any of the indicated assumptions, notify the physicist. It is important to note that any assumptions used in determining the proper amount of shielding to be provided can be challenged and justification can be requested by the regulatory bodies. Therefore, it is prudent to be careful in requesting changes or modifications to any of the “standard” assumptions normally used by physicists.


CERTIFICATION: Based on my assumptions and calculations, I declare under penalty of perjury, that the radiation protection design for this project will conform to the applicable provisions of the State Regulations relating to radiation protections.

Any changes or modifications to any room configuration or to any of the specified equipment will require a review and/or modification of the shielding requirements by a qualified medical physicist.

My responsibility is for the design of the shielding as described above and is not for the installation of the shielding. Although not intended as an endorsement, should consultation regarding the installation of the specified lead shielding be desired, RAY-BAR Engineering Corporation, located in Azusa, CA, may be contacted at (626) 969-1818 for such assistance (Ask for Vince).

I further declare that I am a qualified radiation physicist, health physicist and medical physicist.

Sincerely,

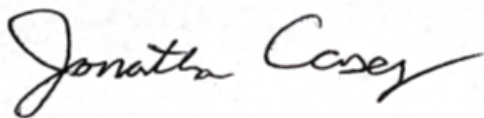

Jonathan Casey, MS, DABR

Approved and Reviewed by:



Glenn Deacon, MSEE, MS, DABR
Electrical Engineer and Diagnostic Medical Physicist
President

5/15/2025


Facility: West Side Health Care District
 Location: 100 E. North Street, Taft, CA 93268
 Project: Exam Room 1 for Portable X-Ray Use
 Number of patients per 40-hour week: 100

P Primary Beam
 S Scatter Radiation



Barrier	Description of Barrier	P or S	Design Goal (P) NCRP-147 (mGy/wk)	Occupancy Factor (T) NCRP-147 Table 4.1	Distance To Barrier From Source (m)	NT/Pd ² (mGy ⁻¹ m ⁻²)	Required Lead (lbs/ft ²)	Comments
A	Staff Work Area	S	0.02	1.000	2.03	1212	4.0	
B	Hall Door	S	0.02	0.125	2.16	133	2.0	
C	Hallway	S	0.02	0.200	2.10	227	2.0	
D	Exam Room	S	0.02	0.500	2.03	606	2.0	
E	Exam Room	P	0.02	0.500	1.50	1114	4.0	Chest Bucky
F	Ceiling-Nothing Above	S	0.02	0.000	3.41	0	0.0	Note 1
G	Floor-On Grade	P	0.02	0.000	1.00	0	0.0	Note 1

Note 1: The common construction materials comprising this barrier provide sufficient attenuation.

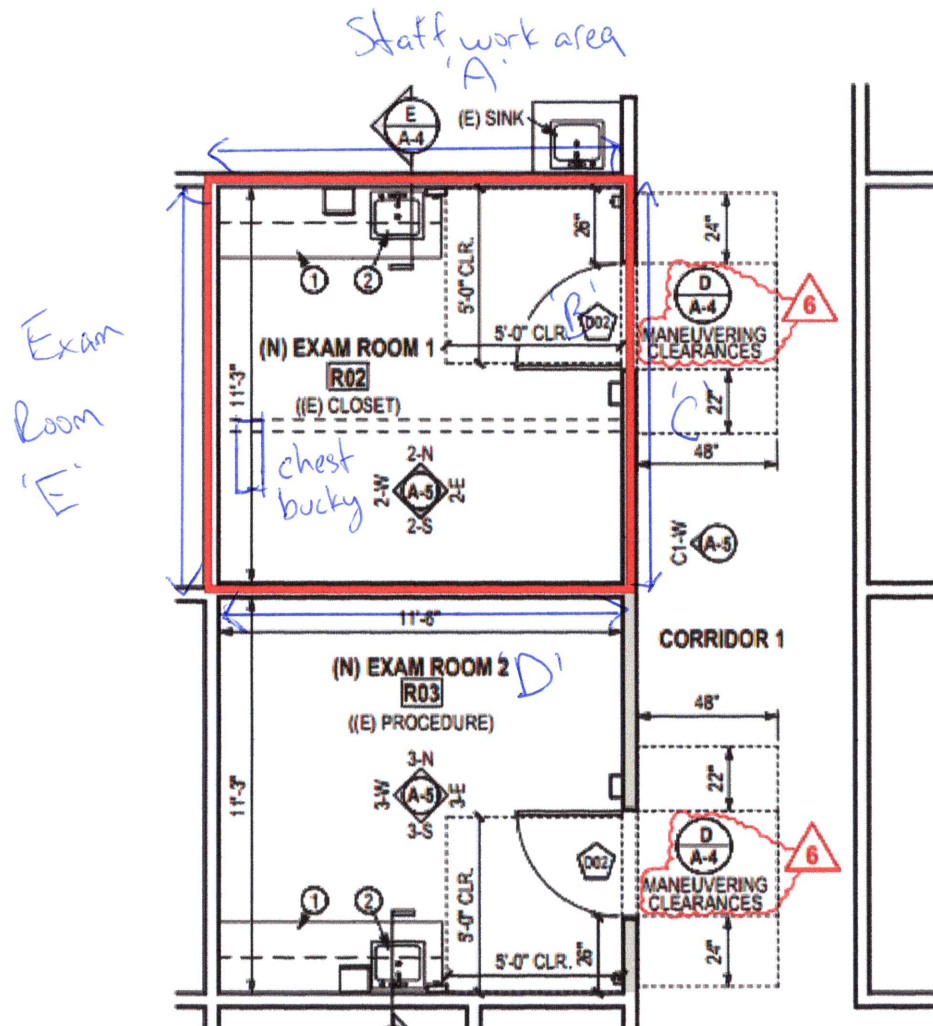

ROOMS 2 & 3 - EXAM
CONVERT CLOSET AND
PROCEDURE TO (2) EXAM ROOM